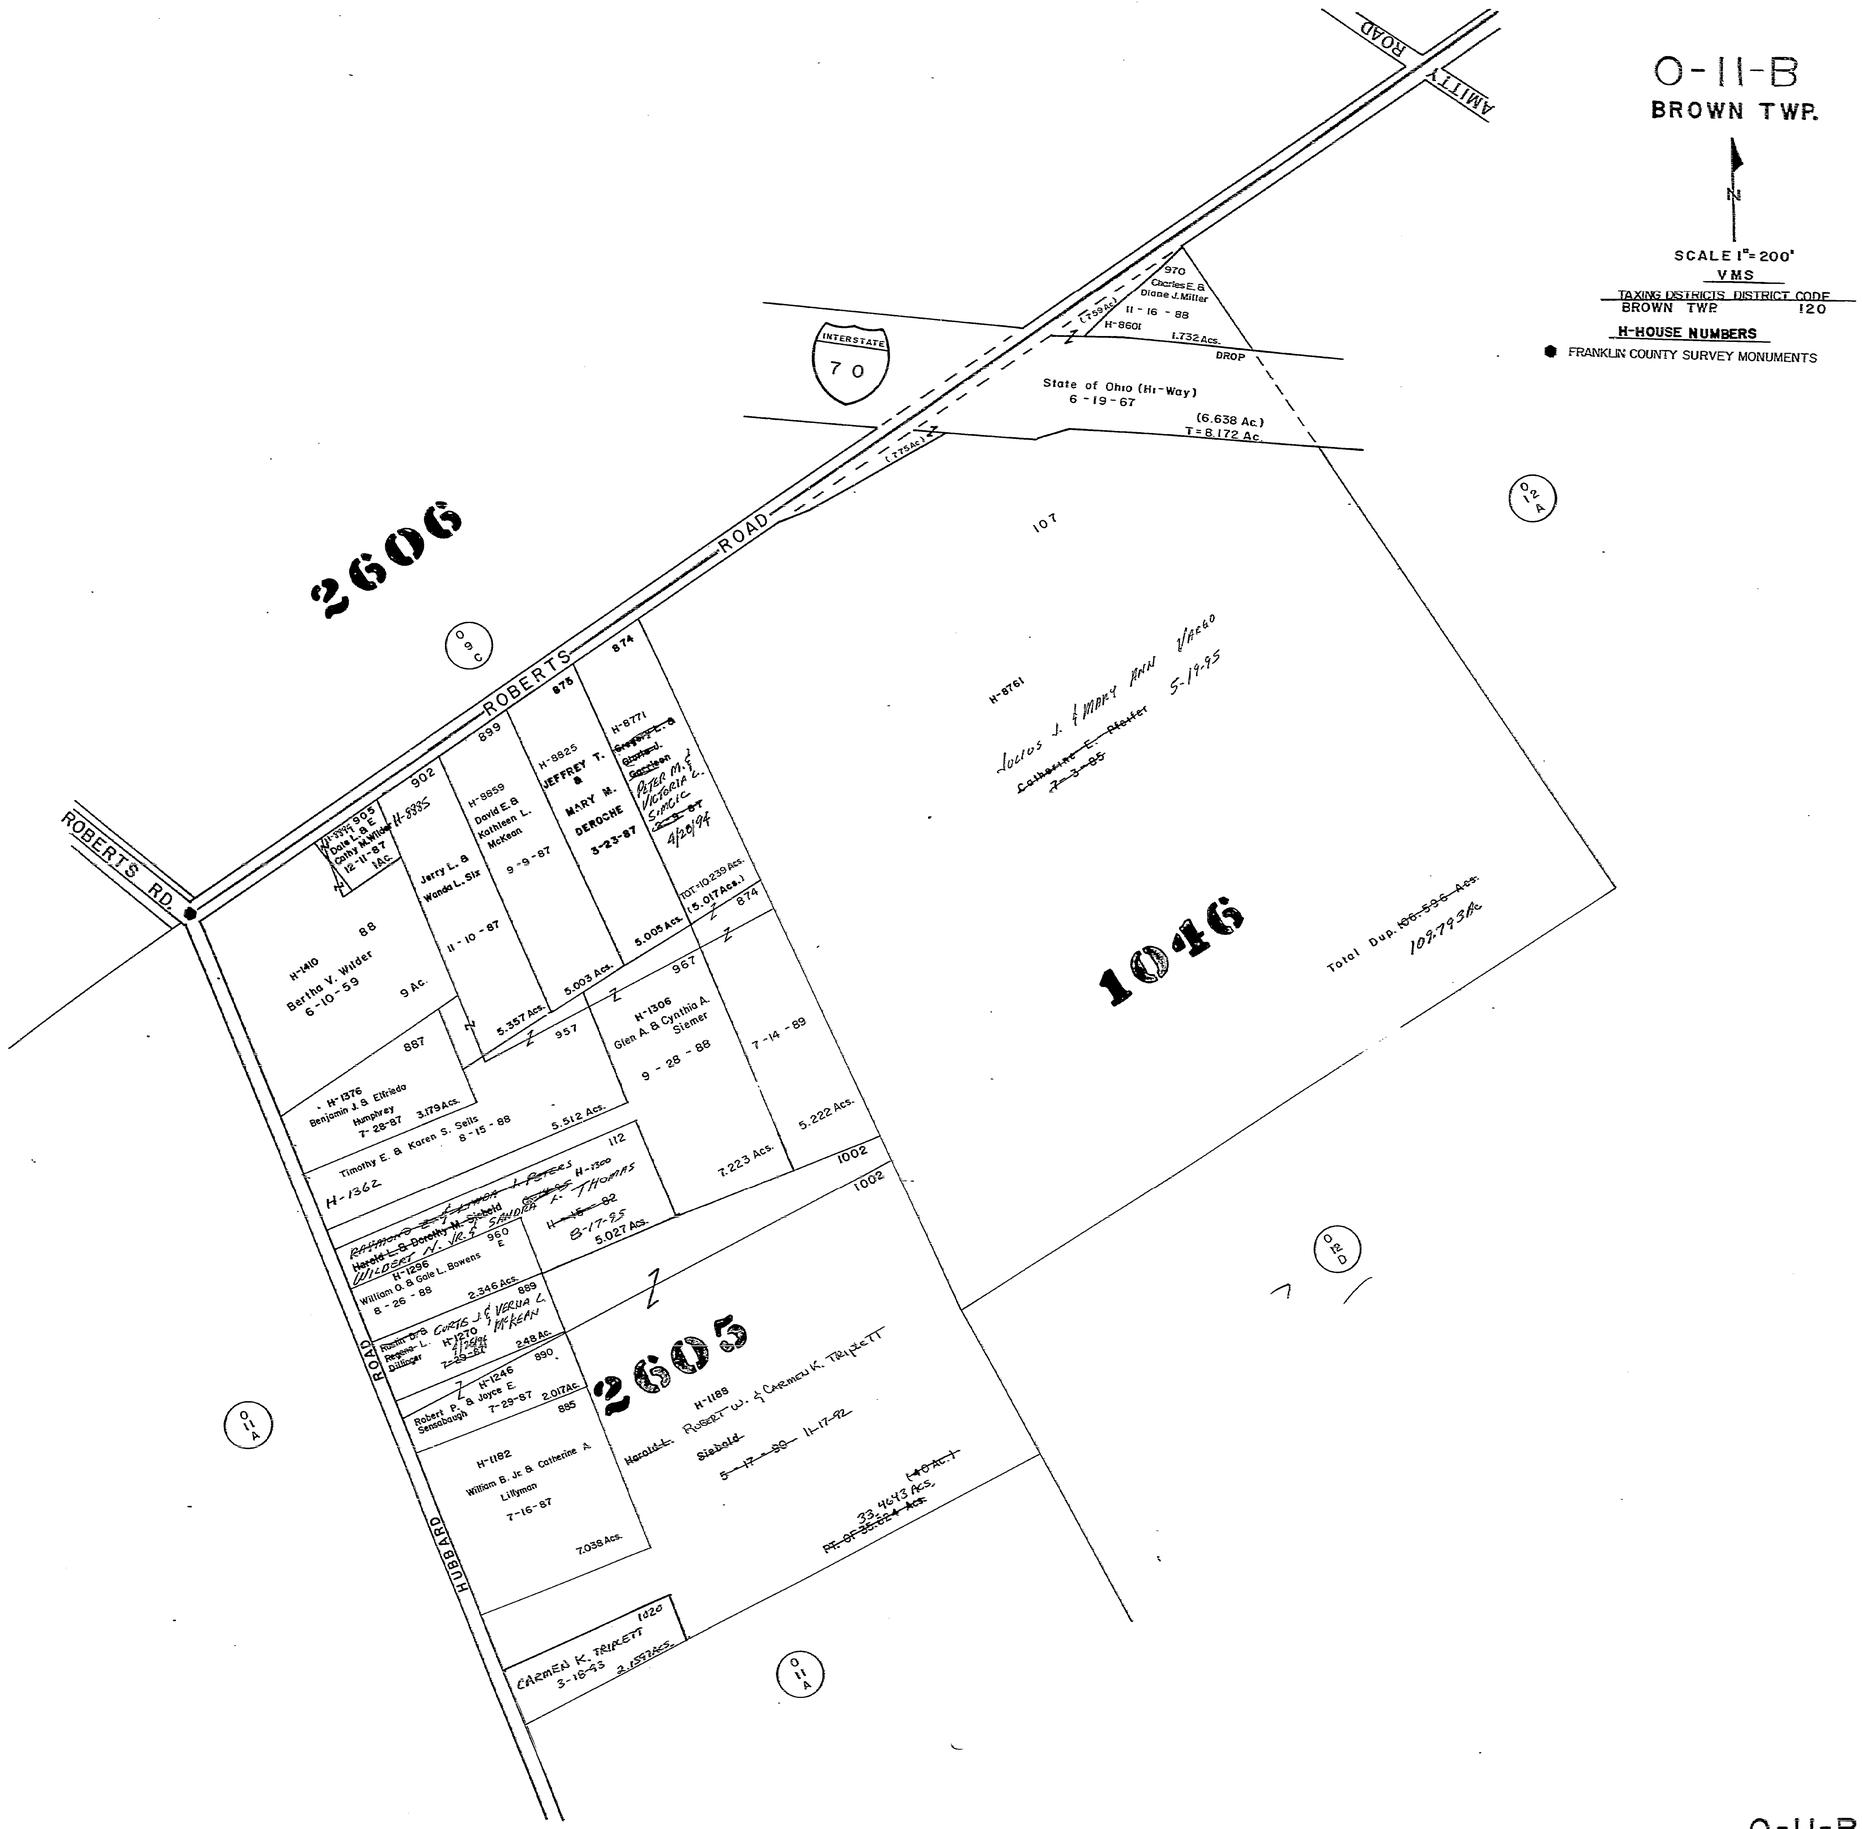
O-11-B
BROWN TWP.
N
SCALE 1" = 200'
VMS
TAXING DISTRICTS DISTRICT CODE
BROWN TWP. 120
H-HOUSE NUMBERS
FRANKLIN COUNTY SURVEY MONUMENTS
AMITY ROAD
INTERSTATE 70
ROBERTS ROAD
ROBERTS RD.
HUBBARD ROAD
2606
1046
2605
970
Charles E. & Diane J. Miller
11-16-88
H-8601
1.732 Acs.
DROP
State of Ohio (Hi-Way)
6-19-67
(6.638 Ac.)
T=8.172 Ac.
107
H-8761
Total Dup. 109.7930 Ac.
902
H-8835
Jerry L. & Wanda L. Sitz
11-10-87
5.357 Acs.
899
H-8959
David E. & Kathleen L. McKeen
9-9-87
5.003 Acs.
875
H-8825
JEFFREY T. & MARY M. DEROCHE
3-23-87
5.005 Acs.
874
H-8771
TOT: 10.239 Acs. (5.017 Acs.)
88
H-1410
Bertha V. Wilder
6-10-59
9 Ac.
867
H-1376
Benjamin J. & Elfriedo Humphrey
7-28-87
3.179 Acs.
957
967
H-1306
Glen A. & Cynthia A. Siemer
9-28-88
7.223 Acs.
7-14-89
5.222 Acs.
5.512 Acs.
112
H-1362
1002
1002
H-1300
F. THOMAS
8-17-85
5.027 Acs.
960 E
H-1296
William O. & Gale L. Bowens
8-26-88
2.346 Acs.
889
H-1210
7-29-87
2.48 Ac.
890
H-1246
Robert P. & Joyce E. Sensabaugh
7-29-87
2.017 Ac.
885
H-1182
William B. Jr. & Catherine A. Lillyman
7-16-87
7.038 Acs.
H-1189
Siebold
11-17-92
33.4643 Acs.
1020
CARMEN K. TRIPLETT
3-18-93
2.157 Acs.

O-11-B