0-14-F

CLINTON TWP.
R. 18 TWP. 1

N

SCALE 1" = 100'
E = HIGHWAY EASEMENT

TAXING DISTRICT	DISTRICT CODE
COLUMBUS	010
*CLINTON	130

H---HOUSE NUMBERS

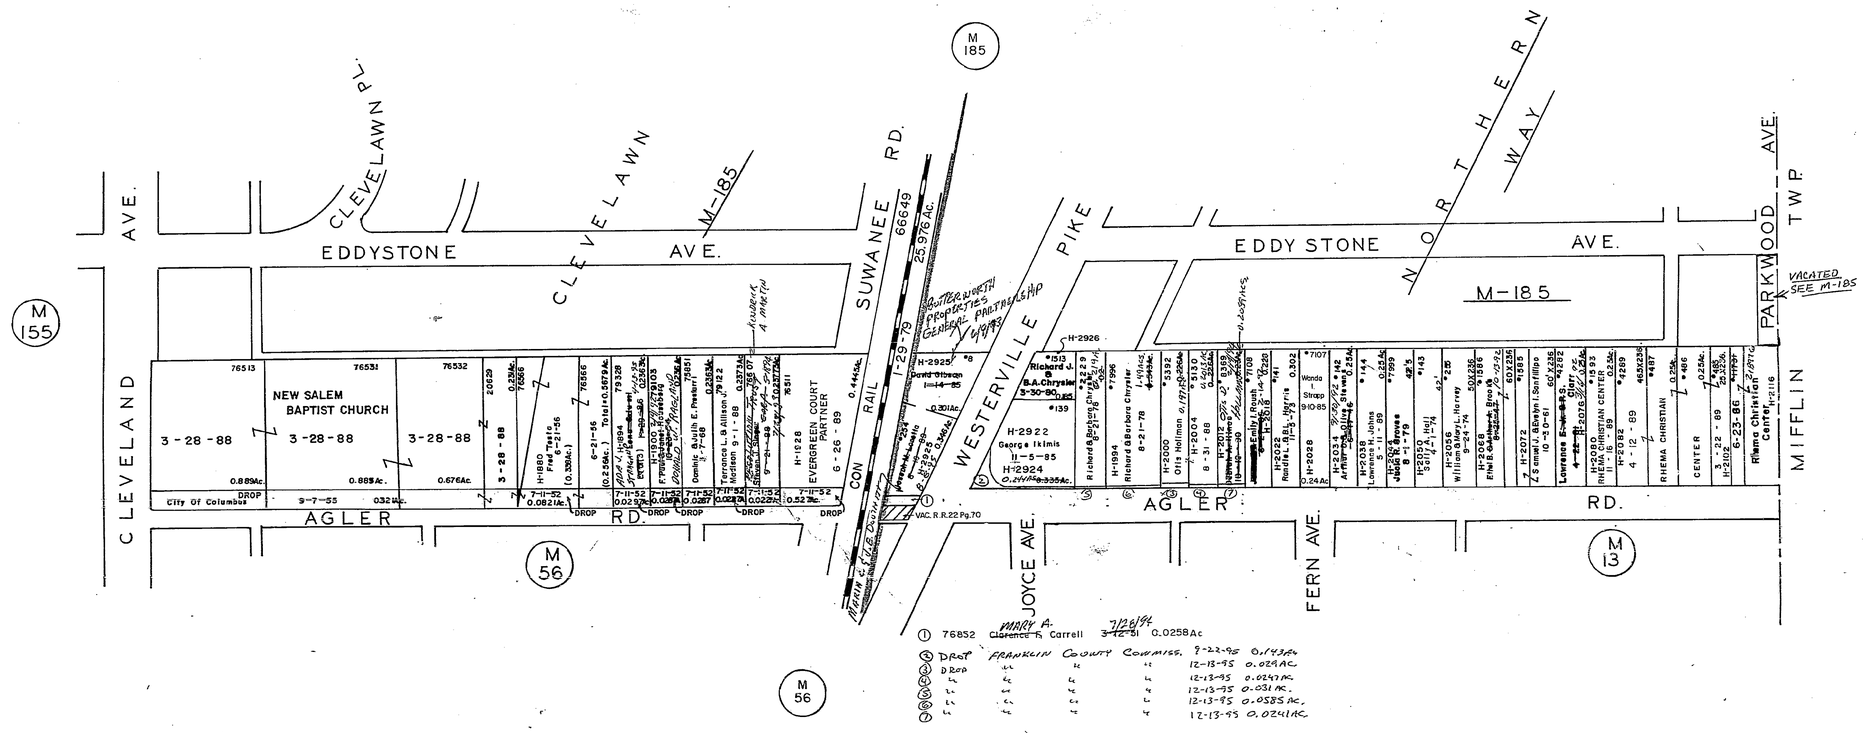

0-14-F