

0-17-F

FRANKLIN TWP.
R. 23 TWPI

SCALE 1"=200'


V.M.S.

TAXING DISTRICT - CODE

COLUMBUS OIO

H-HOUSE NUMBERS

2668

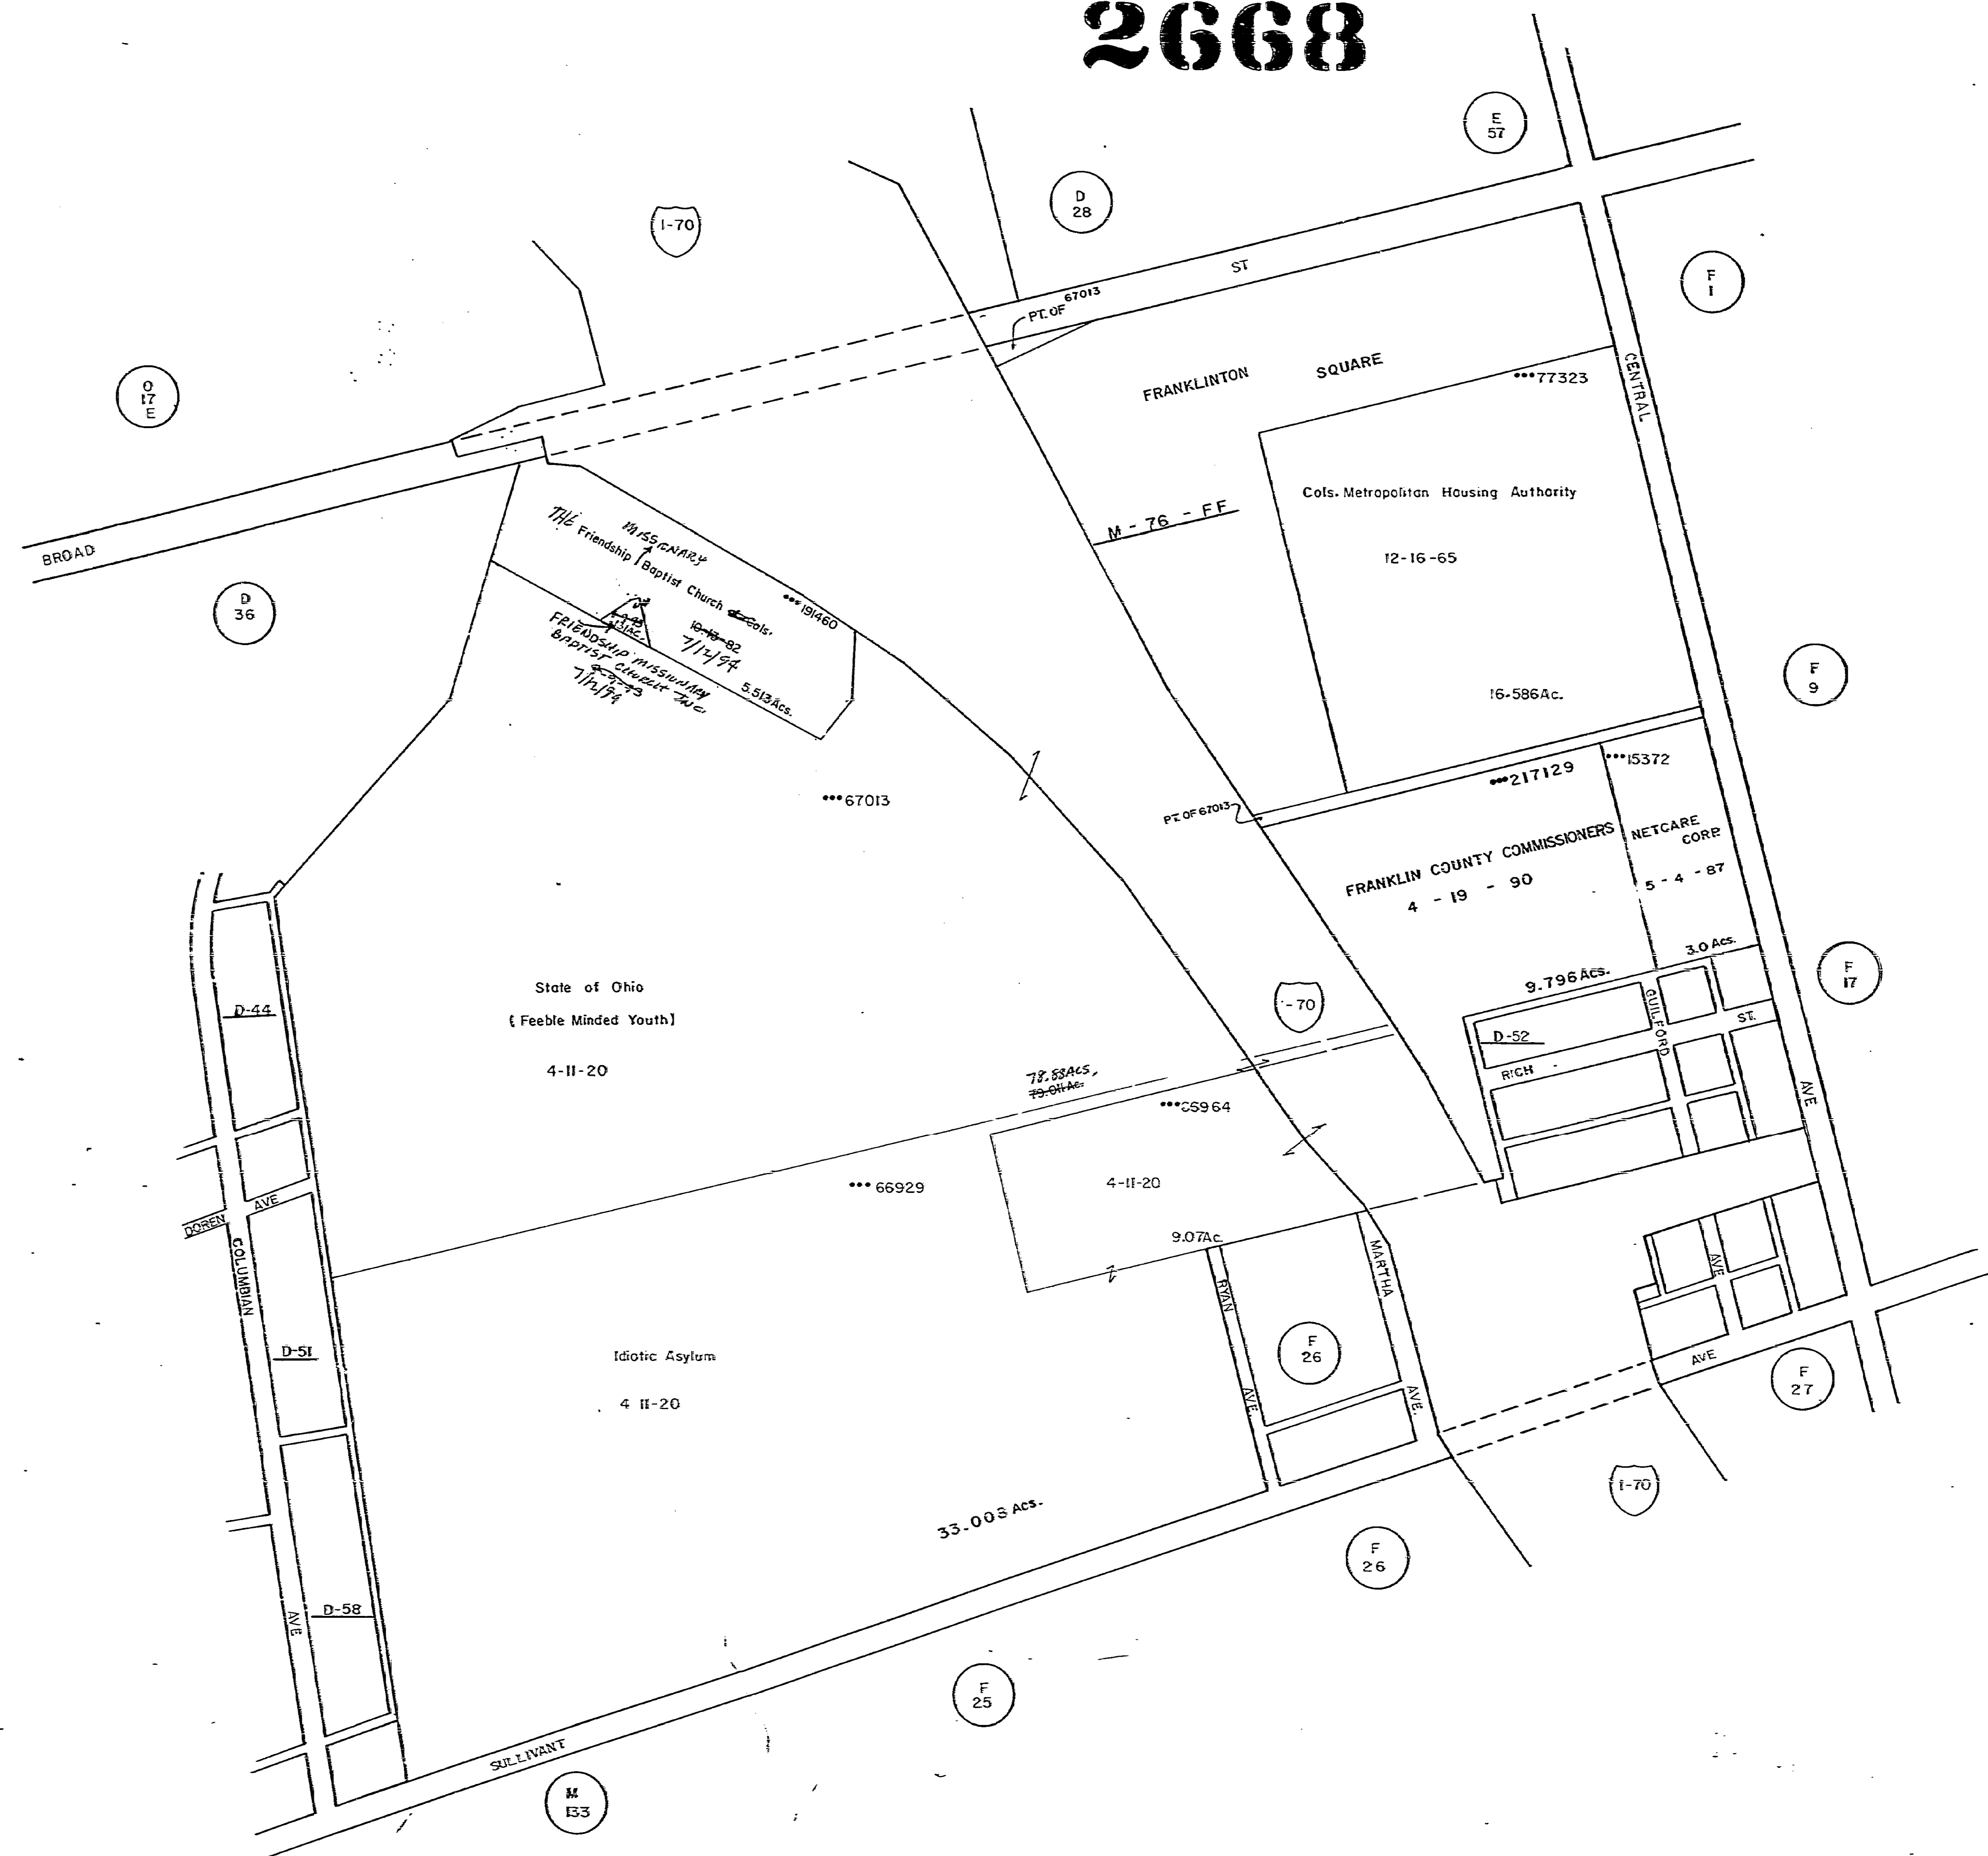

9/8/90

0-17-F