


SCALE 1" = 200'
E = HIGHWAY E.A.S.F.V.

WILLIAMS ROAD
TAXING DISTRICT DISTRICT CODE
COLUMBUS 010

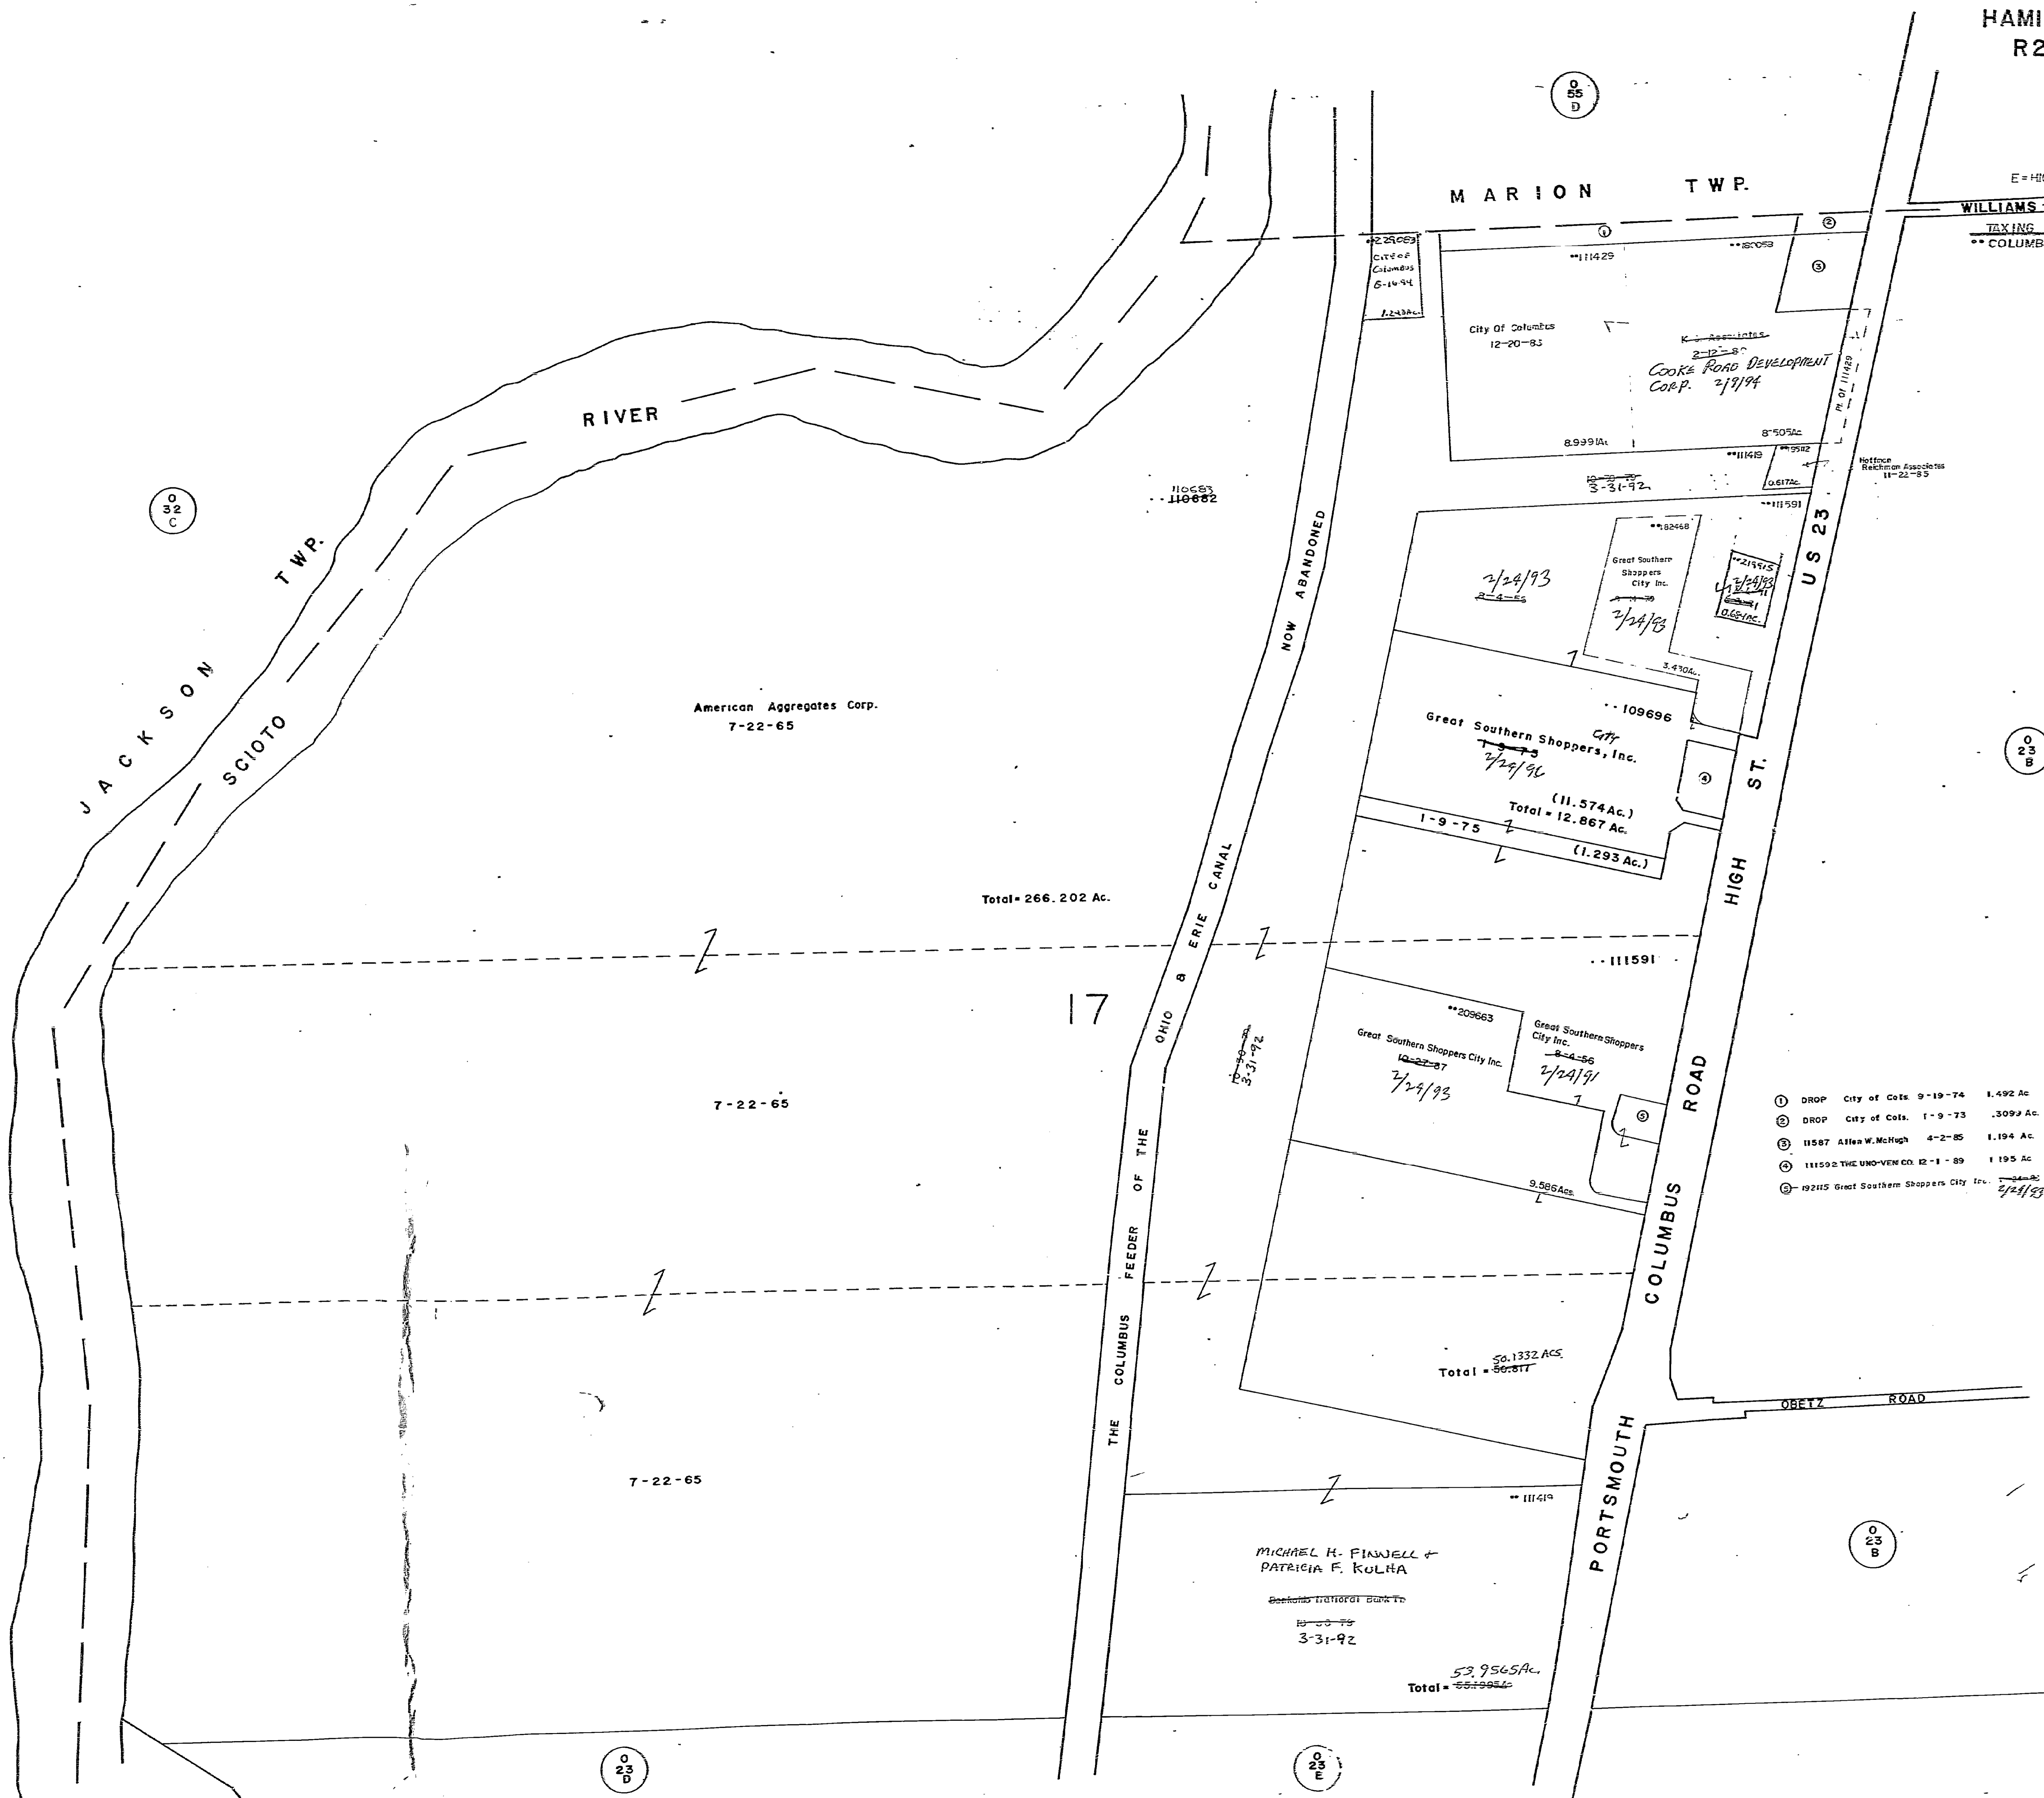

- ① DROP City of Cols. 9-19-74 1.492 Ac.
- ② DROP City of Cols. 1-9-73 .3097 Ac.
- ③ 11587 Allen W. McHugh 4-2-85 1.194 Ac.
- ④ 111592 THE UNO-VEN CO. 12-1-89 1.195 Ac.
- ⑤ 19215 Great Southern Shoppers City Inc. 2/24/93 2.40982 Ac.