


SCALE 1"=200'  
F=HIGHWAY EASEMENT

TAXING DISTRICTS	DISTRICT CODE
HAMILTON TWP.	150
COLUMBUS	010
COLUMBUS-HAMILTON	510

H--- HOUSE NUMBERS  
● FRANKLIN COUNTY SURVEY MONUMENTS

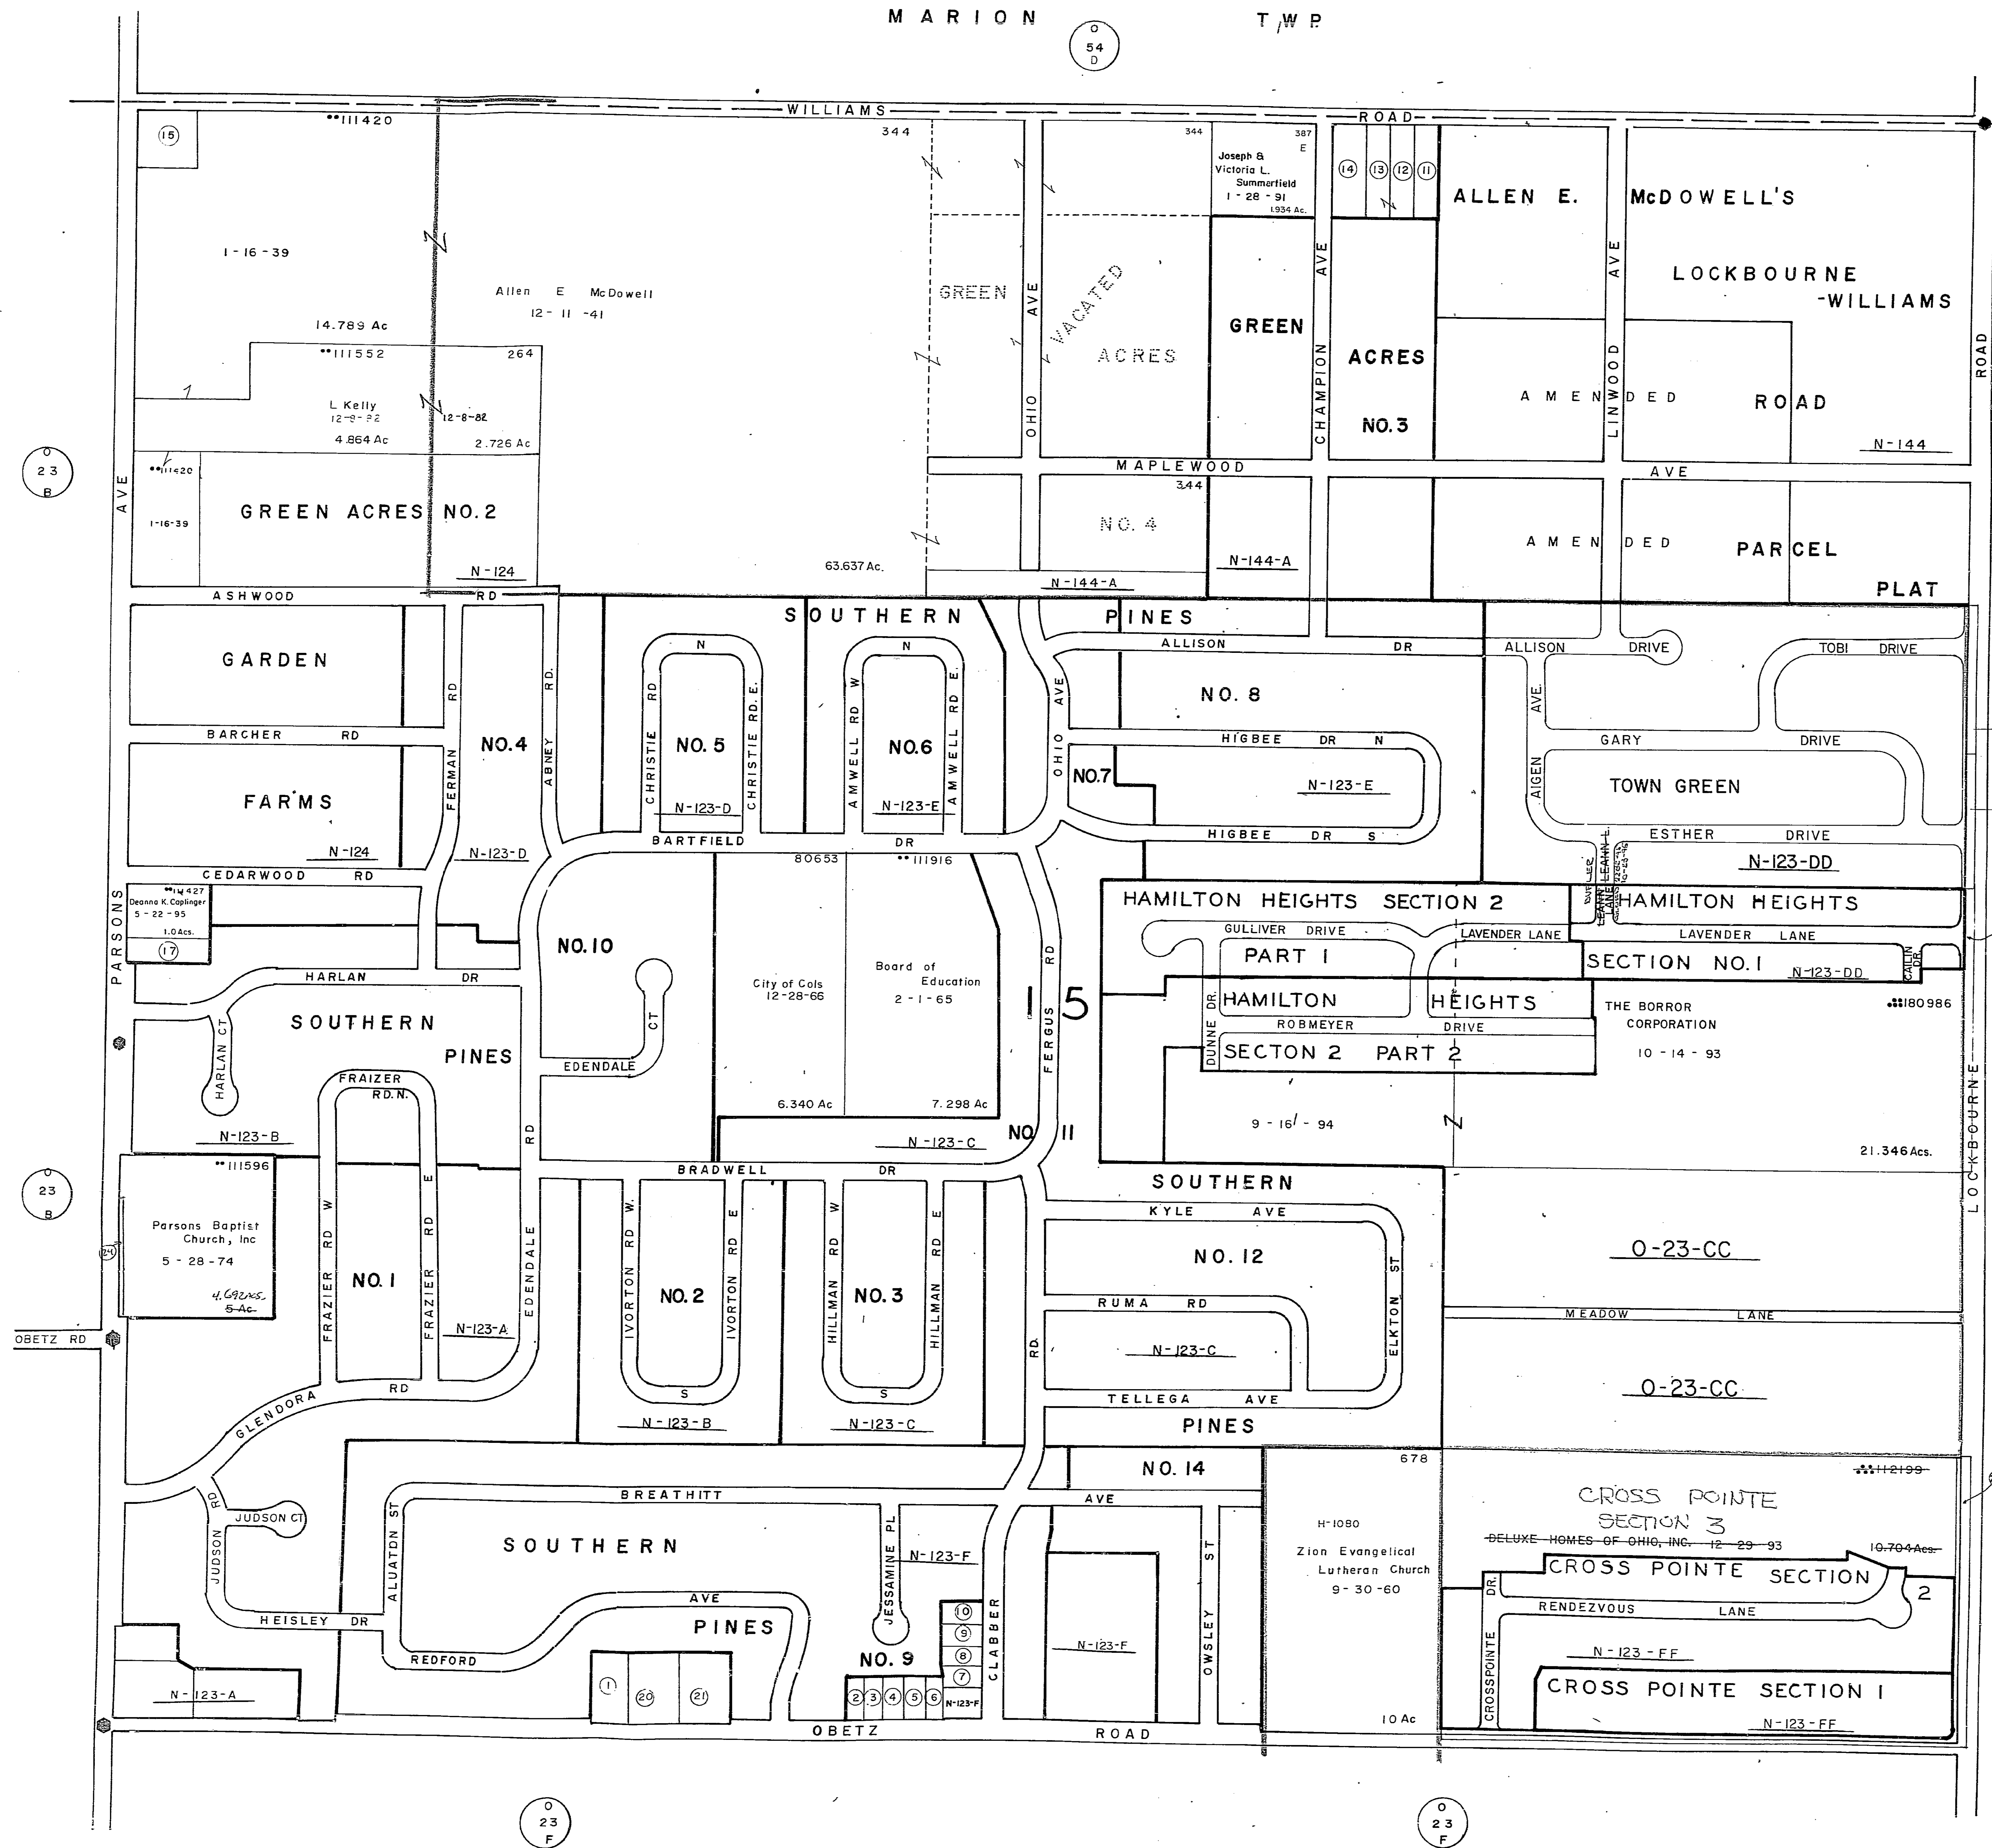

1	100779	Walter Lindemuth	7-19-93	.56 Ac
2	115630	Patricia A. Bloomfield	12-1-89	.446'
3	115631	J.E. Bobst - Jennifer Mann	4-10-93	.1586' (15-22-95)
4	114005	Merl R. & Betty M. Jackson	4-25-89	.1806'
5	114006	Myron K. & Tammy S. Hale	8-3-88	.1806'
6	114835	Mark S. & Nancy K. Urbine	7-6-88	.1586'
7	103697	SEC. OF H.U.D.	3-9-94	.166'
8	103698	SEC. OF H.U.D.	3-9-94	.166'
9	103717	Jerrold A. & Charlotte L. Roff	11-25-91	.166'
10	103723	Gregory A. & Christina J. Pratti	12-23-94	.166'
11	1009	William E. & Kathy L. Hedges	4-6-92	.445 H'1015
12	884	SEC. OF H.U.D.	8-14-93	(.445) H'1017
13				(.445) Total .890
14	1245	Sherol R. Saxton	11-4-82	.585 H'1007
15	47548	M J McDowell	9-11-64	.807'
16				
17	111547	E V & M Hys	4-2-47	.5
18	DROP	City of Columbus	4-24-79	0.293 Ac.
19	DROP	City of Columbus	4-24-78	0.272 Ac.
20	100777	Gary F. & Connie W. Sunkle	10-28-92	0.7455 Ac.
21	188841	Gary F. & Connie W. Sunkle	5-16-81	0.7445'
22	DROP	CITY OF COLUMBUS	11-8-91	0.561 Ac.
23			4-20-94	1.788'
24	DROP	CITY OF COLS.	12-9-95	0.309 Ac.

1168  
6/14/95