

0-23-E


HAMILTON TWP

R.22 TWP 4

OBETZ RD.

SCALE 1"=200'
E=HIGHWAY EASEMENT

TAXING DISTRICTS	DISTRICT CODE
HAMILTON TWP.	150
COLUMBUS-HAMILTON S.D.	510
H-HOUSE NUMBERS	
FRANKLIN COUNTY SURVEY MONUMENTS	

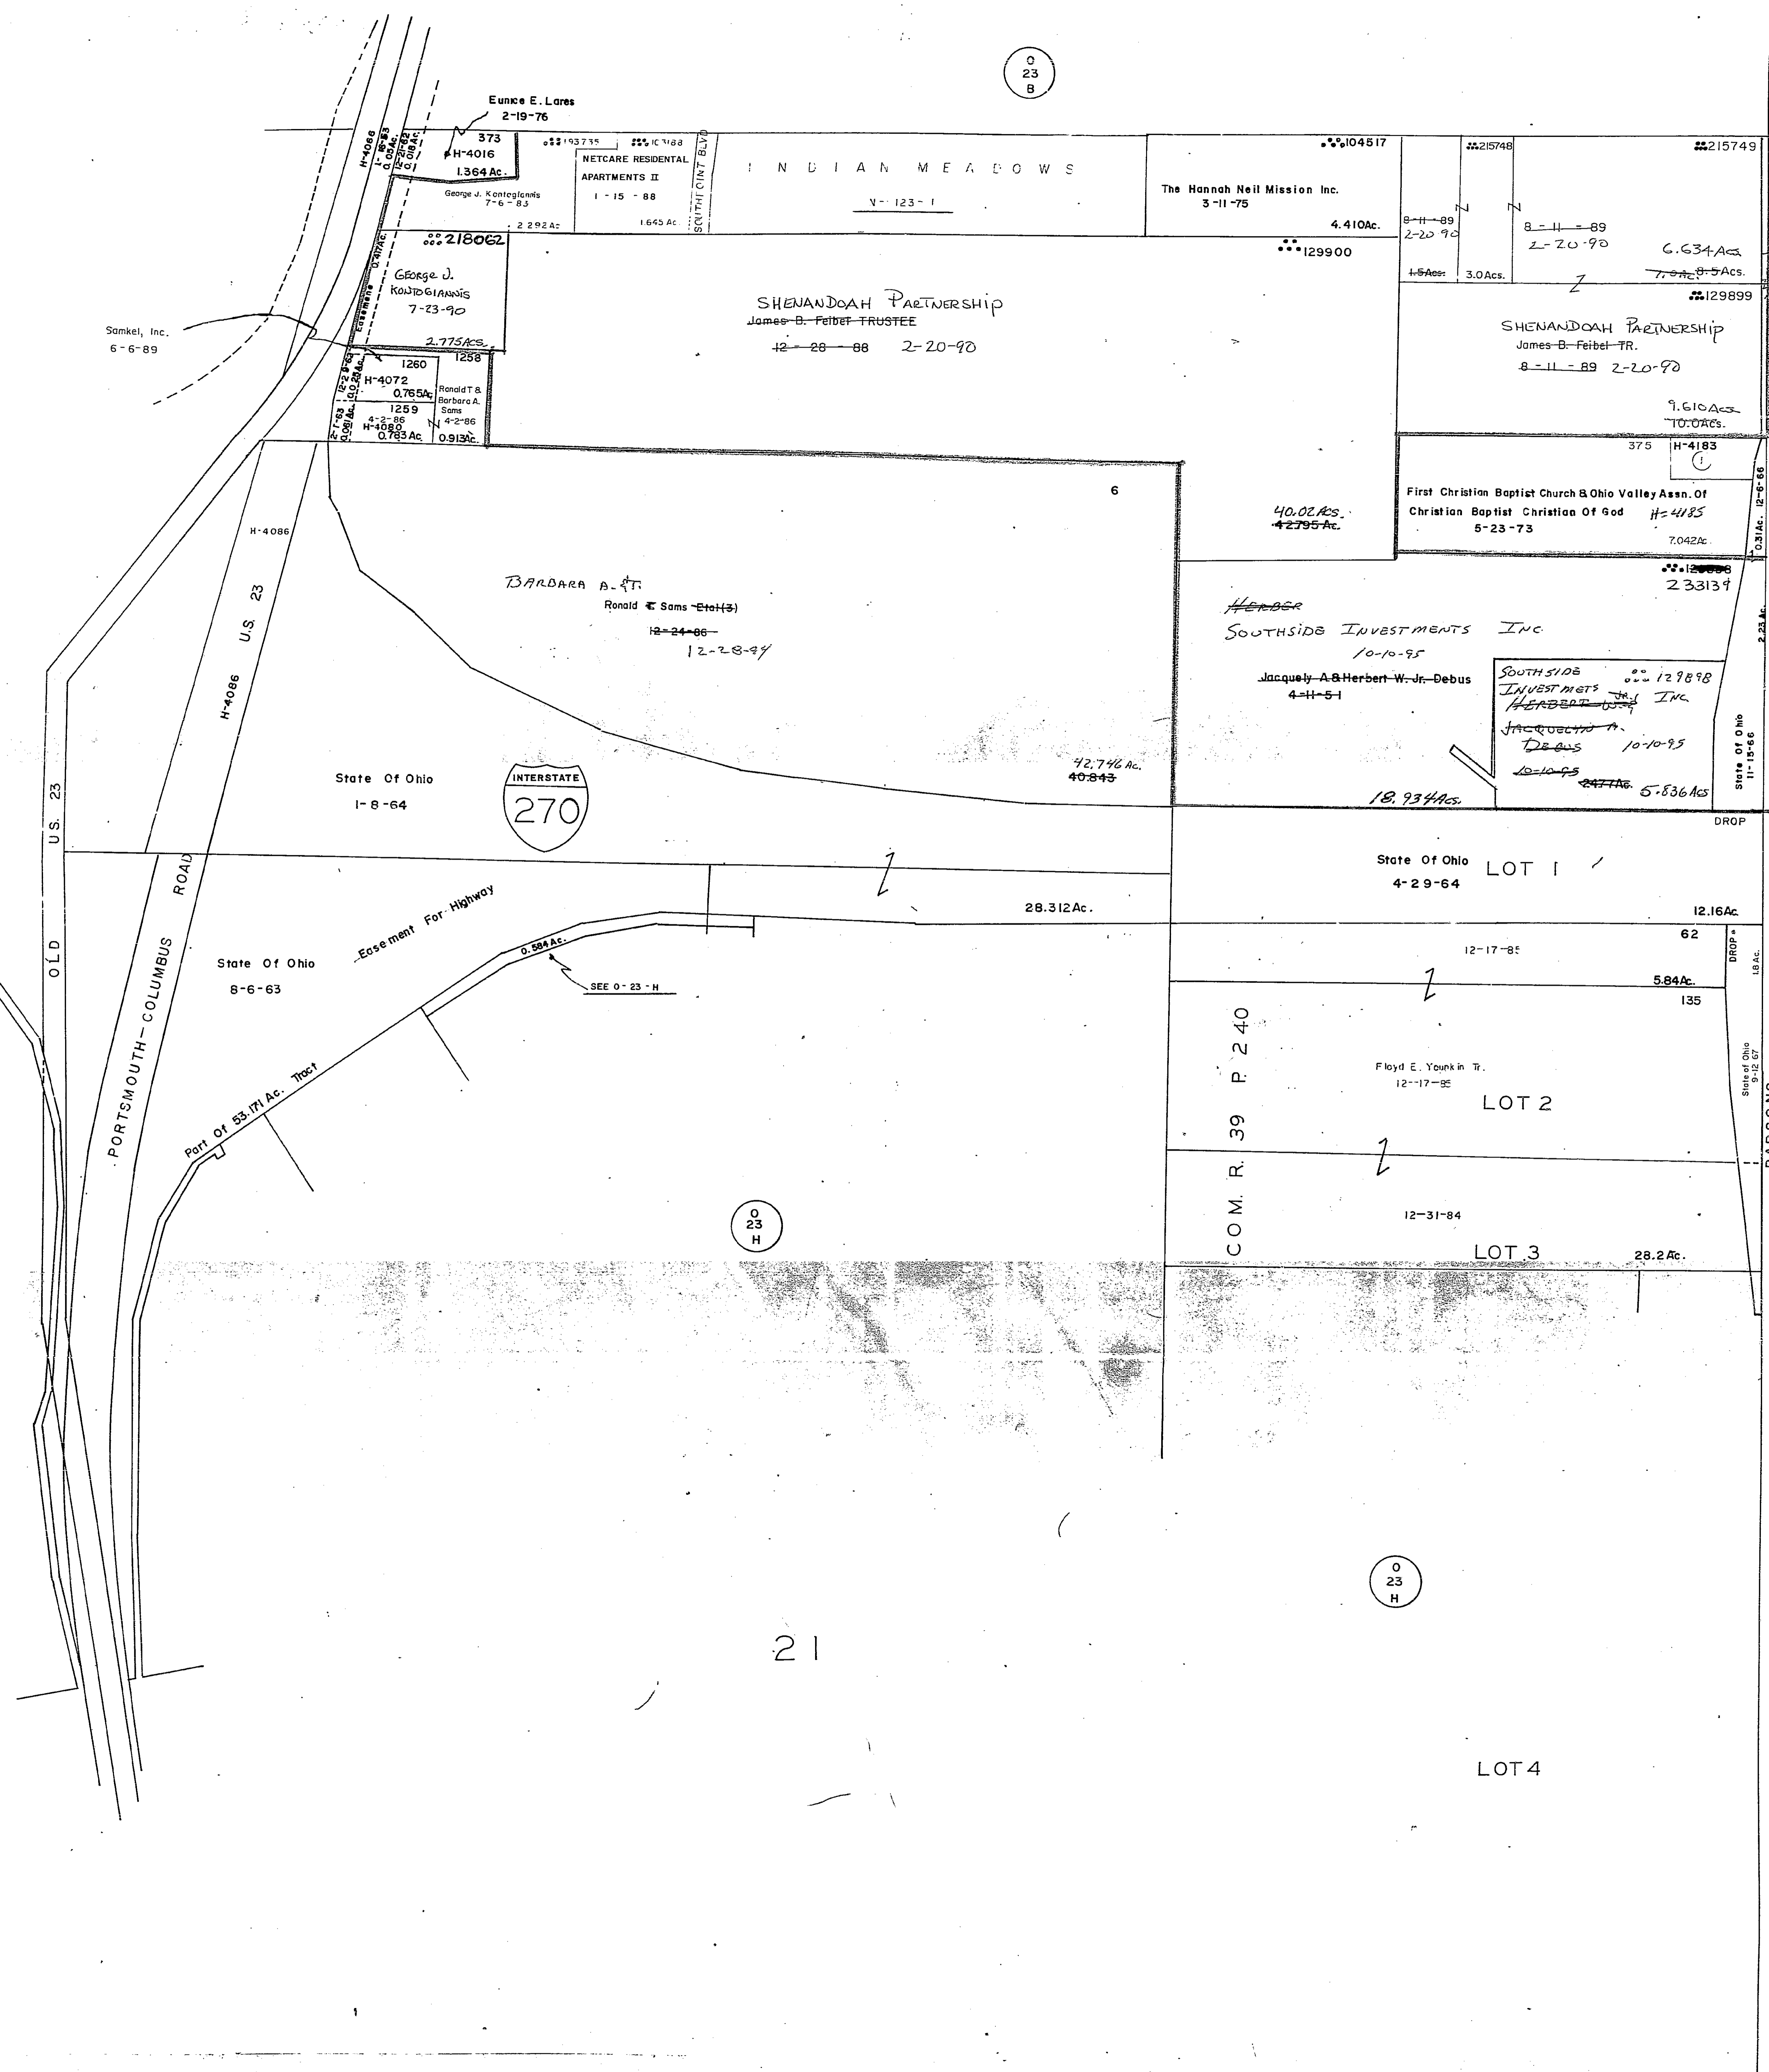

- ① 2383 First Christian Baptist Church And Ohio Valley Association Of Christian Baptist Church Of God 10-25-78 0.648Ac.
- ② DEDICATION OF PARSONS AVE. & EASEMENTS

0-23-E

DATE	10/10/95
BY	[Signature]
SCALE	1"=200'
PROJECT	1/4/90