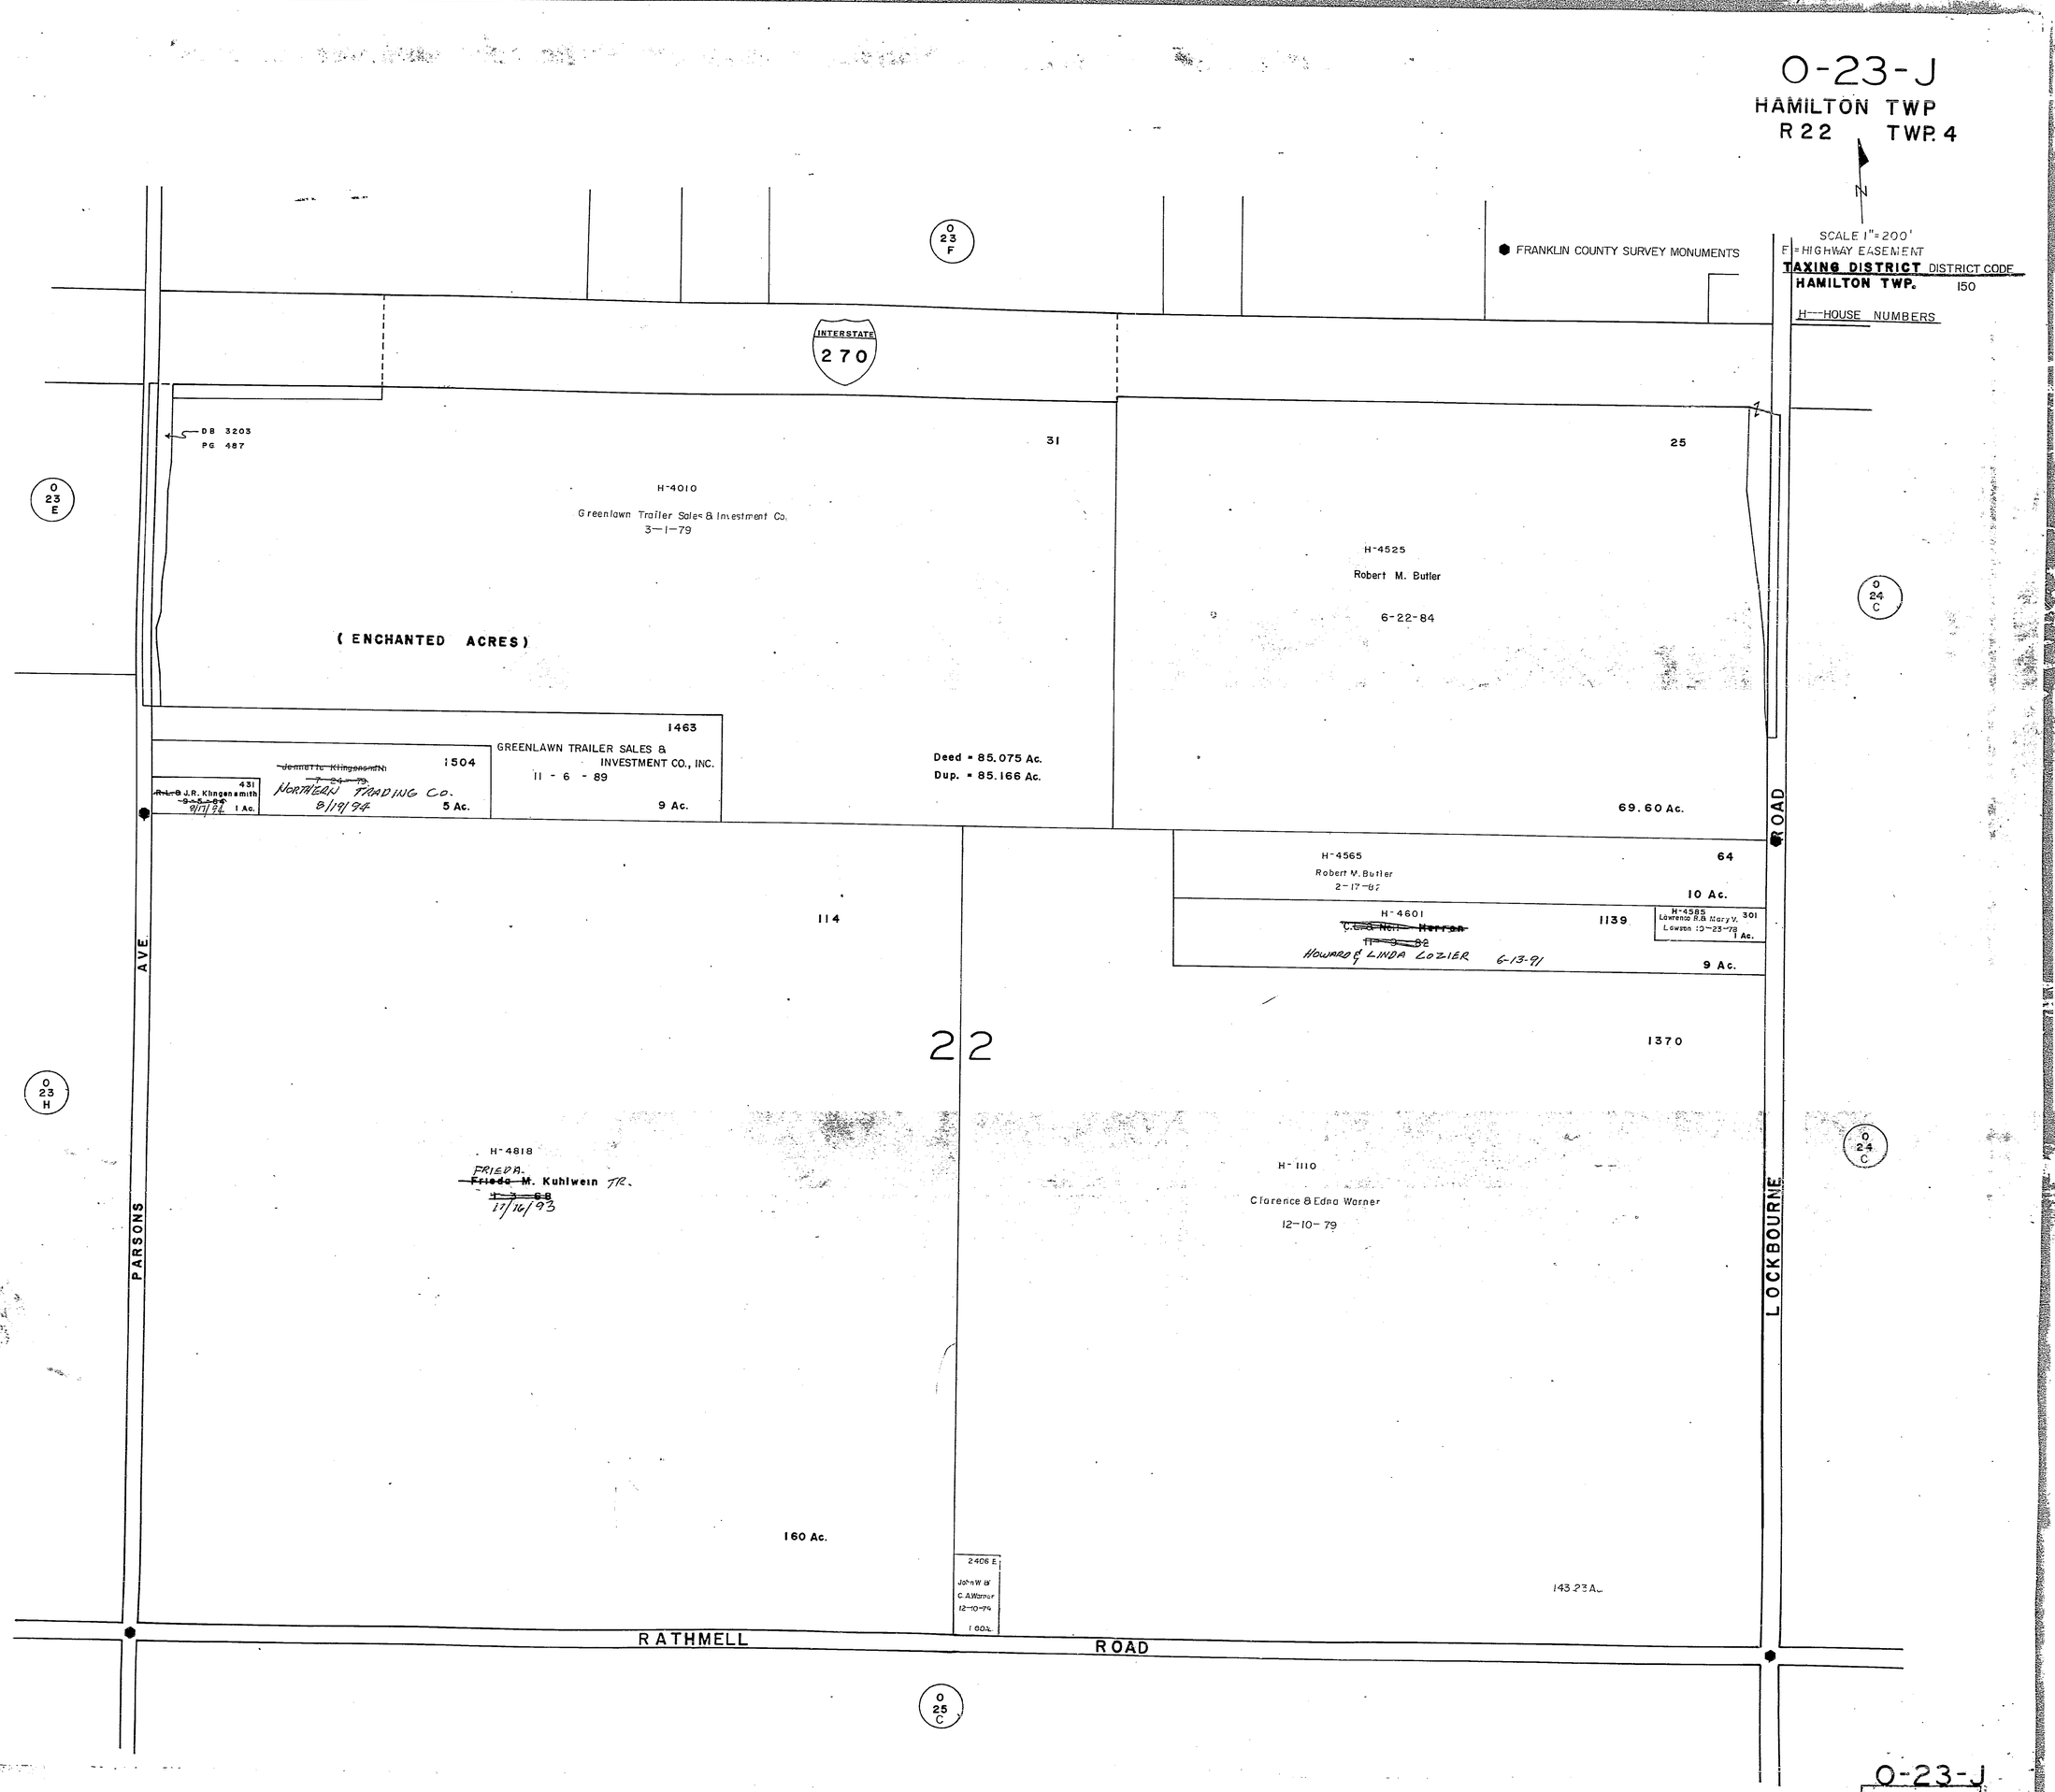
O-23-J
HAMILTON TWP
R 22 TWP. 4
N
SCALE 1"=200'
F=HIGHWAY EASEMENT
TAXING DISTRICT DISTRICT CODE
HAMILTON TWP. 150
H---HOUSE NUMBERS
FRANKLIN COUNTY SURVEY MONUMENTS
INTERSTATE 270
O 23 F
O 23 E
O 23 H
O 24 C
O 25 C
DB 3203 PG 487
31
H-4010
Greenlawn Trailer Sales & Investment Co.
3-1-79
(ENCHANTED ACRES)
Deed = 85.075 Ac.
Dup. = 85.166 Ac.
25
H-4525
Robert M. Butler
6-22-84
69.60 Ac.
1463
GREENLAWN TRAILER SALES & INVESTMENT CO., INC.
11-6-89
9 Ac.
1504
~~Jeniette Klingsmith~~
NORTHERN TRADING CO.
8/19/94
5 Ac.
431
~~R.L.~~ J.R. Klingensmith
~~3-5-84~~
9/17/84
1 Ac.
H-4565
Robert M. Butler
2-17-87
64
10 Ac.
H-4601
~~C.S. Neff Herron~~
~~11-9-82~~
HOWARD & LINDA LOZIER 6-13-91
1139
9 Ac.
H-4585
Lawrence R. & Mary V. Lawson 10-23-78
301
1 Ac.
114
22
1370
H-4818
FRIEDA.
~~Frieda M. Kuhlwein~~ TR.
~~1-3-68~~
11/16/93
160 Ac.
H-1110
Clarence & Edna Warner
12-10-79
143.23 Ac.
2406 E
John W. & C. A. Warner
12-10-74
1 60 Ac.
AVE
PARSONS
RATHMELL ROAD
LOCKBOURNE ROAD
O-23-J
