


0-28-C
 HAMILTON TWP
 R.22 TWP.4

SCALE 1" = 200'
 E-HIGHWAY EASEMENT
 TAXING DISTRICT DISTRICT CODE
 HAMILTON 150
 FRANKLIN COUNTY SURVEY MONUMENT
 H---HOUSE NUMBERS
 * Col. HAM TWP - Col's S.D. 495

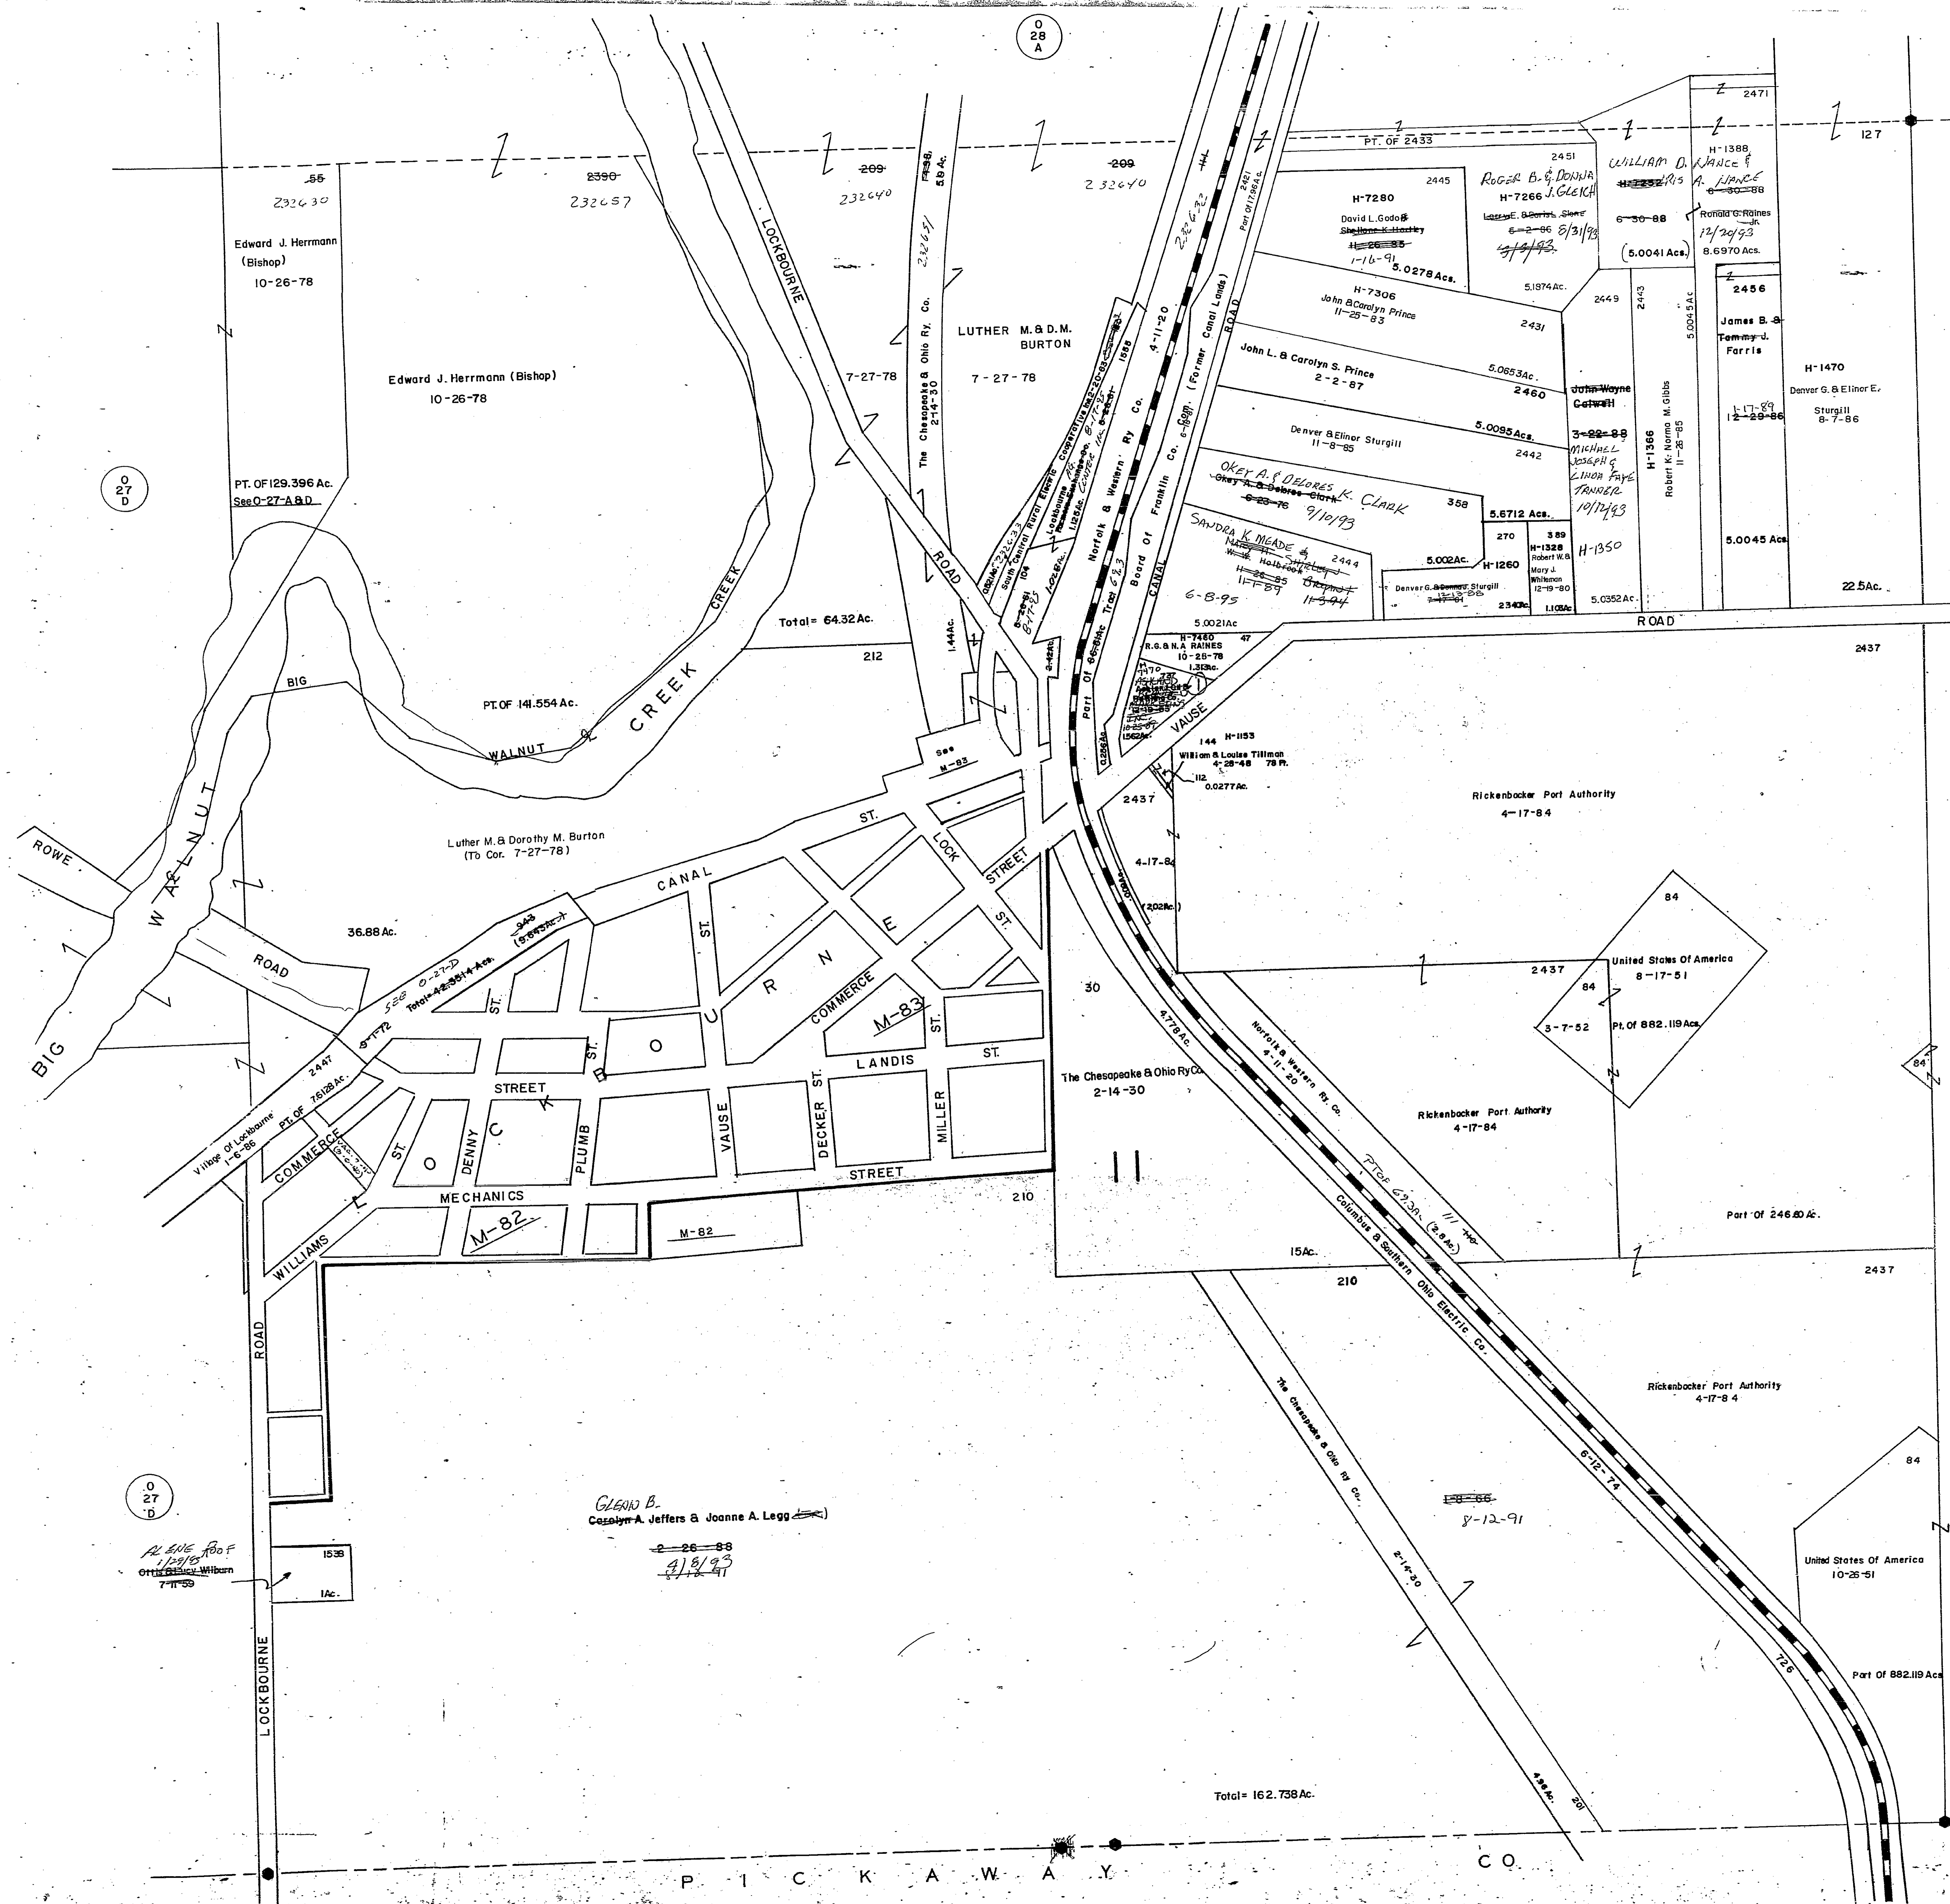

1-737 ELOGARD INC. 10/25/93 1562A.

0-28-C

P I C K A W A Y C O.