


0-30-C
JACKSON TWP

SCALE 1" = 200'
V.M.S.

E = HIGHWAY EASEMENT
TAXING DISTRICT & DISTRICT CODE
JACKSON TWP - 160
CITY OF GROVE CITY 040
H - HOUSE NUMBERS

- 1 885 Herbert & Patricia Fields 8-16-77 .932 Ac.
- 2 884 F F & D Daugherty 4-13-77 .732 Ac.
- 3 1509 Steven K. & Betty L. Richardson 9-10-86 .532 Ac.

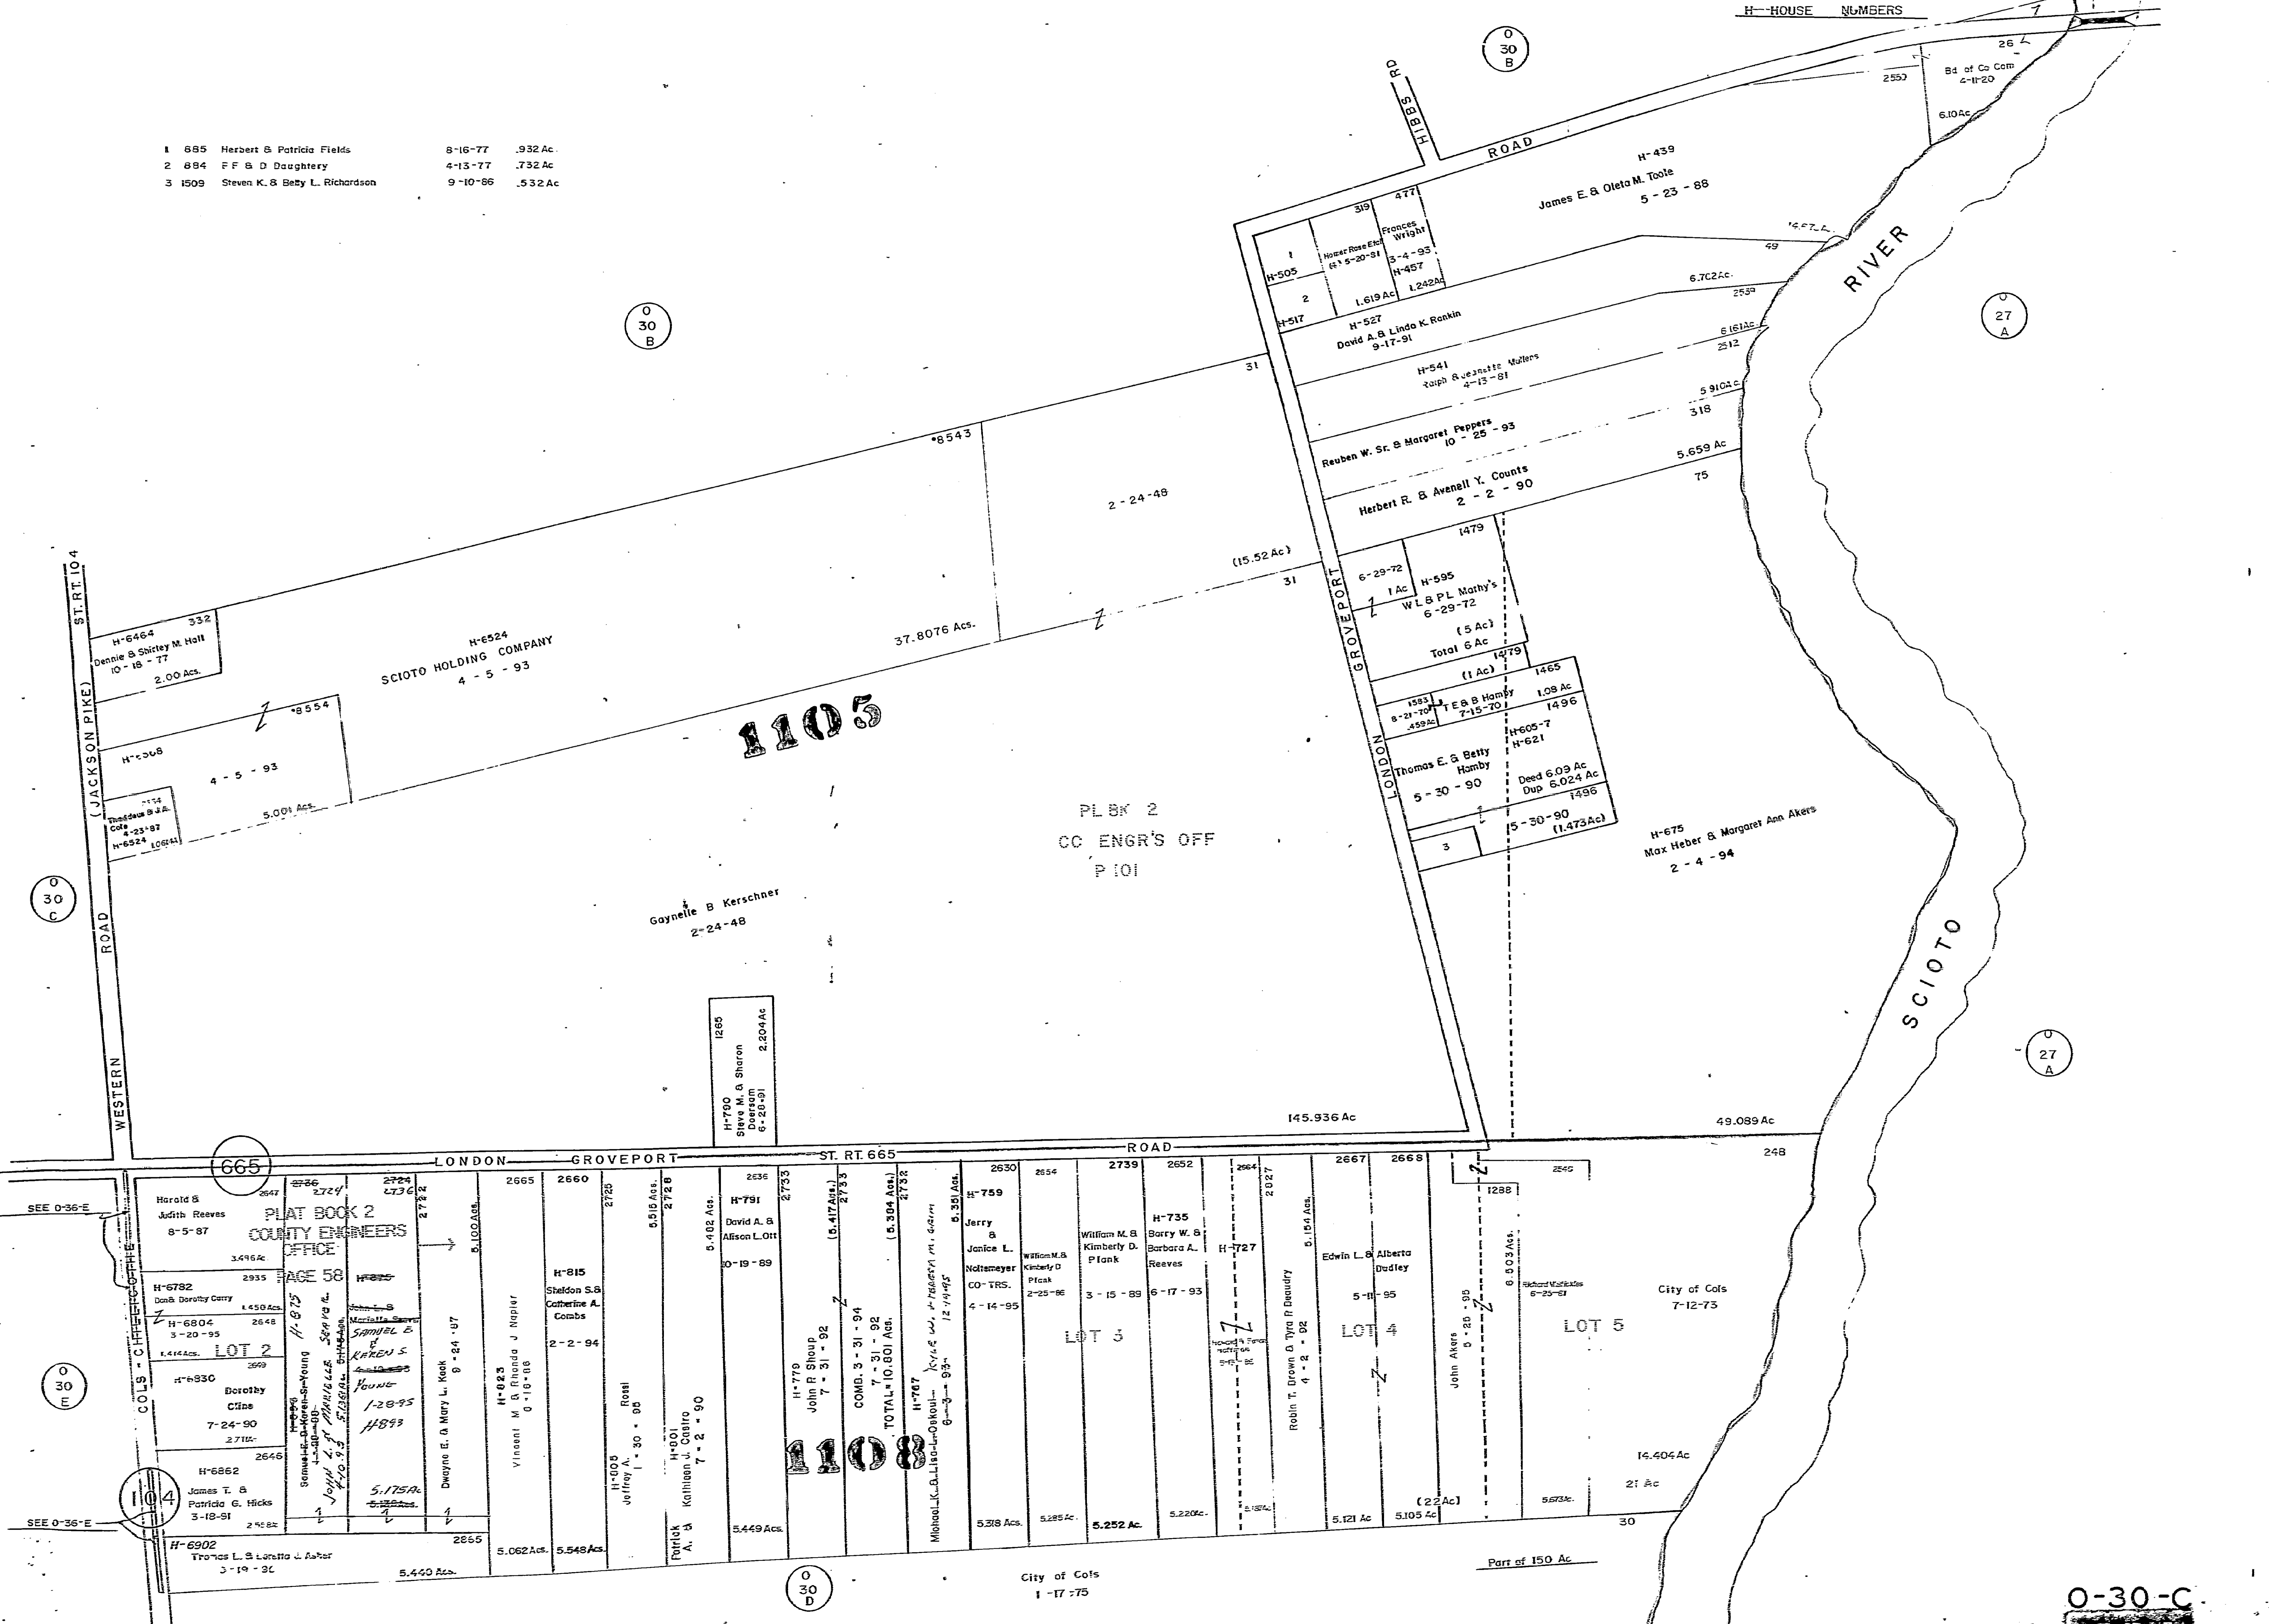

1105

PLAT 2
CC ENGR'S OFF
P 101

2.204 Ac.

<p>665 H-6464 Dennie & Shirley M. Hall 10-18-77 2.00 Ac.</p> <p>H-6524 Dennis 

0-30-C