


- ①**DROP City of Columbus 7-11-78 0.041Ac.
- ② 2446 Columbus & Southern Ohio Electric Company 11-3-78 0.129Ac.
- ③ Drop City of Grove City, Ohio 7-16-81 Hts Corr 3-25-80 0.073Ac.
- ④**19874 STATE OF OHIO FORFEITURE 94CVD01-414 6-27-94 0.177Ac.
- 5-DROP THE CITY OF GROVE CITY OHIO 3-30-89 0.042Ac.

YMS
SCALE 1" = 200'
E-HIGHWAY EASEMENT
TAXING DISTRICT DISTRICT CODE

JACKSON TWP	160
*GROVE CITY	040
**COLS.-SW.S.D.	570
***COLUMBUS	010
H---HOUSE	NUMBERS

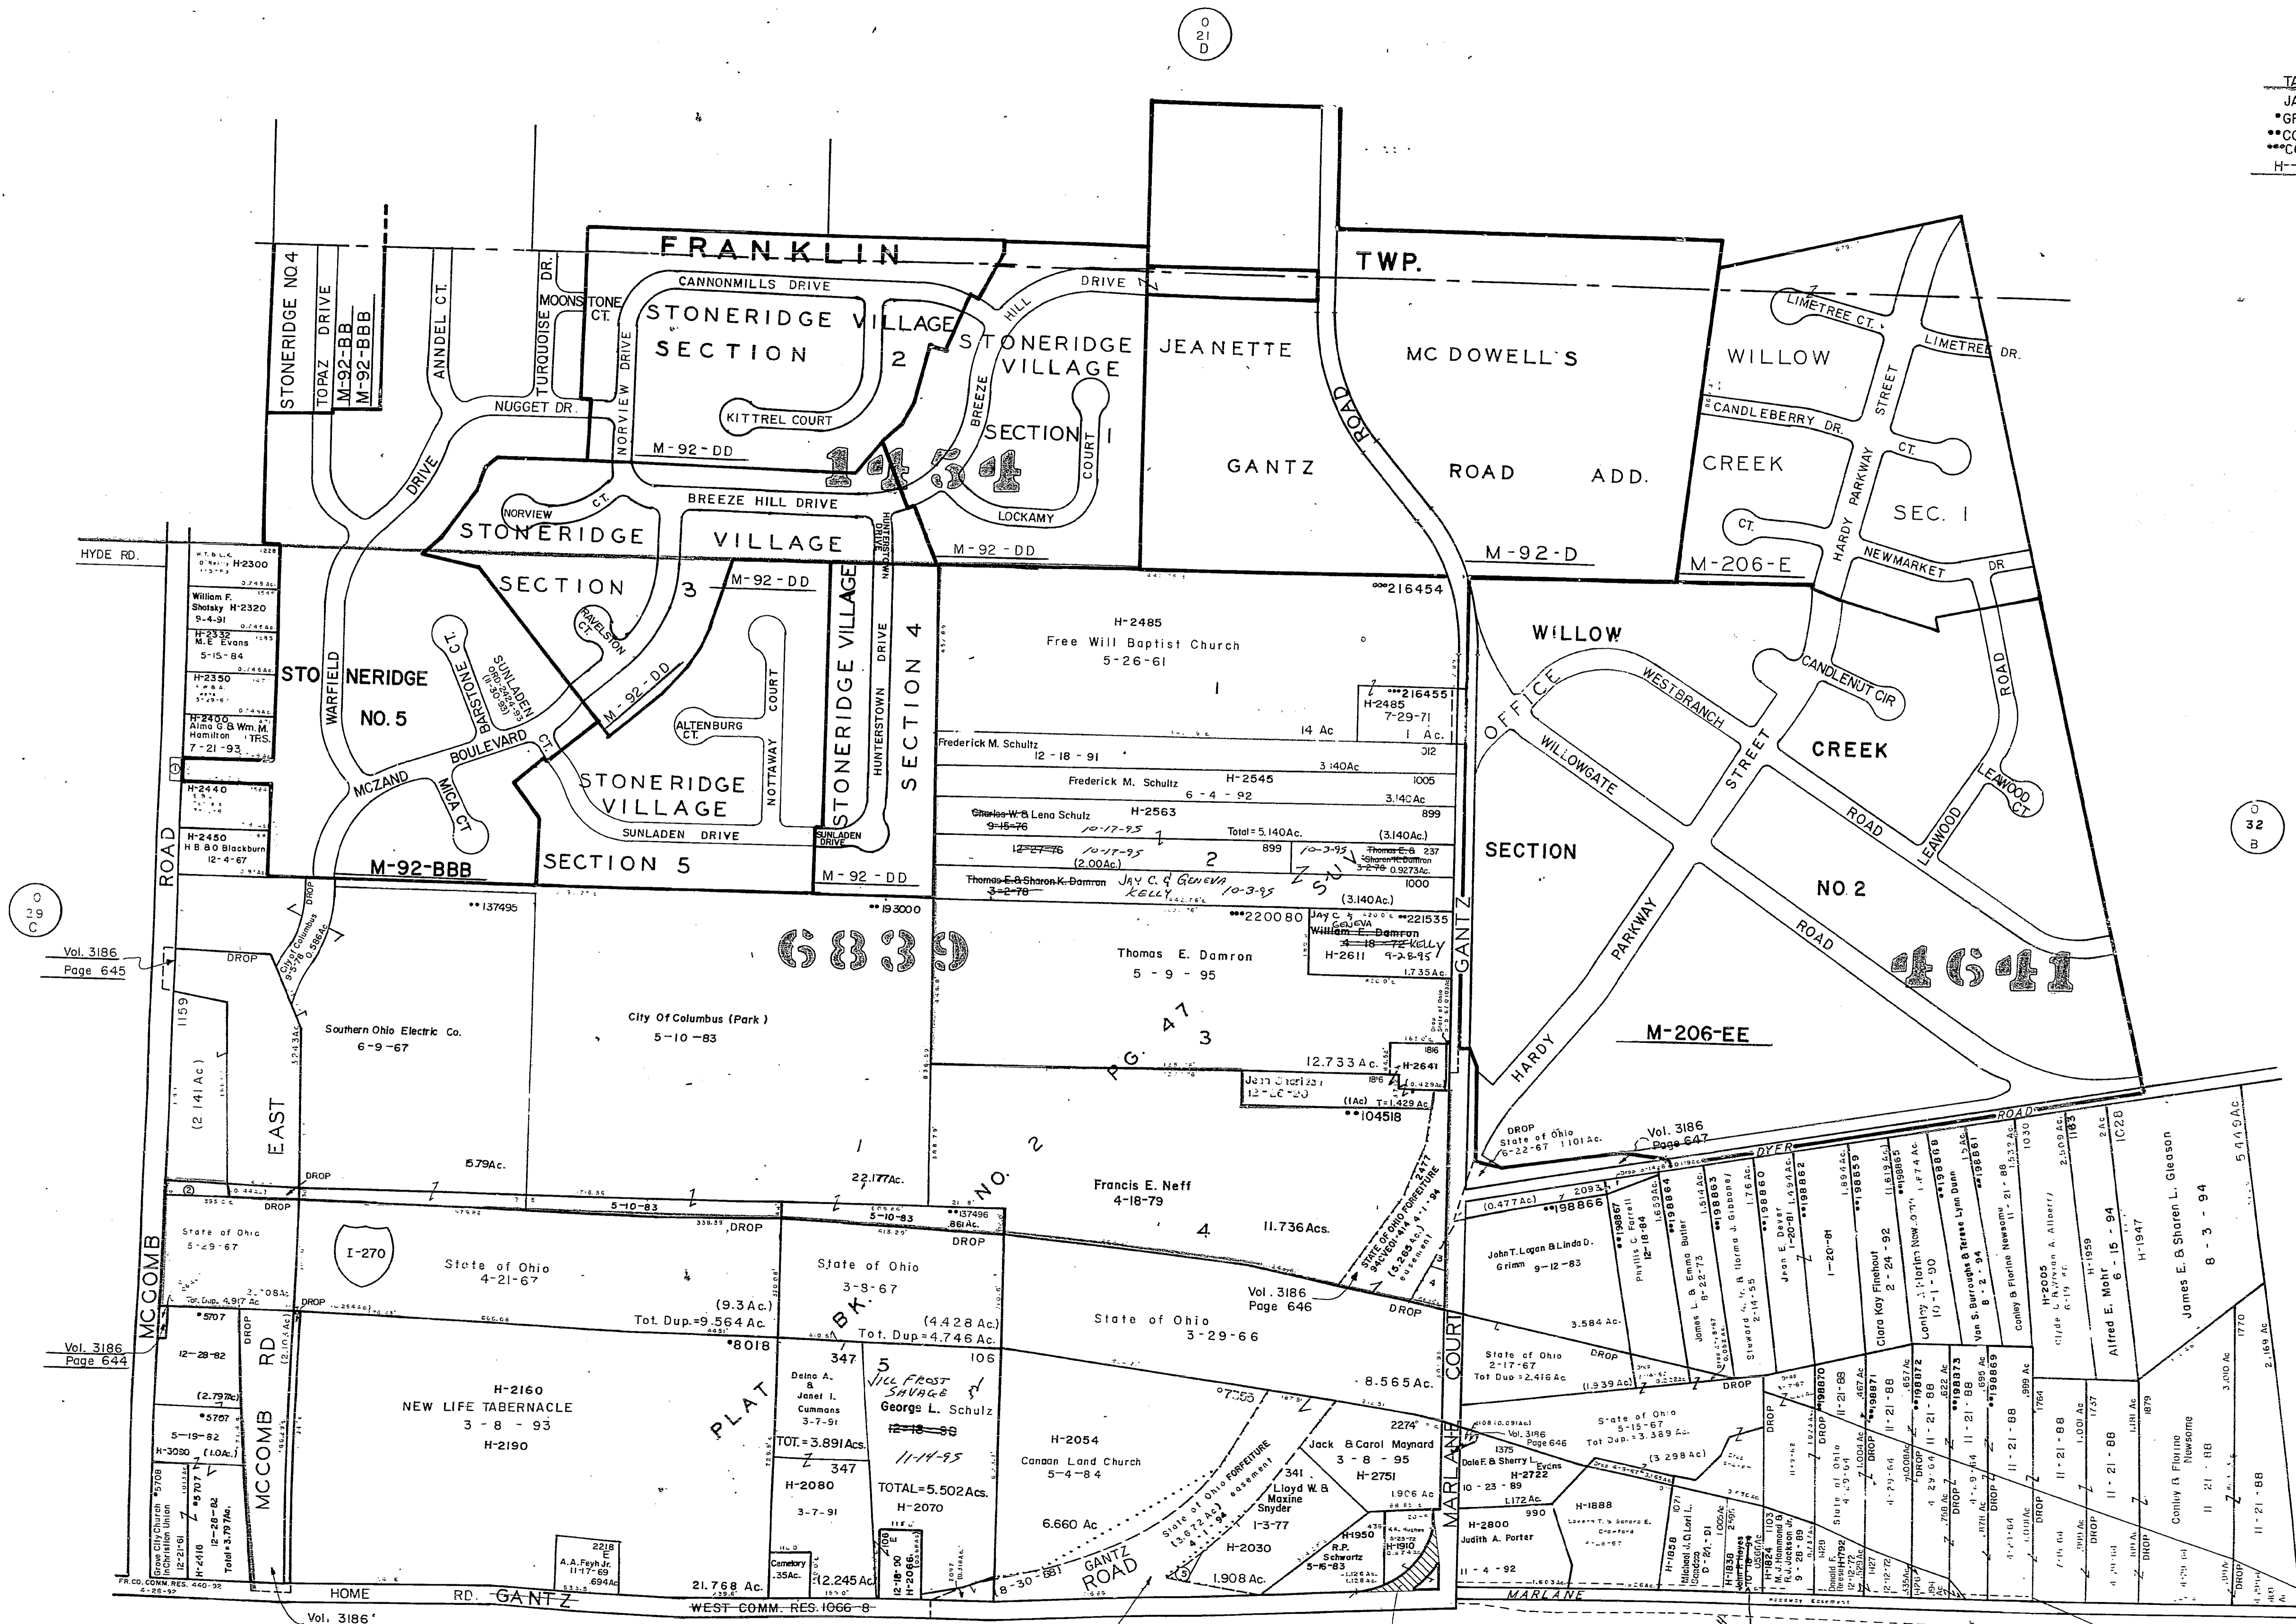

Vol. 3186 Page 645

Vol. 3186 Page 644

Vol. 3186 Page 644

Vol. 3186 Page 645

Vol. 3186 Page 645

0 32 D

0 32 D

0 21 D

0-32-A
1985
11/15/85