0-33-C

JACKSON TWP.

N

V.M.S.
SCALE 1"=200'
E=HIGHWAY EASEMENT

TAXING DISTRICT	DISTRICT CODE
JACKSON TWP.	160
*GROVE CITY	040

H---HOUSE NUMBERS

● FRANKLIN COUNTY SURVEY MONUMENTS

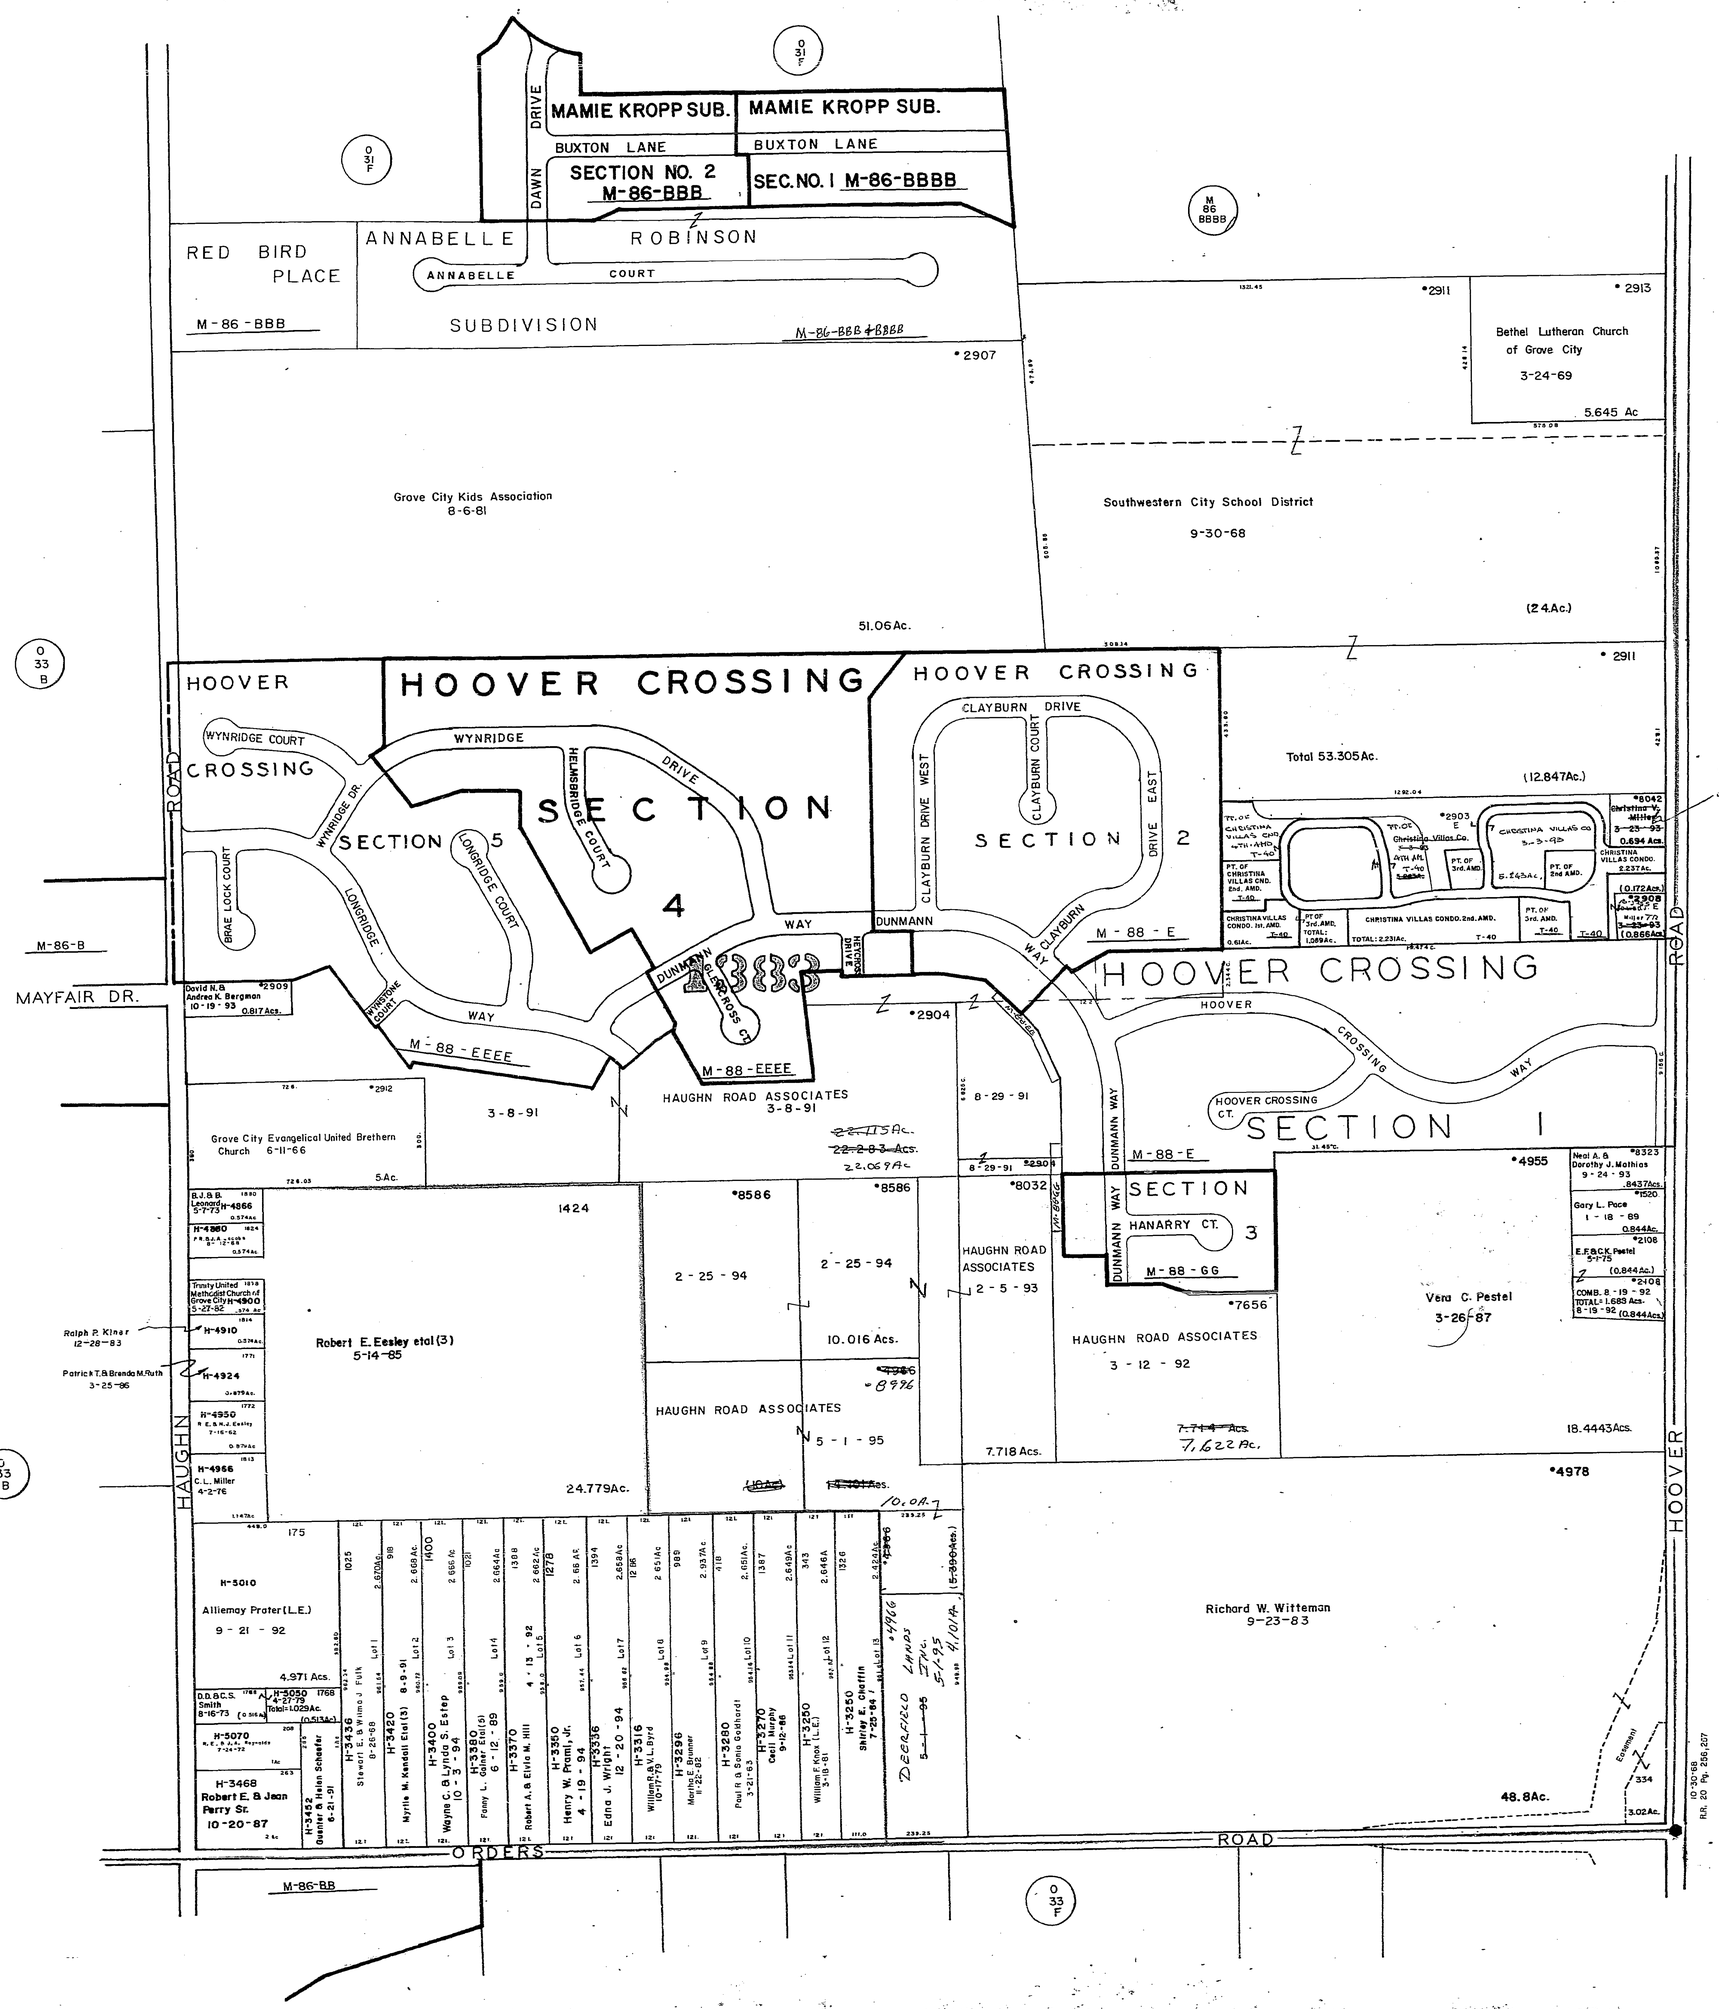

033-C