JACKSON TWP

N

SCALE 1" = 200'

V.M.S.

E=HIGHWAY EASEMENT

TAXING DISTRICT	DISTRICT CODE
JACKSON TWP	160
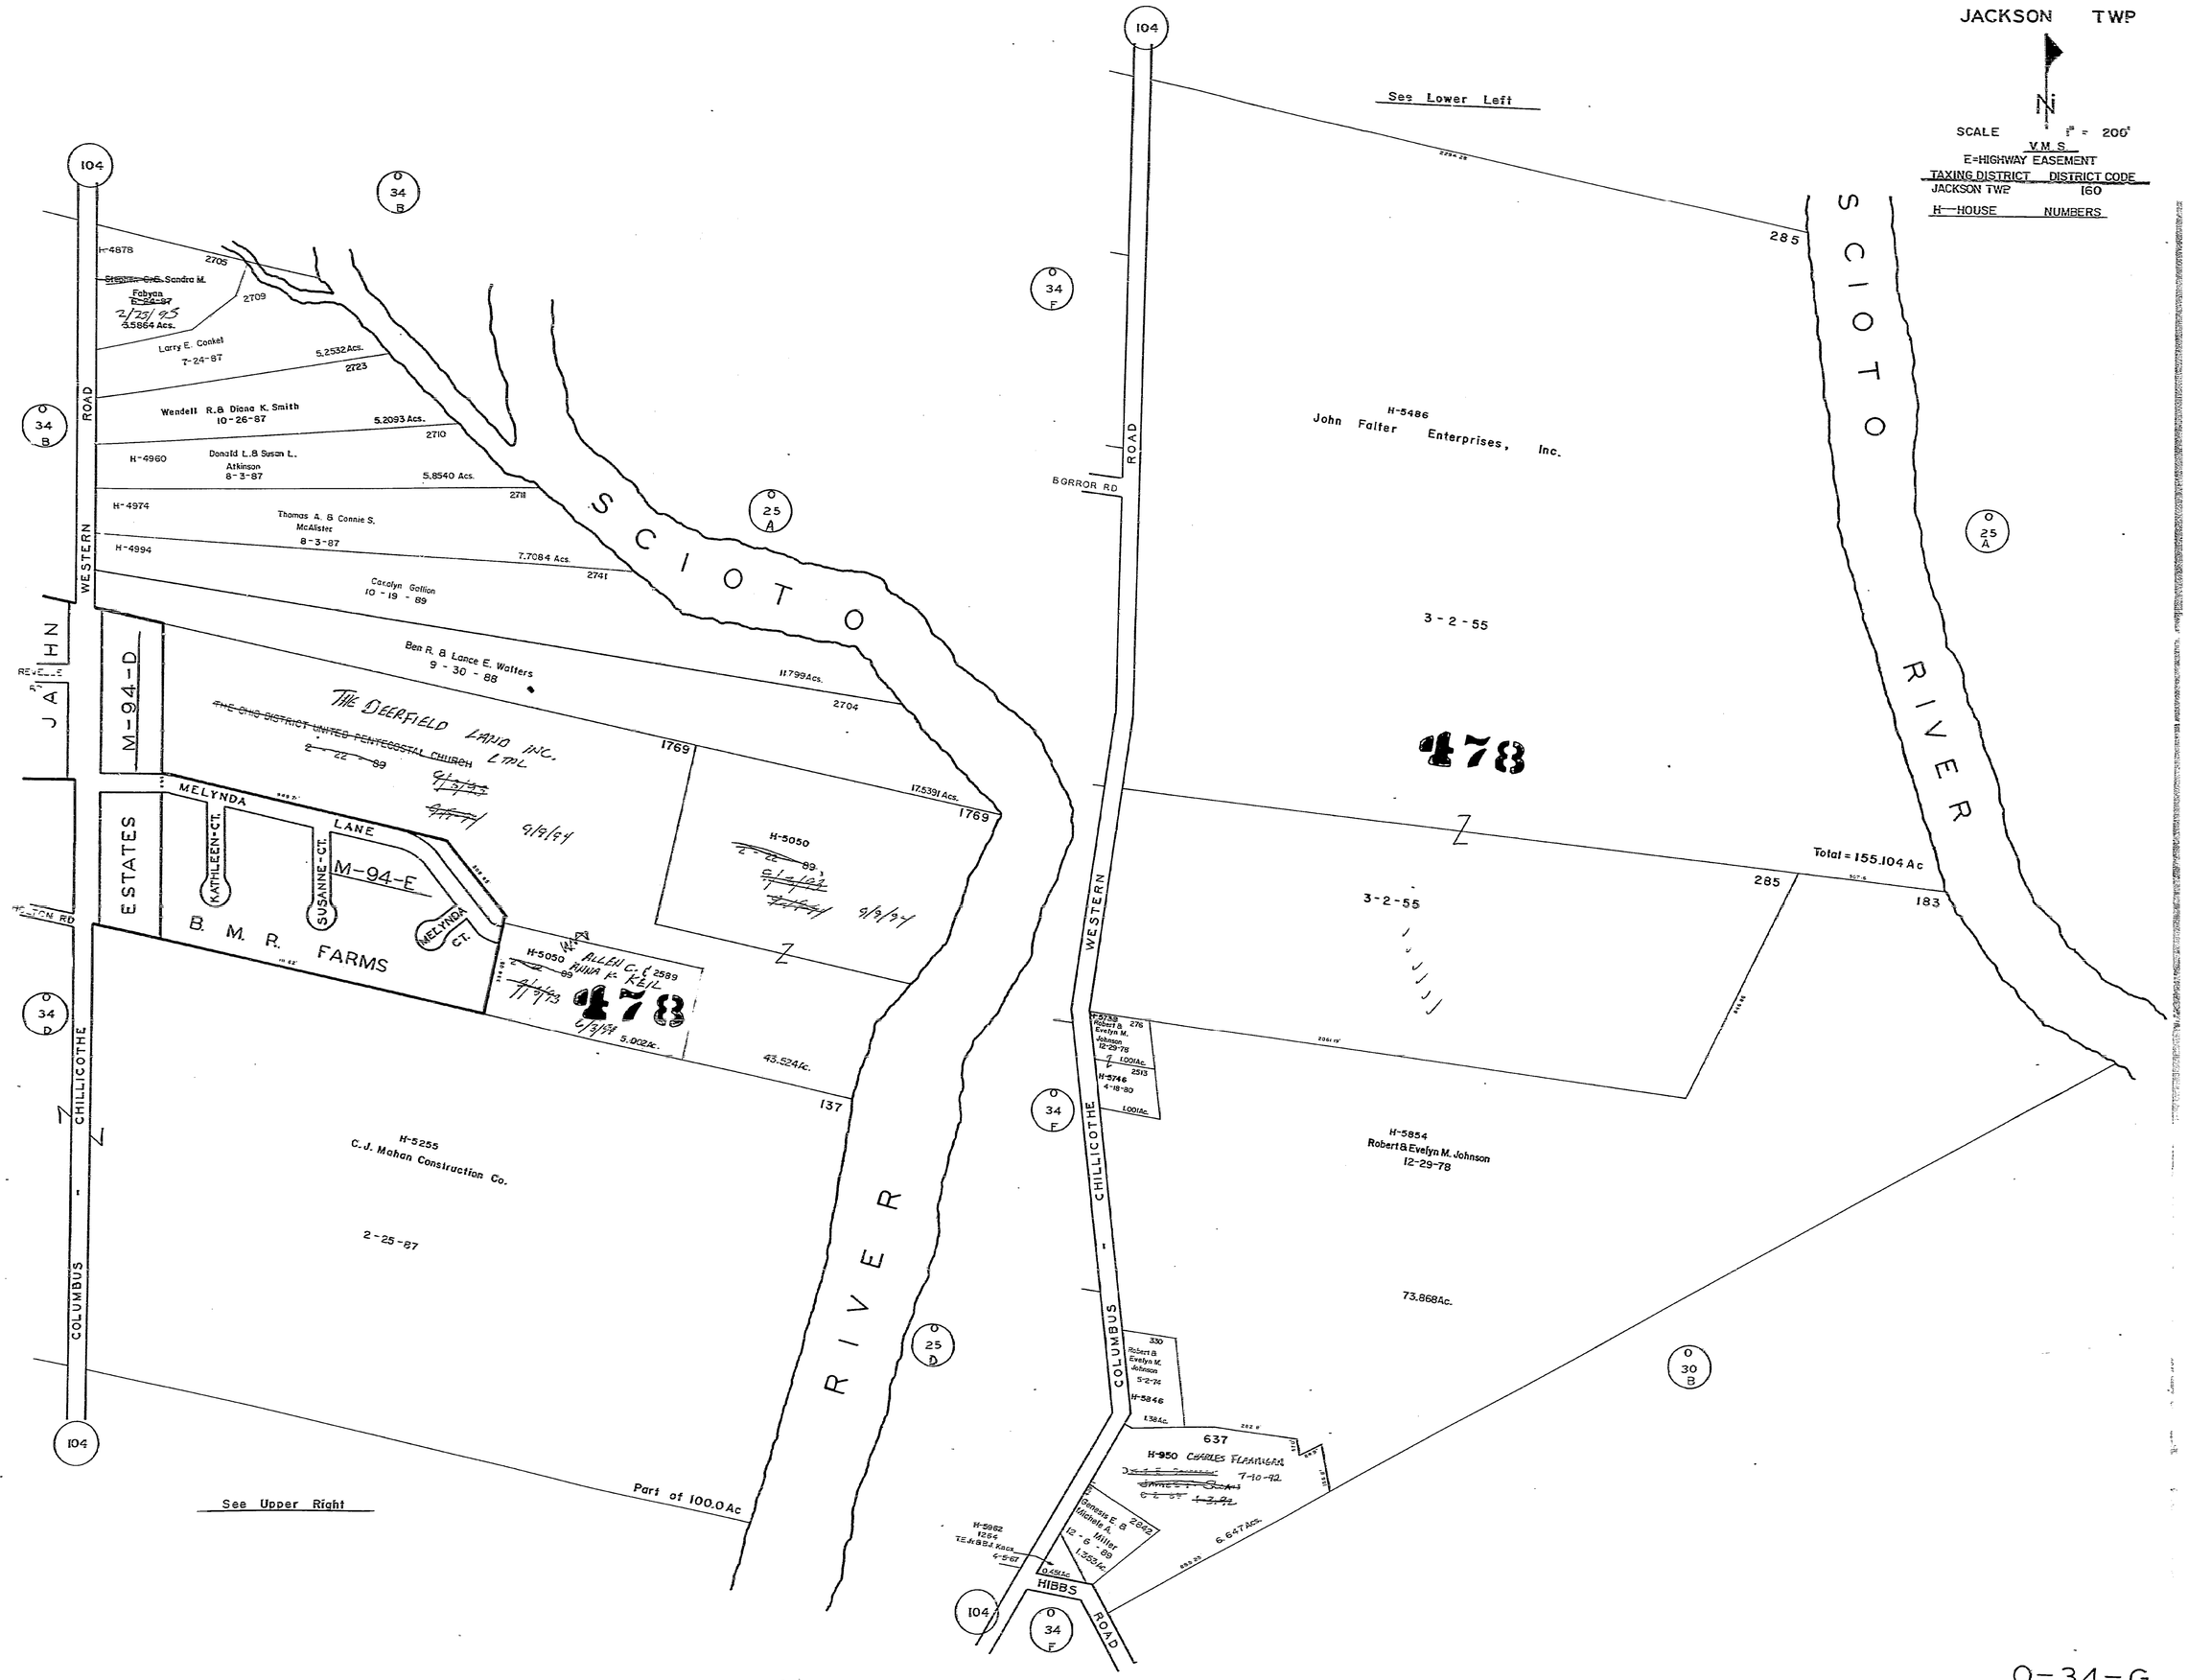
H—HOUSE NUMBERS