


SCALE 1"=200'
E=HIGHWAY EASEMENT
TAXING DISTRICT, DISTRICT CODE
JEFFERSON 170

FRANKLIN COUNTY SURVEY MONUMENT
H--HOUSE NUMBERS

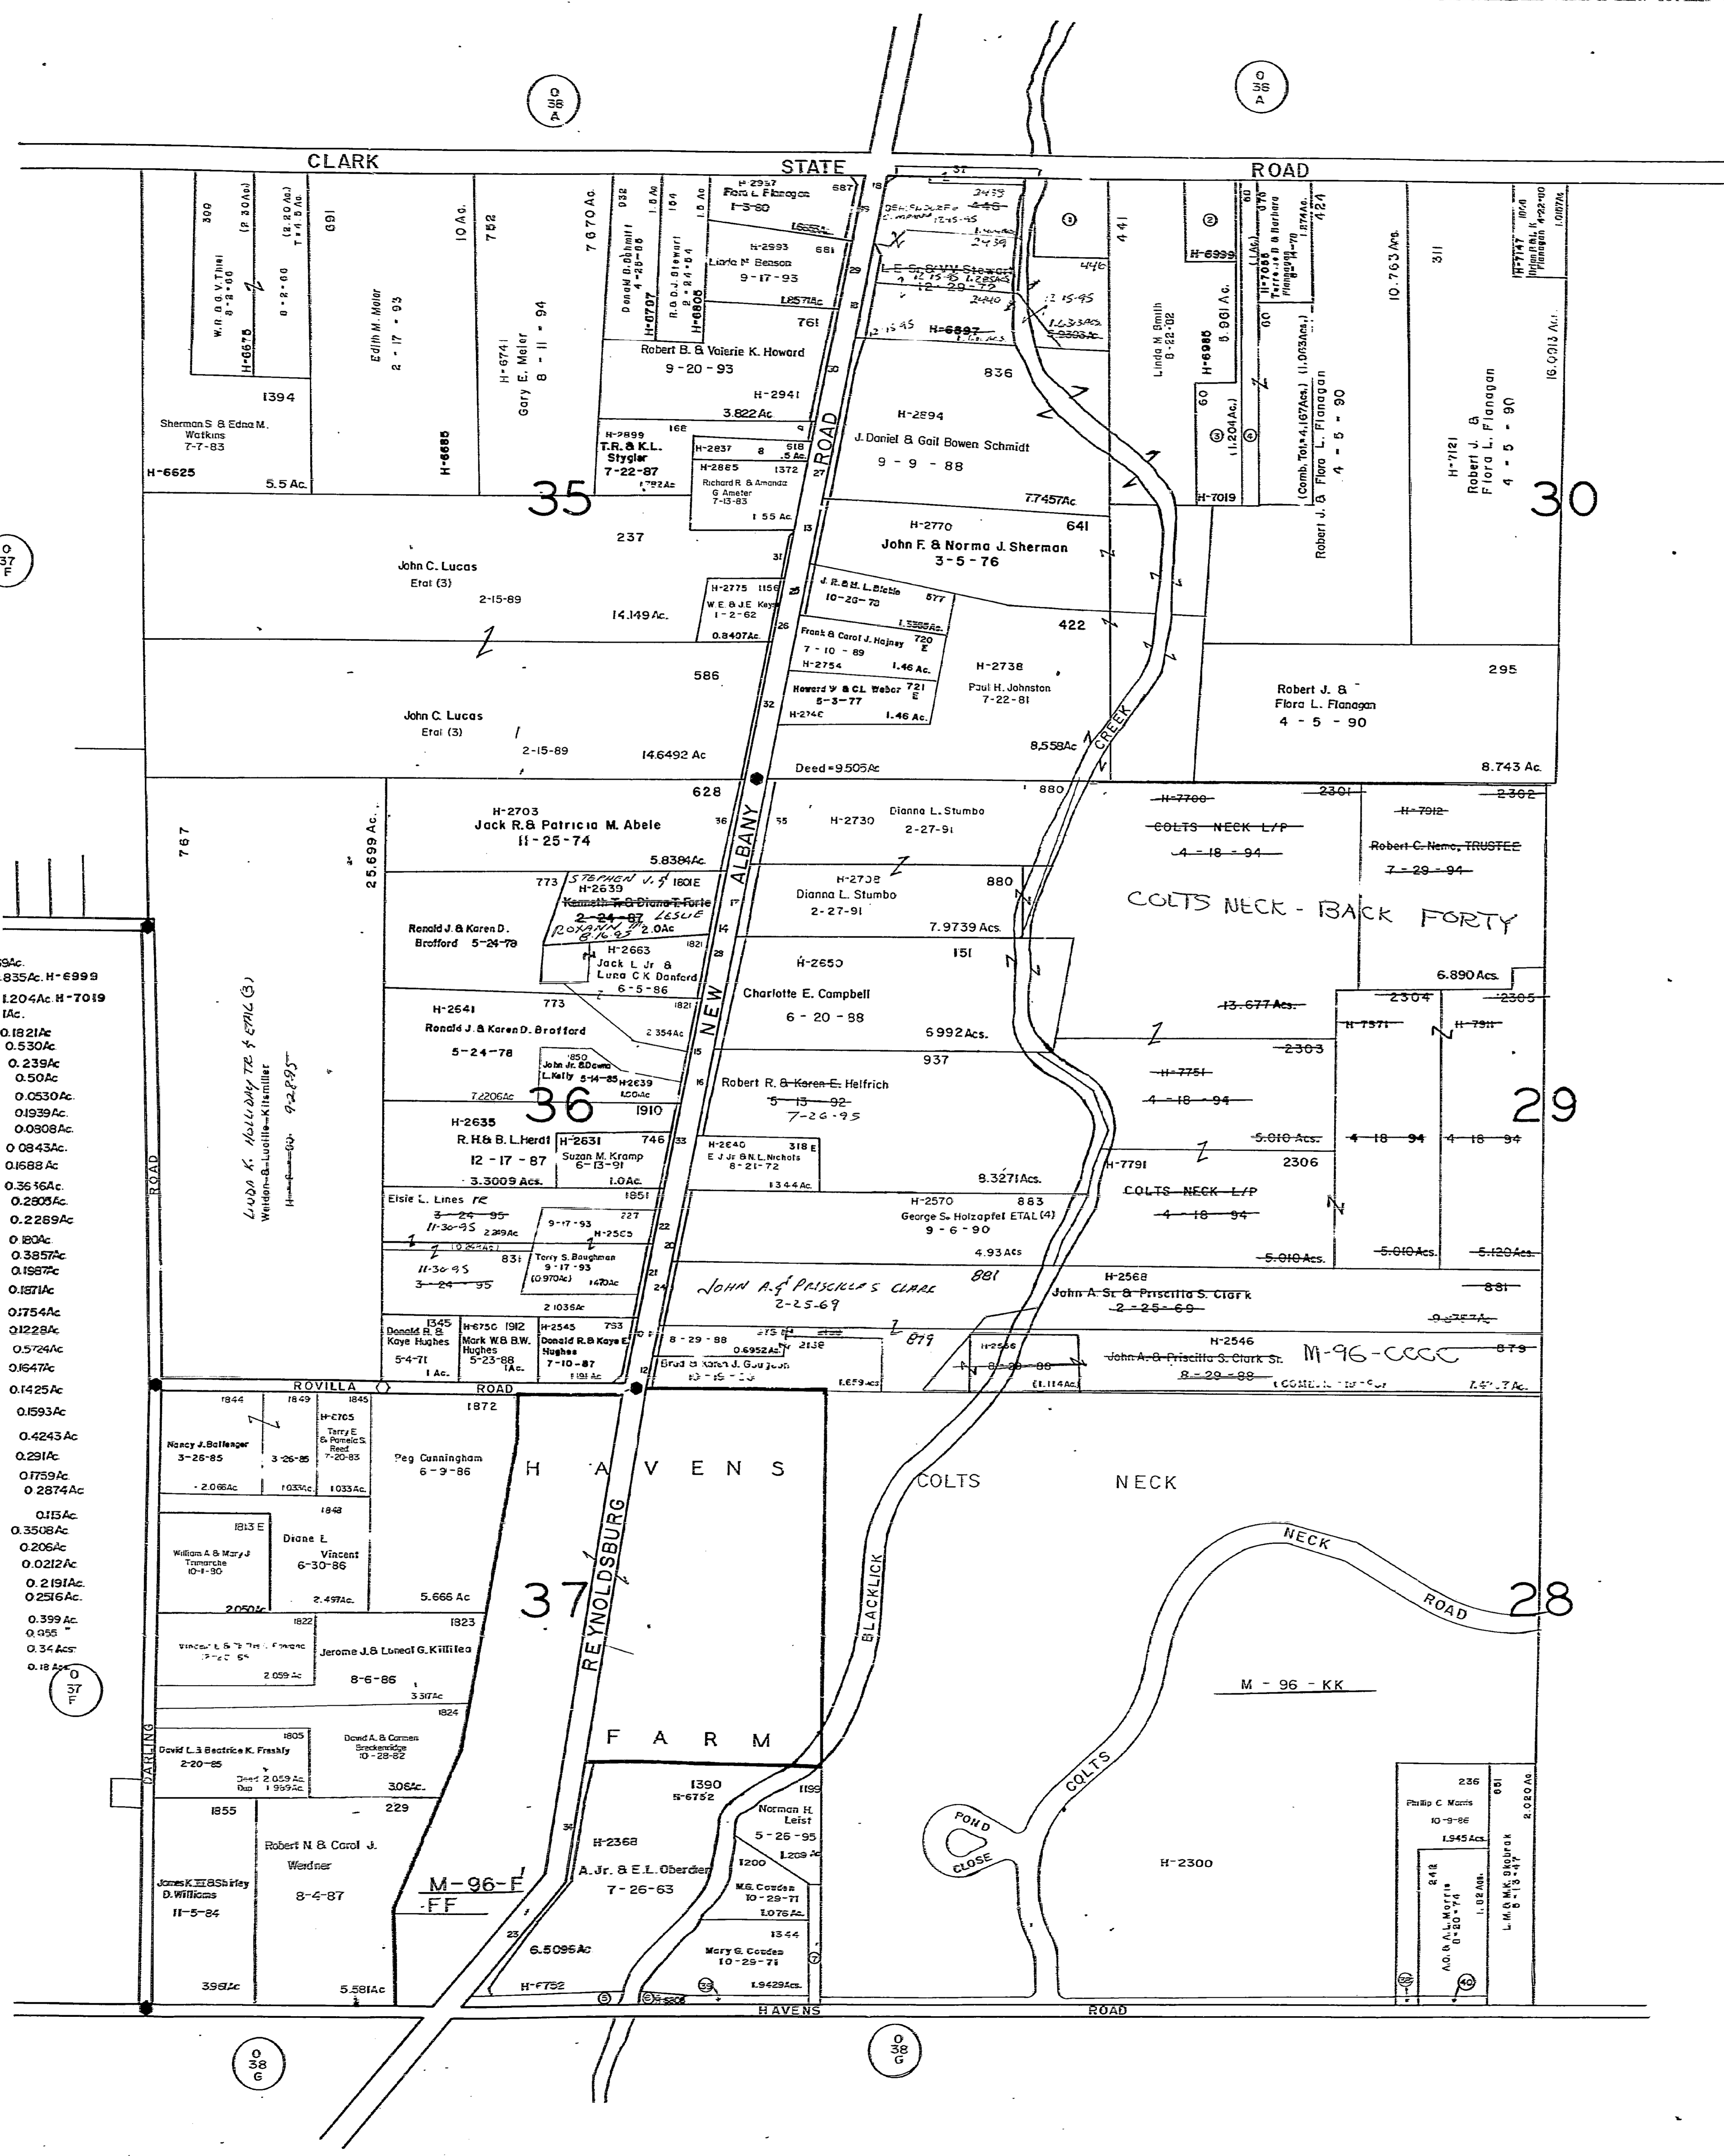

1-37 Cemetery Of Jefferson Twp.	4-11-20	1169Ac.
2-1206 Thomas E. & Suzanne M. Keene	7-2-85	0.835Ac. H-6999
3-60 Mathew S. Flanagan	11-13-75	1204Ac. H-7019
4-	2-11-72	1Ac.
5-Drop Franklin County	0-23-71	0.239Ac.
6-	12-6-95	0.50Ac.
7-1343 HG. Lesr EtAKS	3-31-78	0.0530Ac.
8-618 Dorothy M. Styler	4-10-76	0.1939Ac.
9-Drop County Of Franklin	4-27-78	0.0908Ac.
10-Drop County Of Franklin	5-10-78	0.0843Ac.
11-	5-17-78	0.3616Ac.
12-	5-17-78	0.2805Ac.
13-	5-30-78	0.2289Ac.
14-	5-30-78	0.180Ac.
15-	5-18-78	0.3857Ac.
16-	5-30-78	0.1987Ac.
17-		0.1971Ac.
18-	6-8-78	0.1754Ac.
19-	6-8-78	0.1228Ac.
20-	6-15-78	0.5724Ac.
21-	6-9-78	0.1647Ac.
22-	6-9-78	0.1425Ac.
23-	6-15-78	0.1593Ac.
24-	6-23-78	0.4243Ac.
25-	5-9-78	0.291Ac.
26-	6-7-78	0.1759Ac.
27-	6-7-78	0.2874Ac.
28-	9-1-78	0.115Ac.
29-	9-1-78	0.3508Ac.
30-	10-11-78	0.206Ac.
31-	8-21-79	0.0212Ac.
32-	1-10-80	0.2191Ac.
33-		0.2516Ac.
34-1801 Albert Jr & Edith L. Oberdier	8-2-84	0.399Ac.
35-Drop County Of Franklin	8-5-93	0.955Ac.
36-		0.34Ac.
37-Drop Franklin County Commission (Hi-Way)	8-24-93	0.18Ac.