1 ****855 Board Of Education Madison Local S.D. 3-10-75 0.165Ac.
2 ****431 Robert & Kathleen A. White 6-18-92 0.595Ac.
3 ****1328 ~~Property~~ M.E. Mozishe ~~11-20-90~~ 6-1-95 0.556Ac.
4 ****1390 John D. & Ruth A. Stem 3-16-89 0.510 Ac
5 ****1391 ~~Property~~ M.E. Mozishe ~~11-20-90~~ 6-1-95 0.556 Ac
6 ****809 Groveport Madison Local Schools 12-24-86 0.50 Ac.
7 4979 Shirley R. & Michael R. Davis 5-30-90 0.628 Acs.

O-45-D

MADISON TWP

R.21 TWP.11

TAXING DISTRICT	DISTRICT CODE
MADISON TWP	180
****MADISON TWP-GROVEPORT CORP	185

● FRANKLIN COUNTY SURVEY MONUMENT

H—HOUSE NUMBERS

N

SCALE 1"=200'
E=HIGHWAY EASEMENT

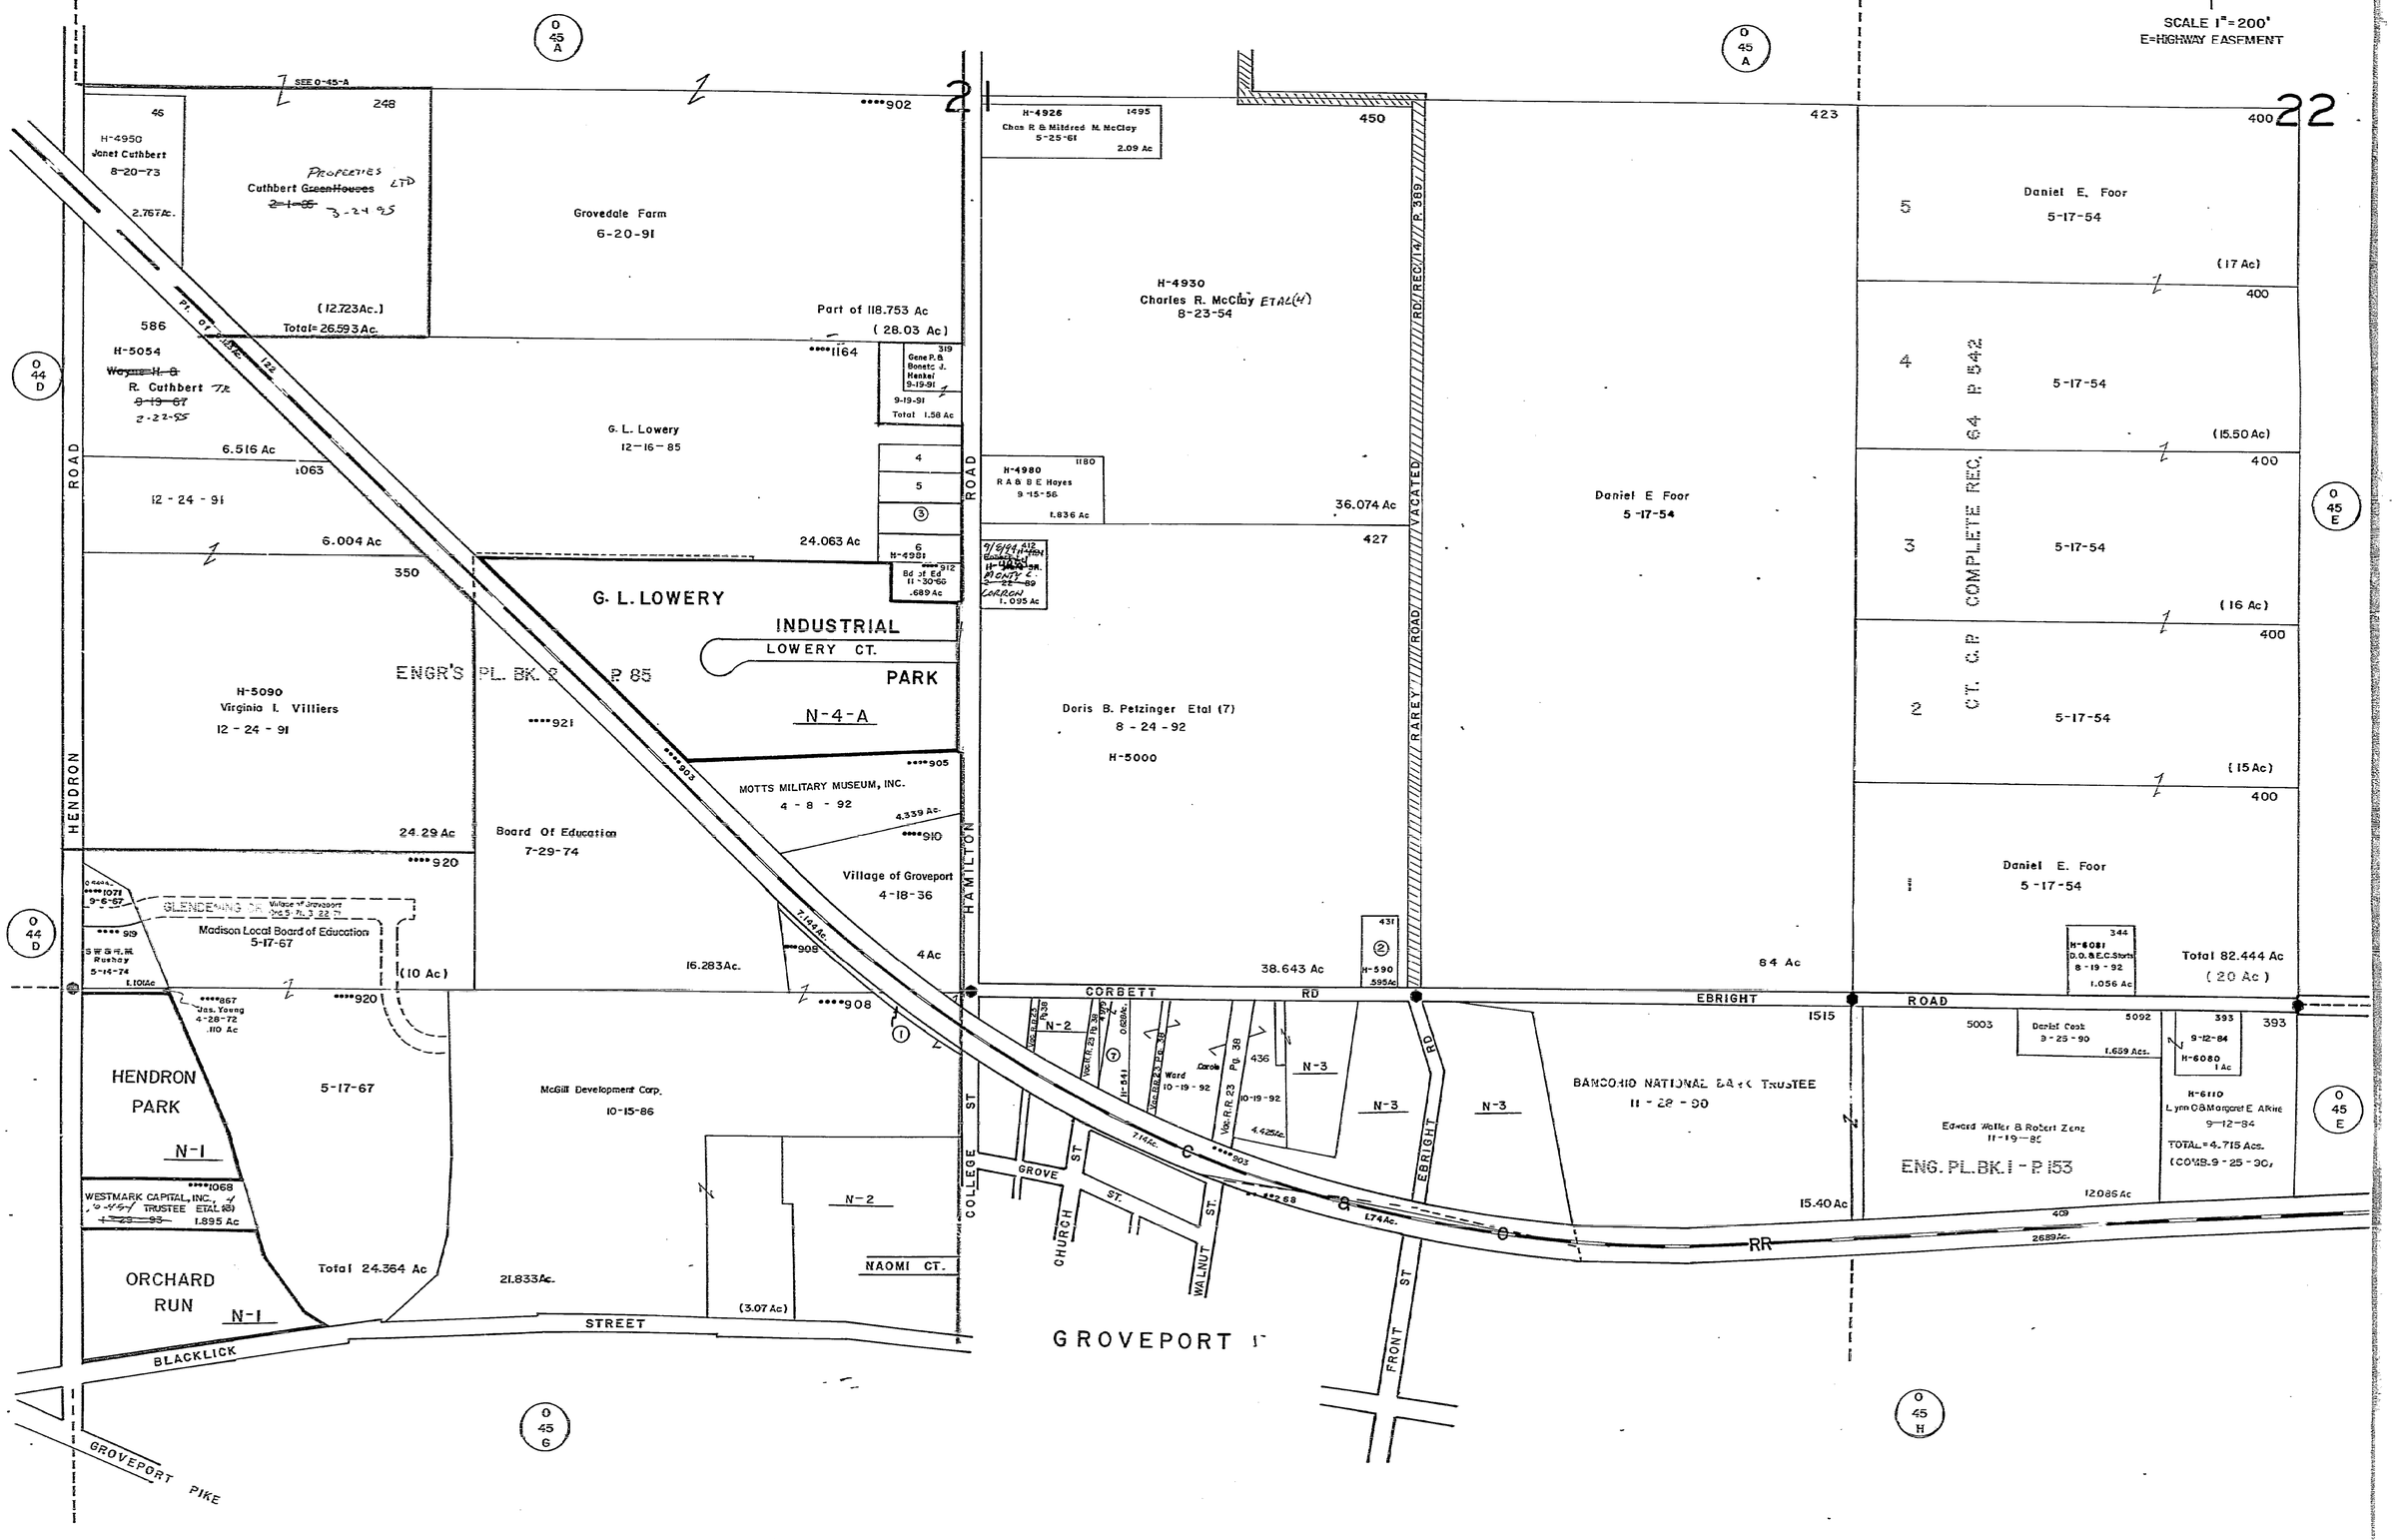

O-45-D

LR 3
9/9/95