


0-59-C  
 MIFFLIN TWP.  
 R.17 TWP.1

SCALE 1"=200'  
 E-HIGHWAY EASEMENT  
 TAXING DISTRICT CODE

CITY OF GAHANNA-  
 GAHANNA JEFF. S.D. 025  
 H-HOUSE NUMBERS

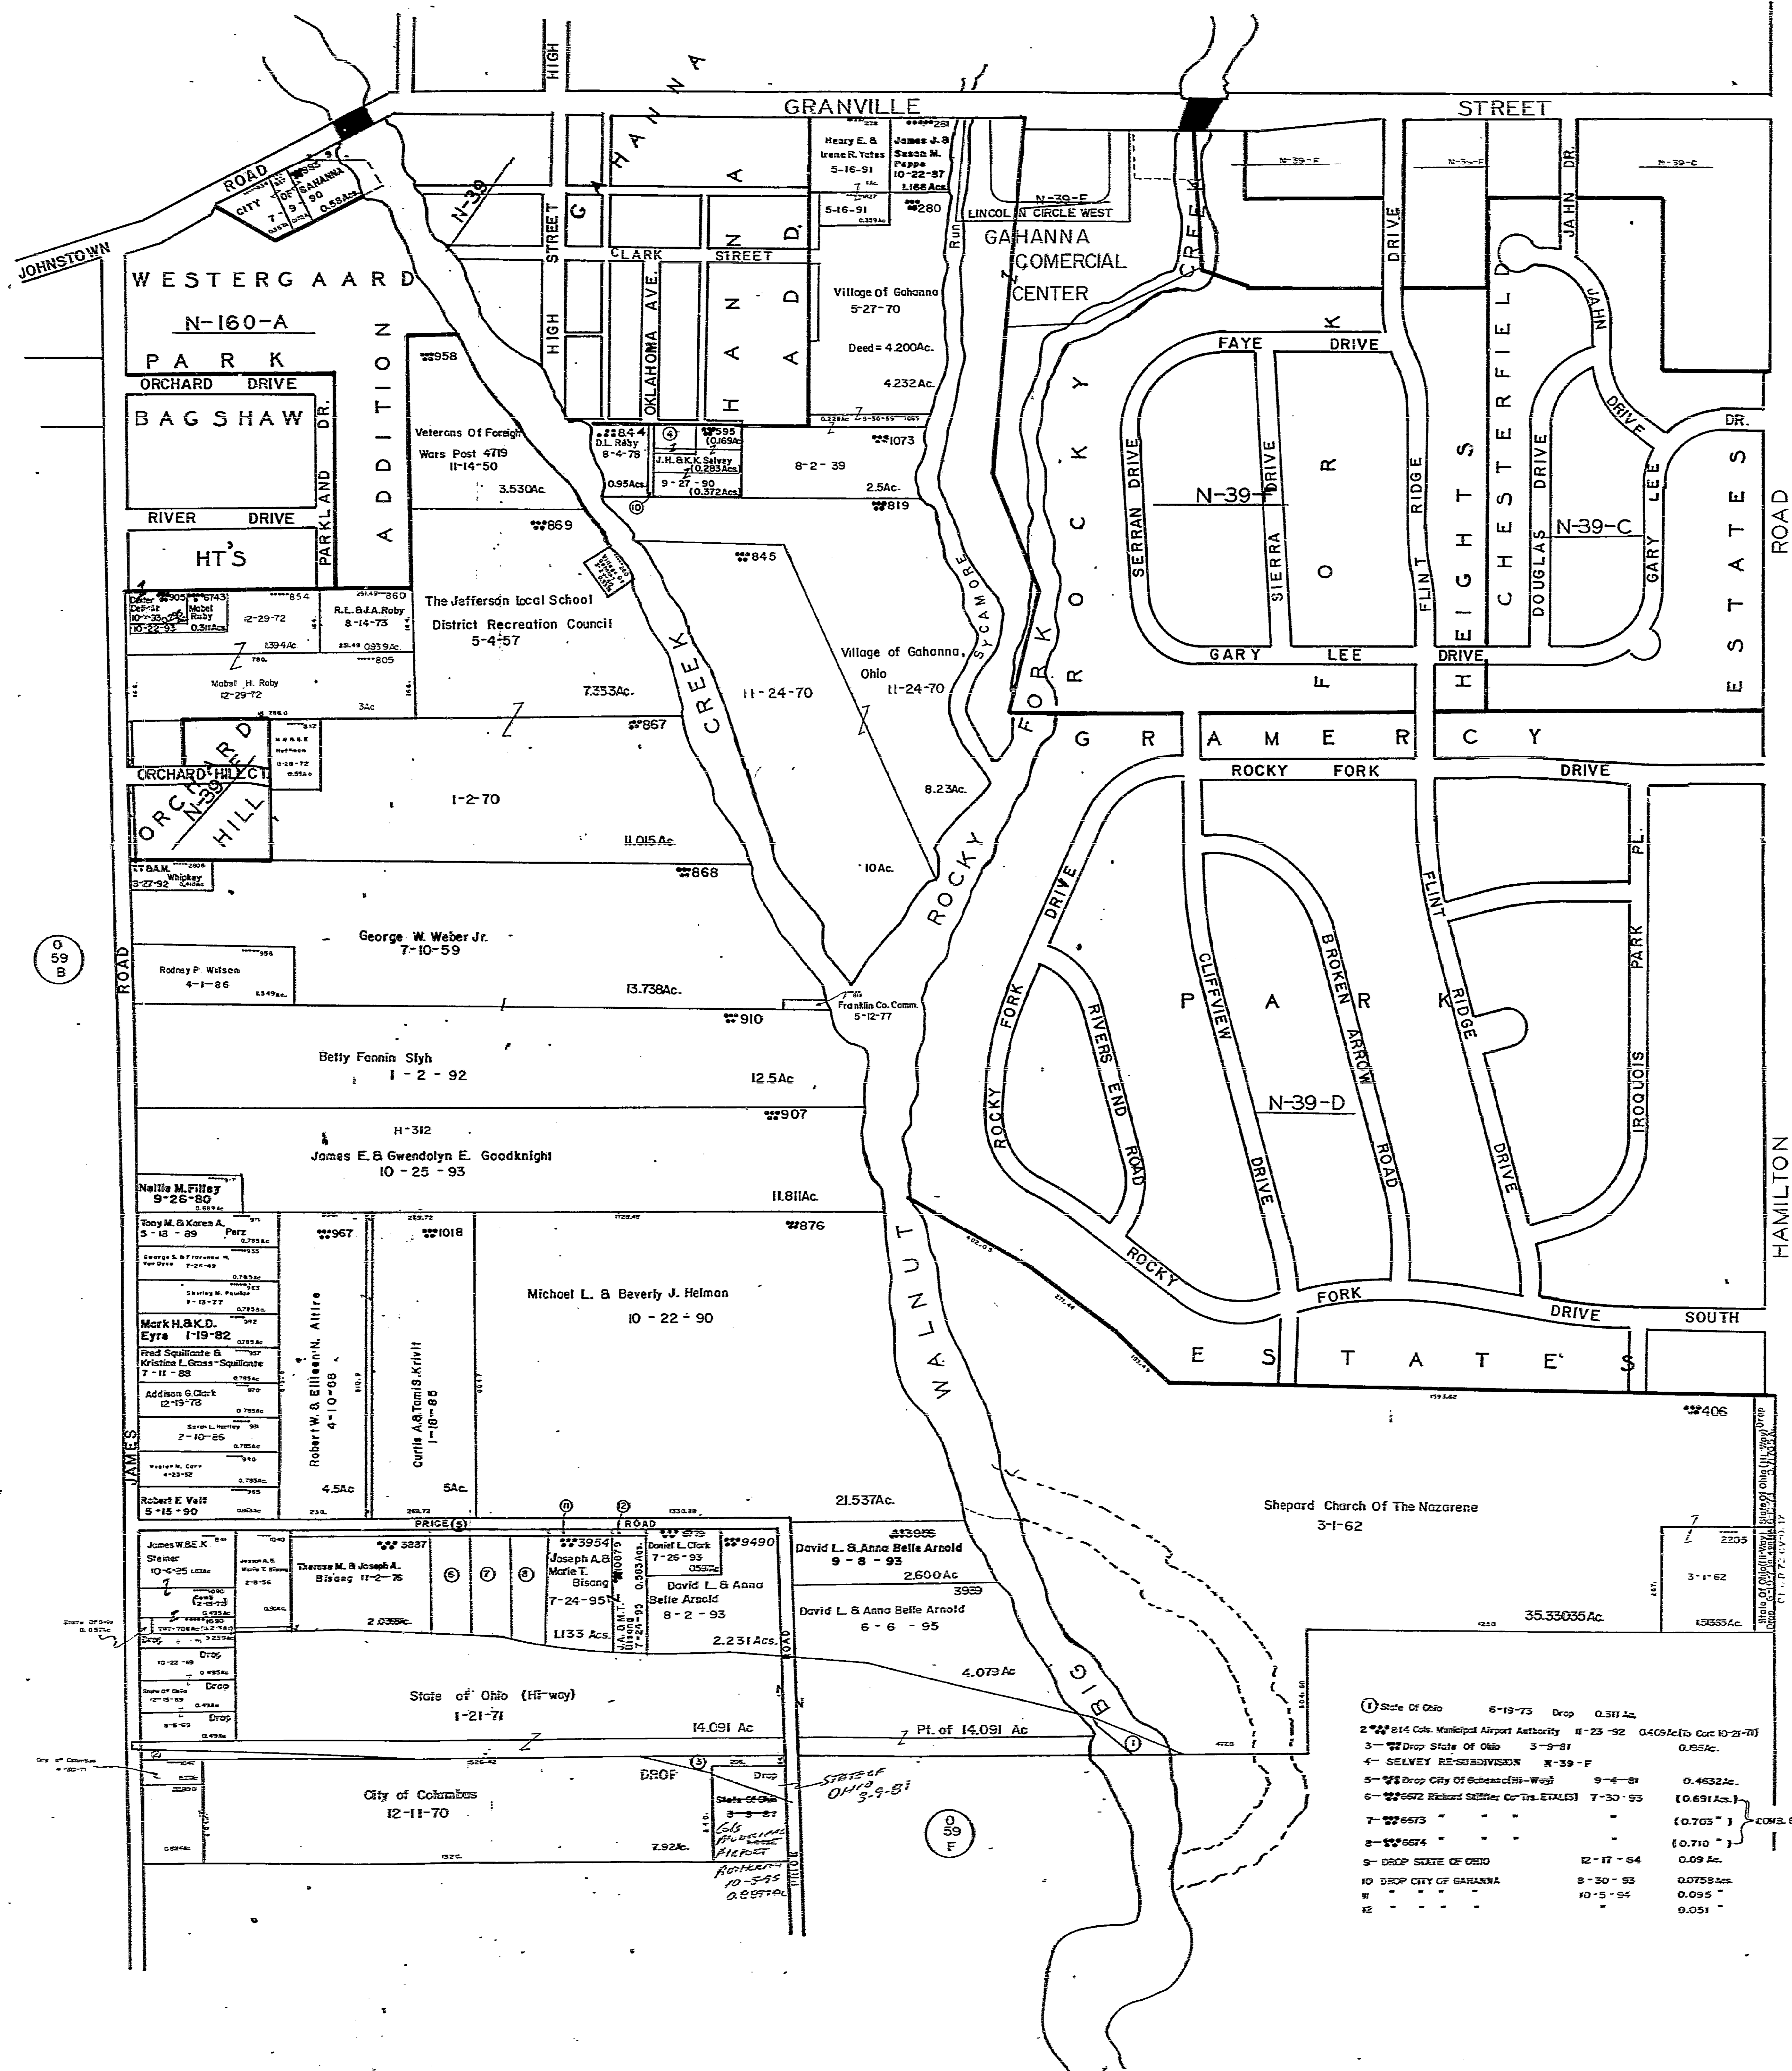

1	State of Ohio	6-19-73	Drop	0.511 Ac.
2	814 Cos. Municipal Airport Authority	11-23-92	0.409 Ac. (Cor. 10-21-71)	0.85 Ac.
3	Drop State of Ohio	3-9-81		0.85 Ac.
9	DROP STATE OF OHIO	12-17-64		0.09 Ac.
10	DROP CITY OF GAHANNA	8-30-93		0.0758 Ac.
11		10-5-95		0.095 "
12				0.051 "


0-59-C  
 [Stamp]