


O-59-H  
MIFFLIN TWR  
R.17 TWR I

SCALE 1" = 200'  
E=HIGHWAY EASEMENT  
TAXING DISTRICT DISTRICT CODE  
COLUMBUS 010  
WHITEHALL 090

THE COFFMAN FAMILY PARTNERSHIP  
① 96152 B&O RR 7-22-42 (11.41 Ac) 0.326 Ac.  
② 96144 CAPRAIL I INC. 4-16-92 0.17 Ac.  
95448 B&O R.R. 0.17 Ac.

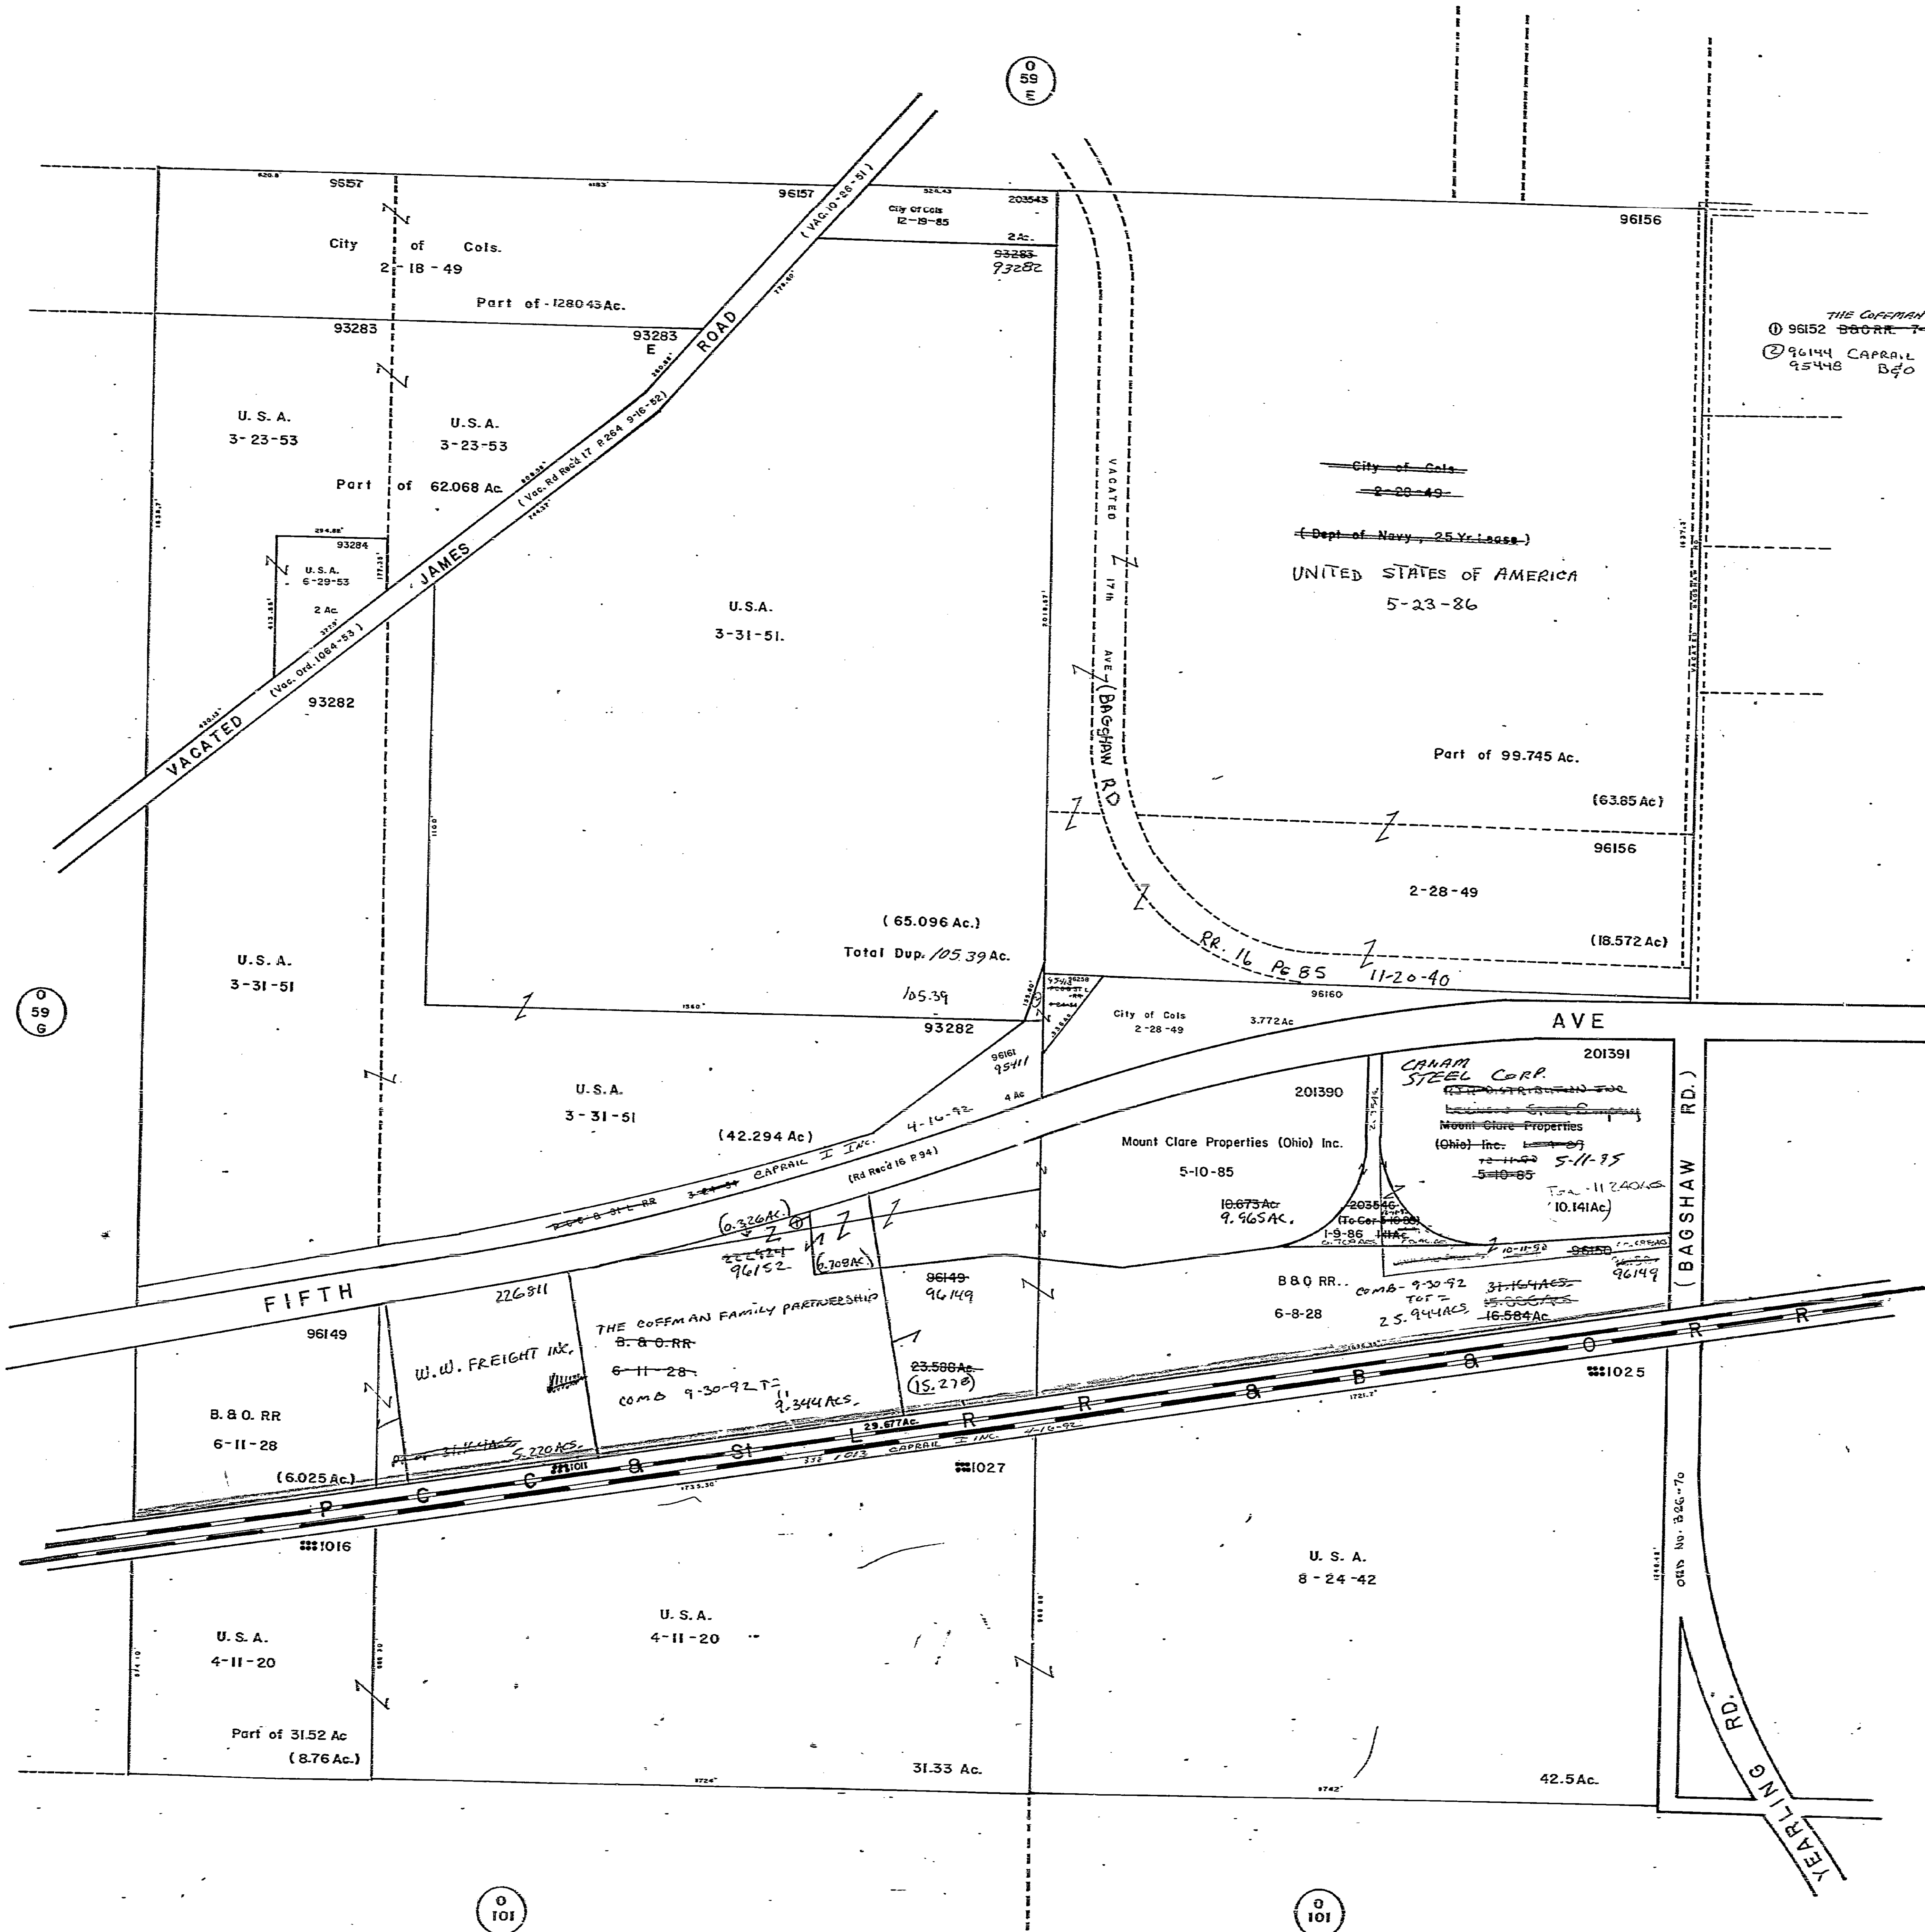

O 59 G

O 59 J

O 101

O 101

O-59-H