

0-59-J

MIFFLIN TWP  
R.17 TWP.1



SCALE 1"=200'  
E=HIGHWAY EASEMENT  
TAXING DISTRICT DISTRICT CODE  
COLUMBUS 010  
\*\*\*WHITEHALL 090  
H---HOUSE NUMBERS


0  
39  
6

T W P.

J E F F E R S O N

- 1) 192063 CITY OF COLS. 12-30-82 0.010 AC.
- 2) 192062 " " " " 0.19 AC.

0-59-J

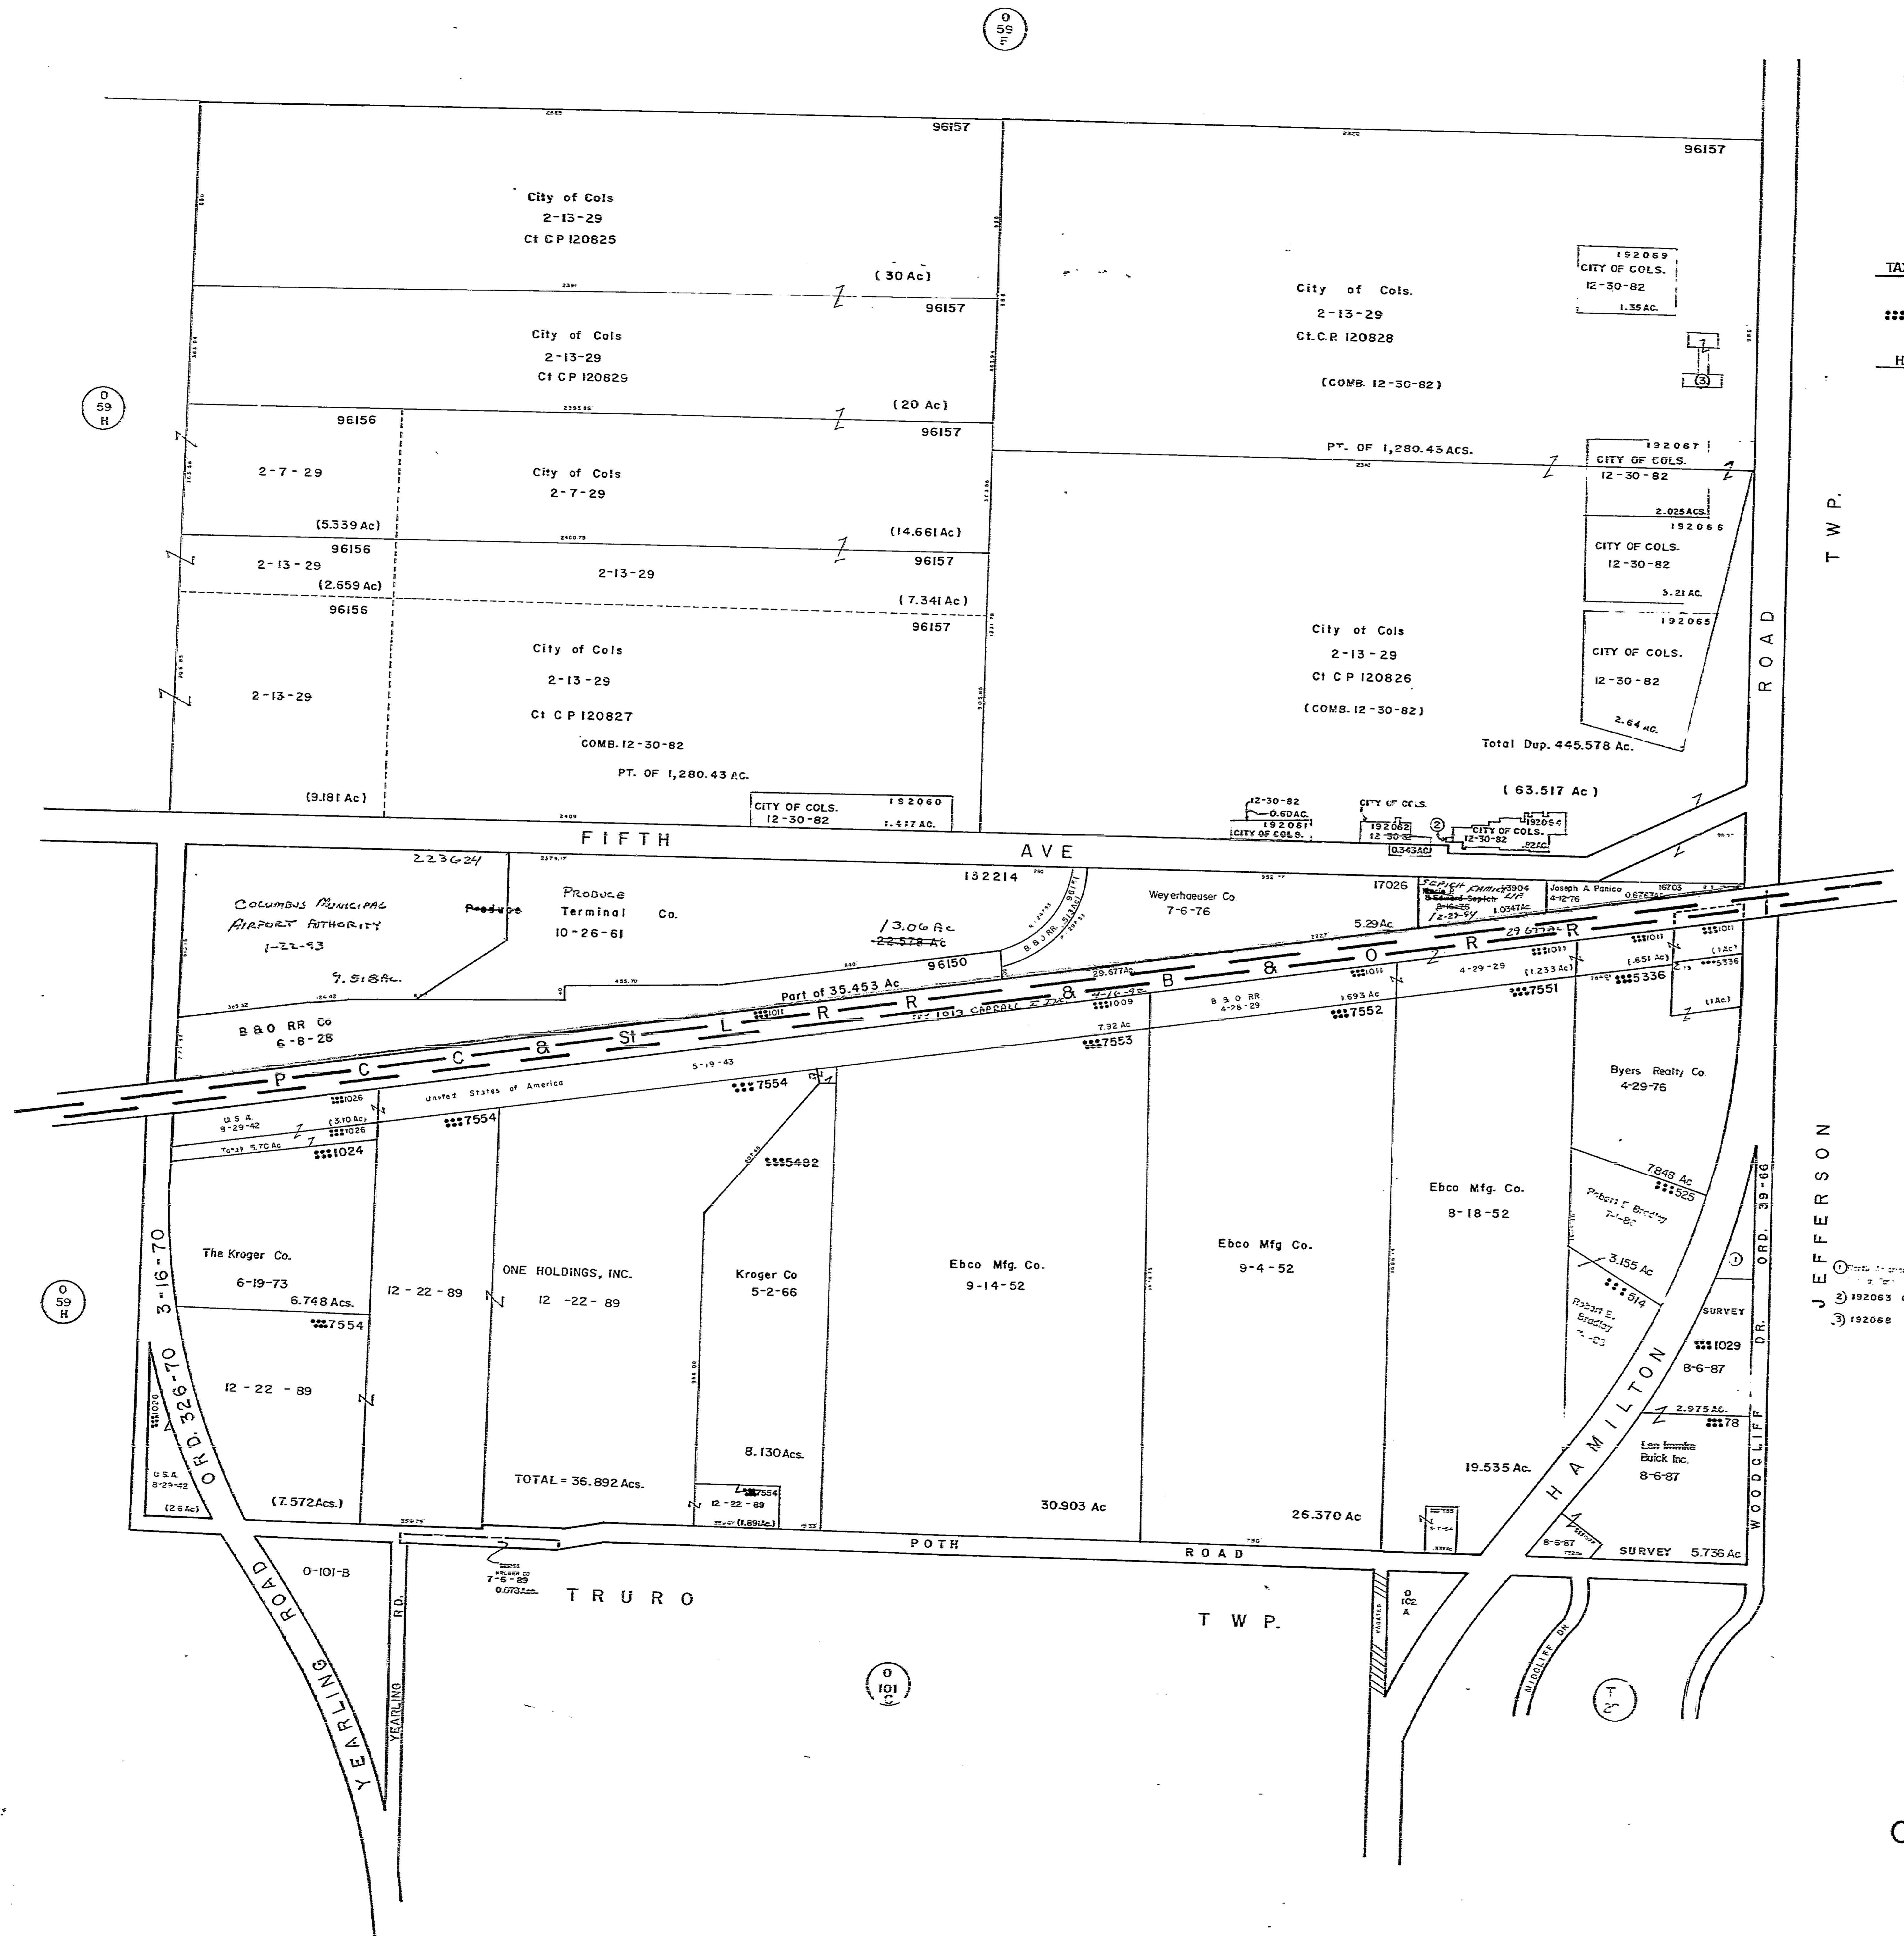

0  
59  
H

0  
59  
H

0  
101  
C

0  
5  
T

02/14/90