


SCALE 1"=200'
E=HIGHWAY EASEMENT
V.M.S.

TAXING DISTRICT 200
DISTRICT CODE 050
CITY OF HILLIARD
H-HOUSE NUMBERS

FRANKLIN COUNTY SURVEY MONUMENTS

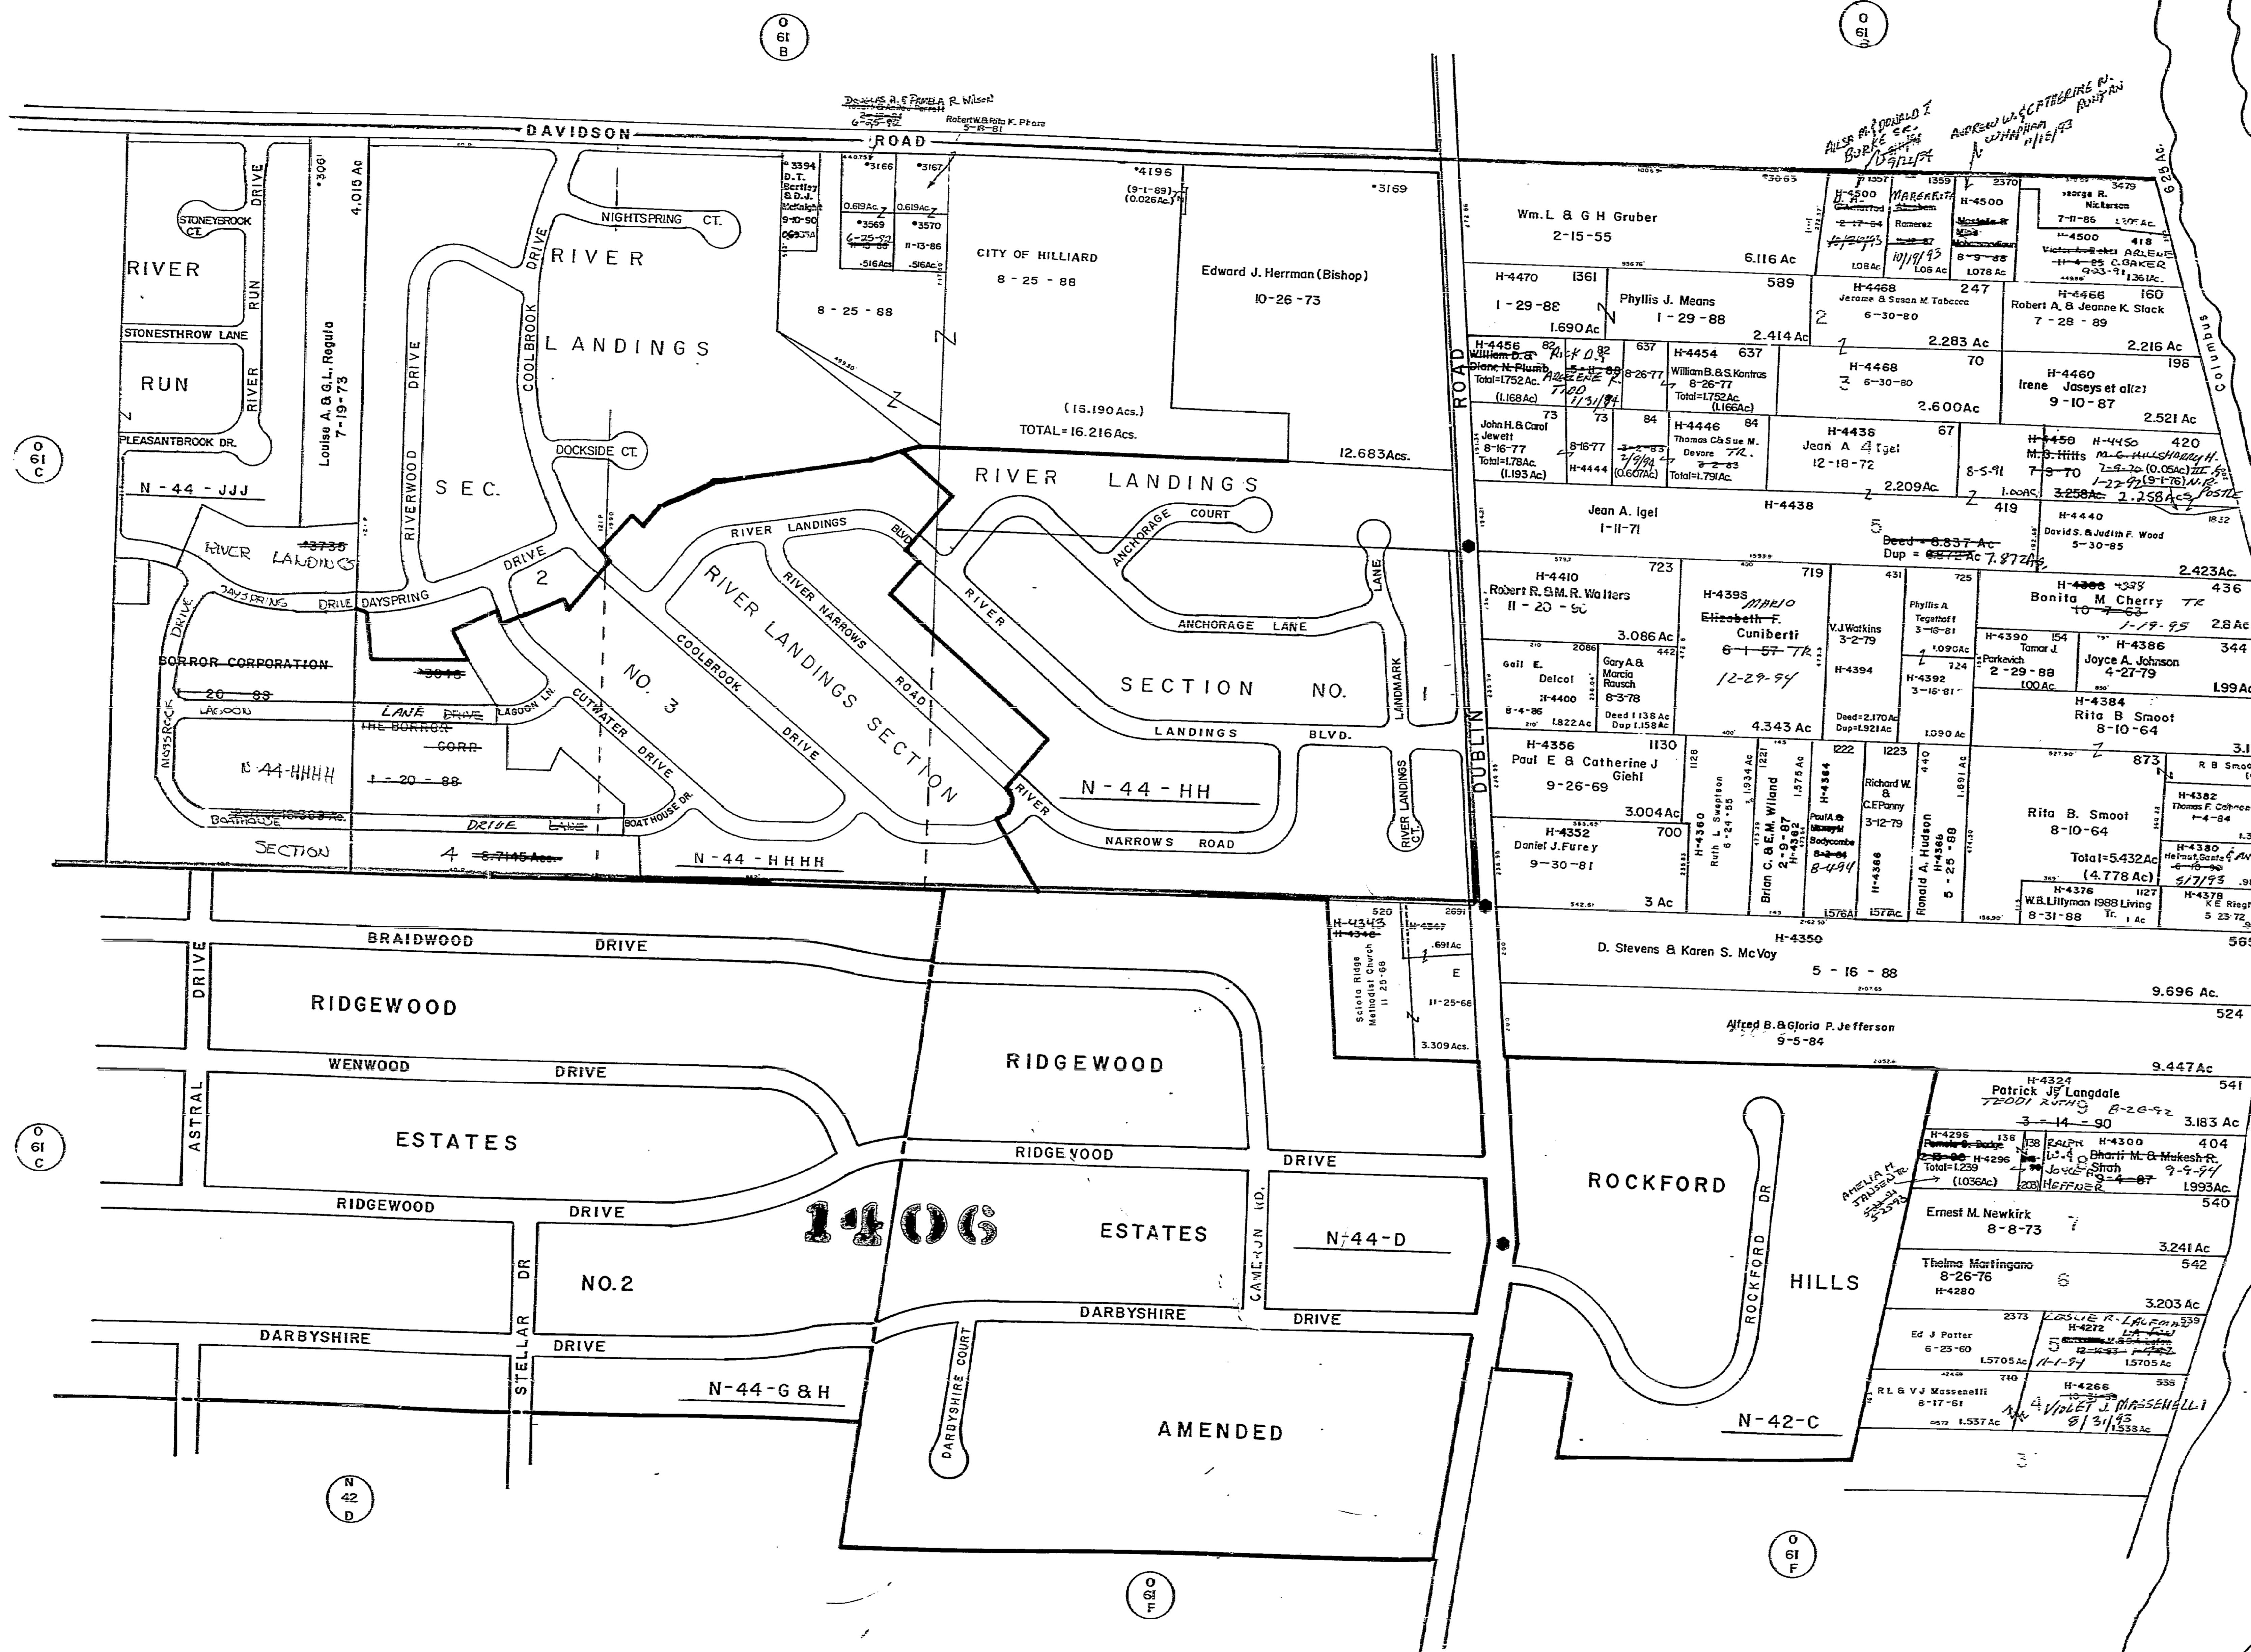

TOWNSHIP
PERRY