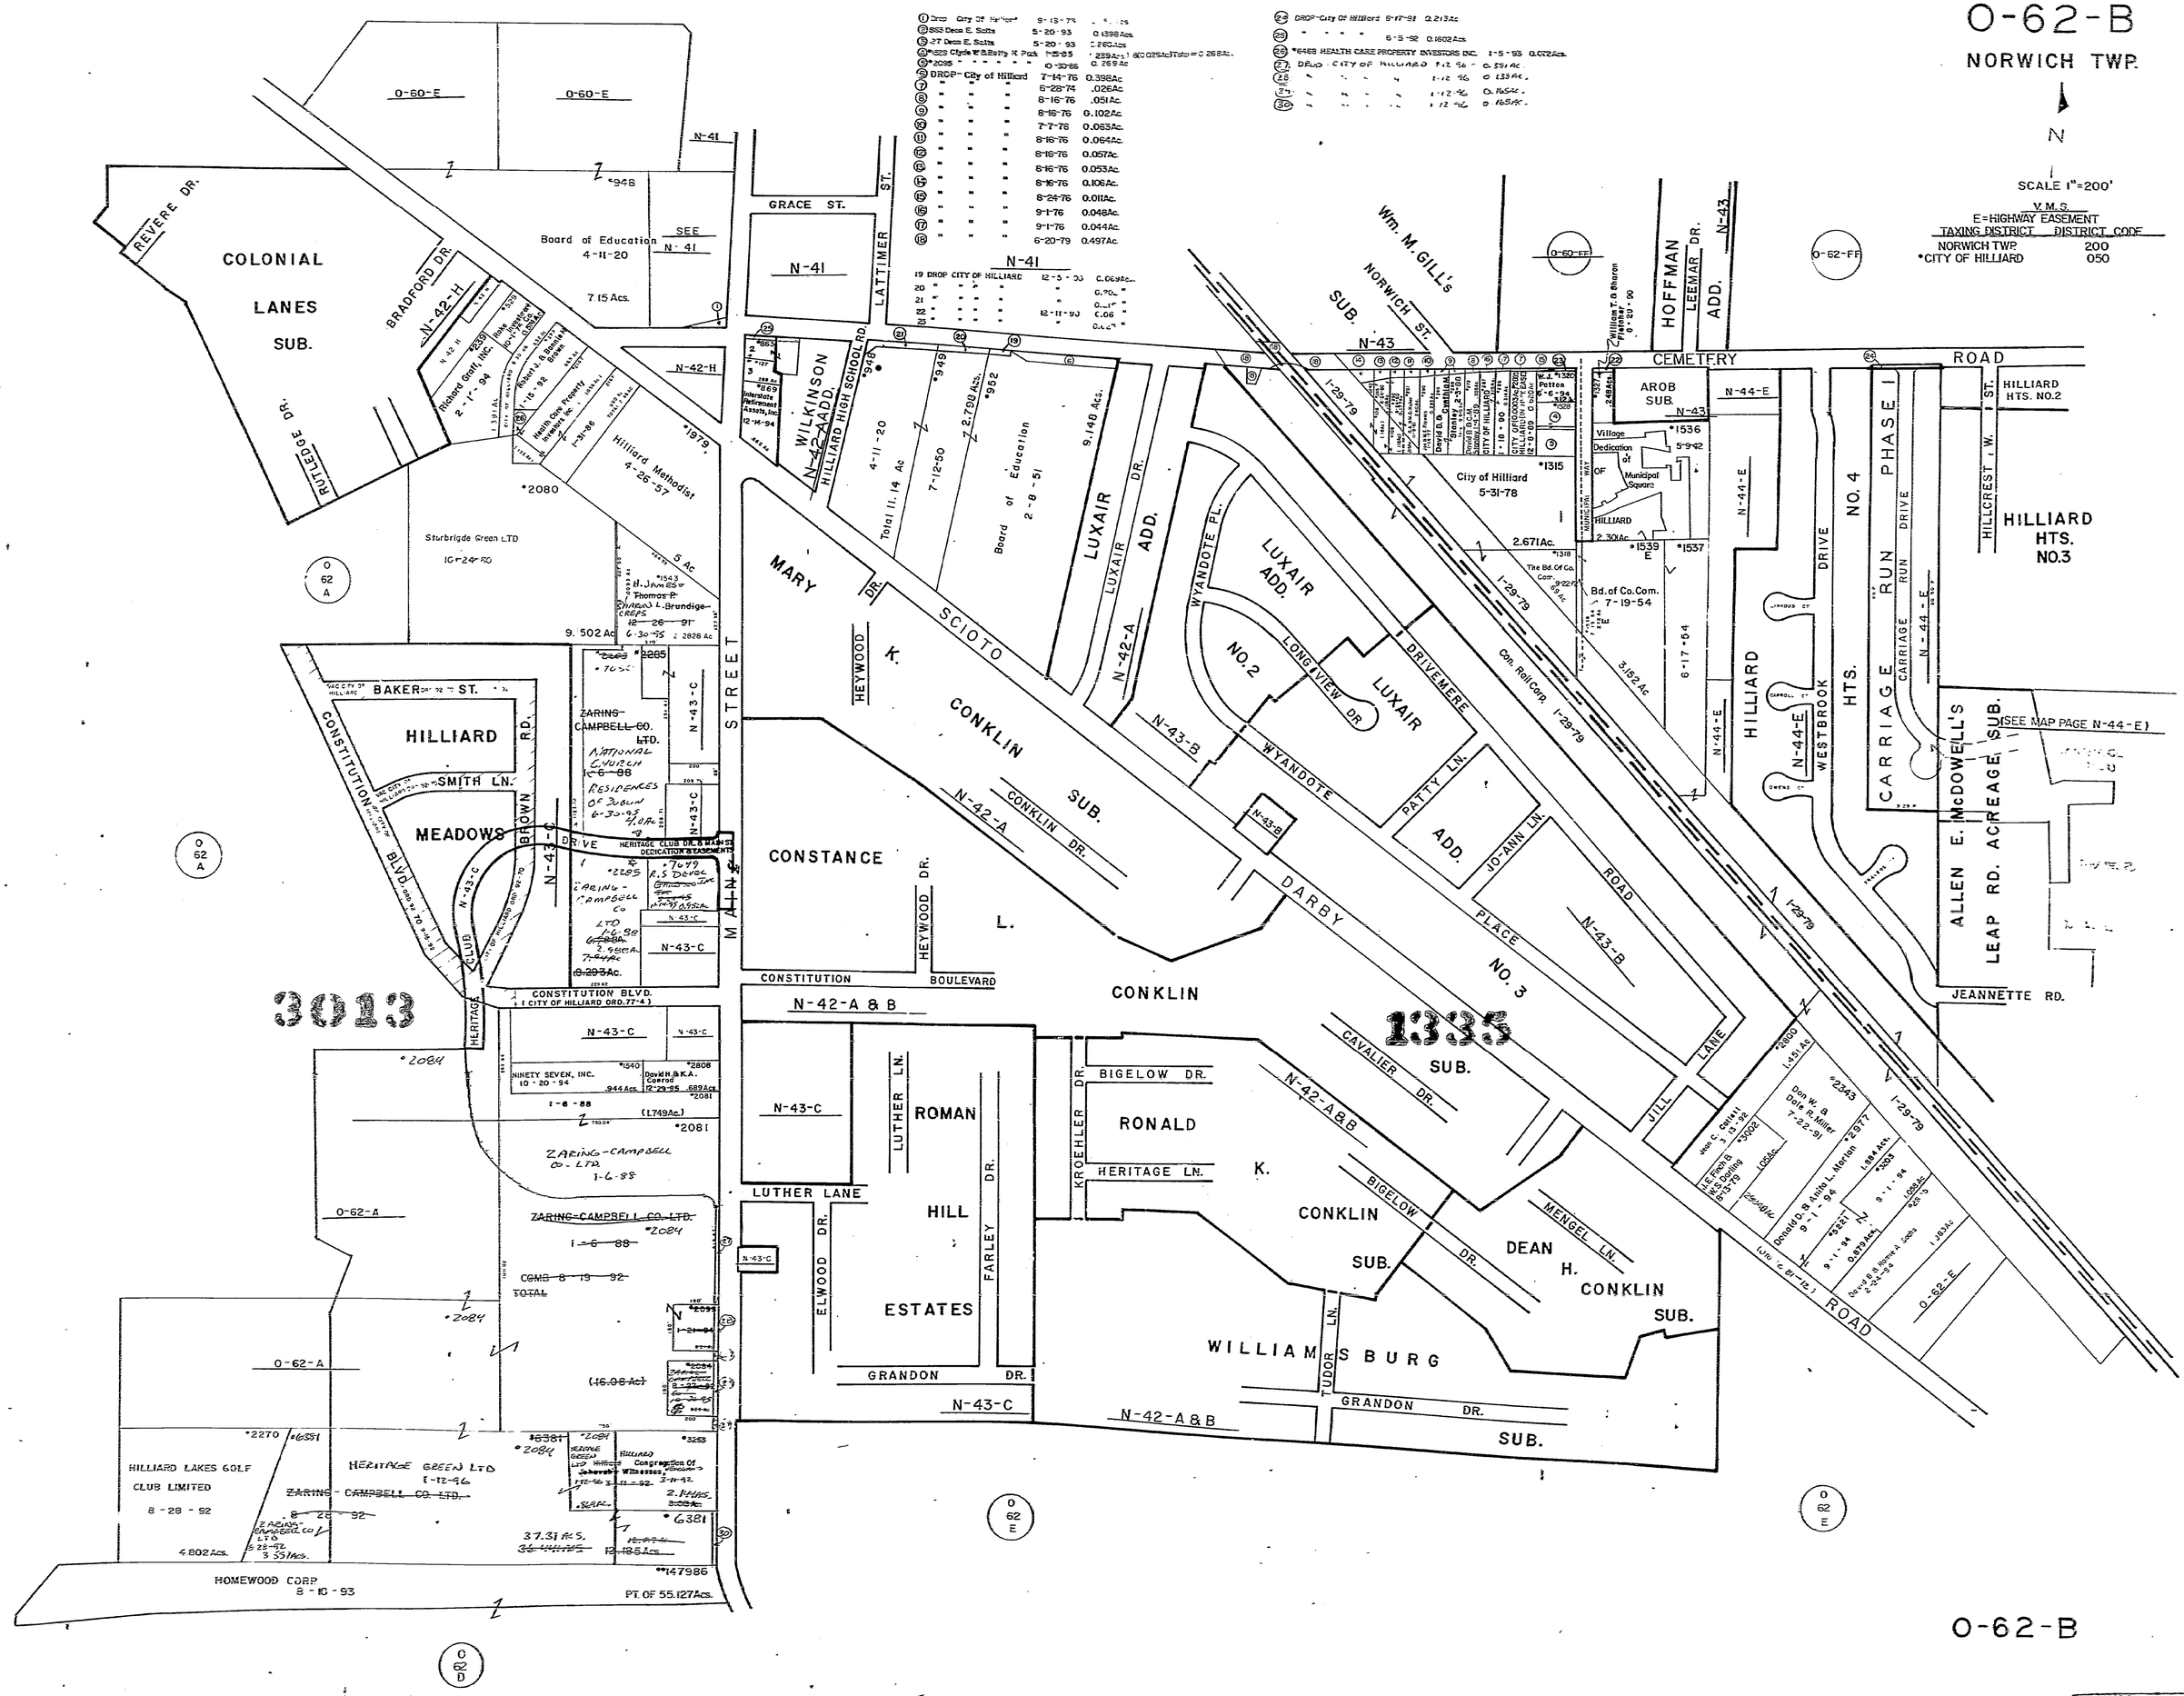
O-62-B
NORWICH TWP.
N
SCALE 1"=200'
V.M.S.
E=HIGHWAY EASEMENT
TAXING DISTRICT DISTRICT CODE
NORWICH TWP. 200
*CITY OF HILLIARD 050
COLONIAL LANES SUB.
REVERE DR.
BRADFORD DR.
RUTLEDGE DR.
Board of Education 4-11-20
7.15 Acs.
GRACE ST.
LATTIMER ST.
WILKINSON ADD.
HILLIARD HIGH SCHOOL RD.
Hilliard Methodist 4-26-57
Sturbridge Green LTD
MARY K. CONKLIN SUB.
SCIOTO STREET
LUXAIR ADD.
LUXAIR DR.
WYANDOTE PL.
LONGVIEW DR.
WYANDOTE
DRIVEMERE
PATTY LN.
JO-ANN LN.
DARBY PLACE
CONKLIN DR.
HEYWOOD DR.
CONSTANCE
CONSTITUTION BOULEVARD
CONSTITUTION BLVD.
HERITAGE CLUB
BROWN RD.
SMITH LN.
BAKER ST.
HILLIARD MEADOWS
Wm. M. GILL'S SUB.
NORWICH ST.
HOFFMAN ADD.
LEEMAR DR.
CEMETERY ROAD
AROB SUB.
Village Dedication of Municipal Square
City of Hilliard 5-31-78
Bd. of Co. Com. 7-19-54
Con. Rail Corp.
HILLIARD HTS. NO.2
HILLIARD HTS. NO.3
HILLCREST DR.
CARRIAGE RUN PHASE I
CARRIAGE RUN DRIVE
HILLIARD HTS. NO. 4
WESTBROOK DR.
(SEE MAP PAGE N-44-E)
ALLEN E. McDOWELL'S LEAP RD. ACREAGE SUB.
JEANNETTE RD.
RONALD K. CONKLIN SUB.
BIGELOW DR.
CAVALIER DR.
HERITAGE LN.
KROEHLER DR.
LUTHER LN.
ROMAN HILL ESTATES
FARLEY DR.
ELWOOD DR.
LUTHER LANE
GRANDON DR.
WILLIAMSBURG SUB.
TUDOR LN.
DEAN H. CONKLIN SUB.
MENGEL LN.
JILL LANE
ROAD
HILLIARD LAKES GOLF CLUB LIMITED 8-28-92
HERITAGE GREEN LTD 1-12-96
HOMEWOOD CORP 8-10-93
PT. OF 55.127Acs.
O-62-B