


**O-66-D**  
 PERRY TWP.  
 R.19. TWP. I.

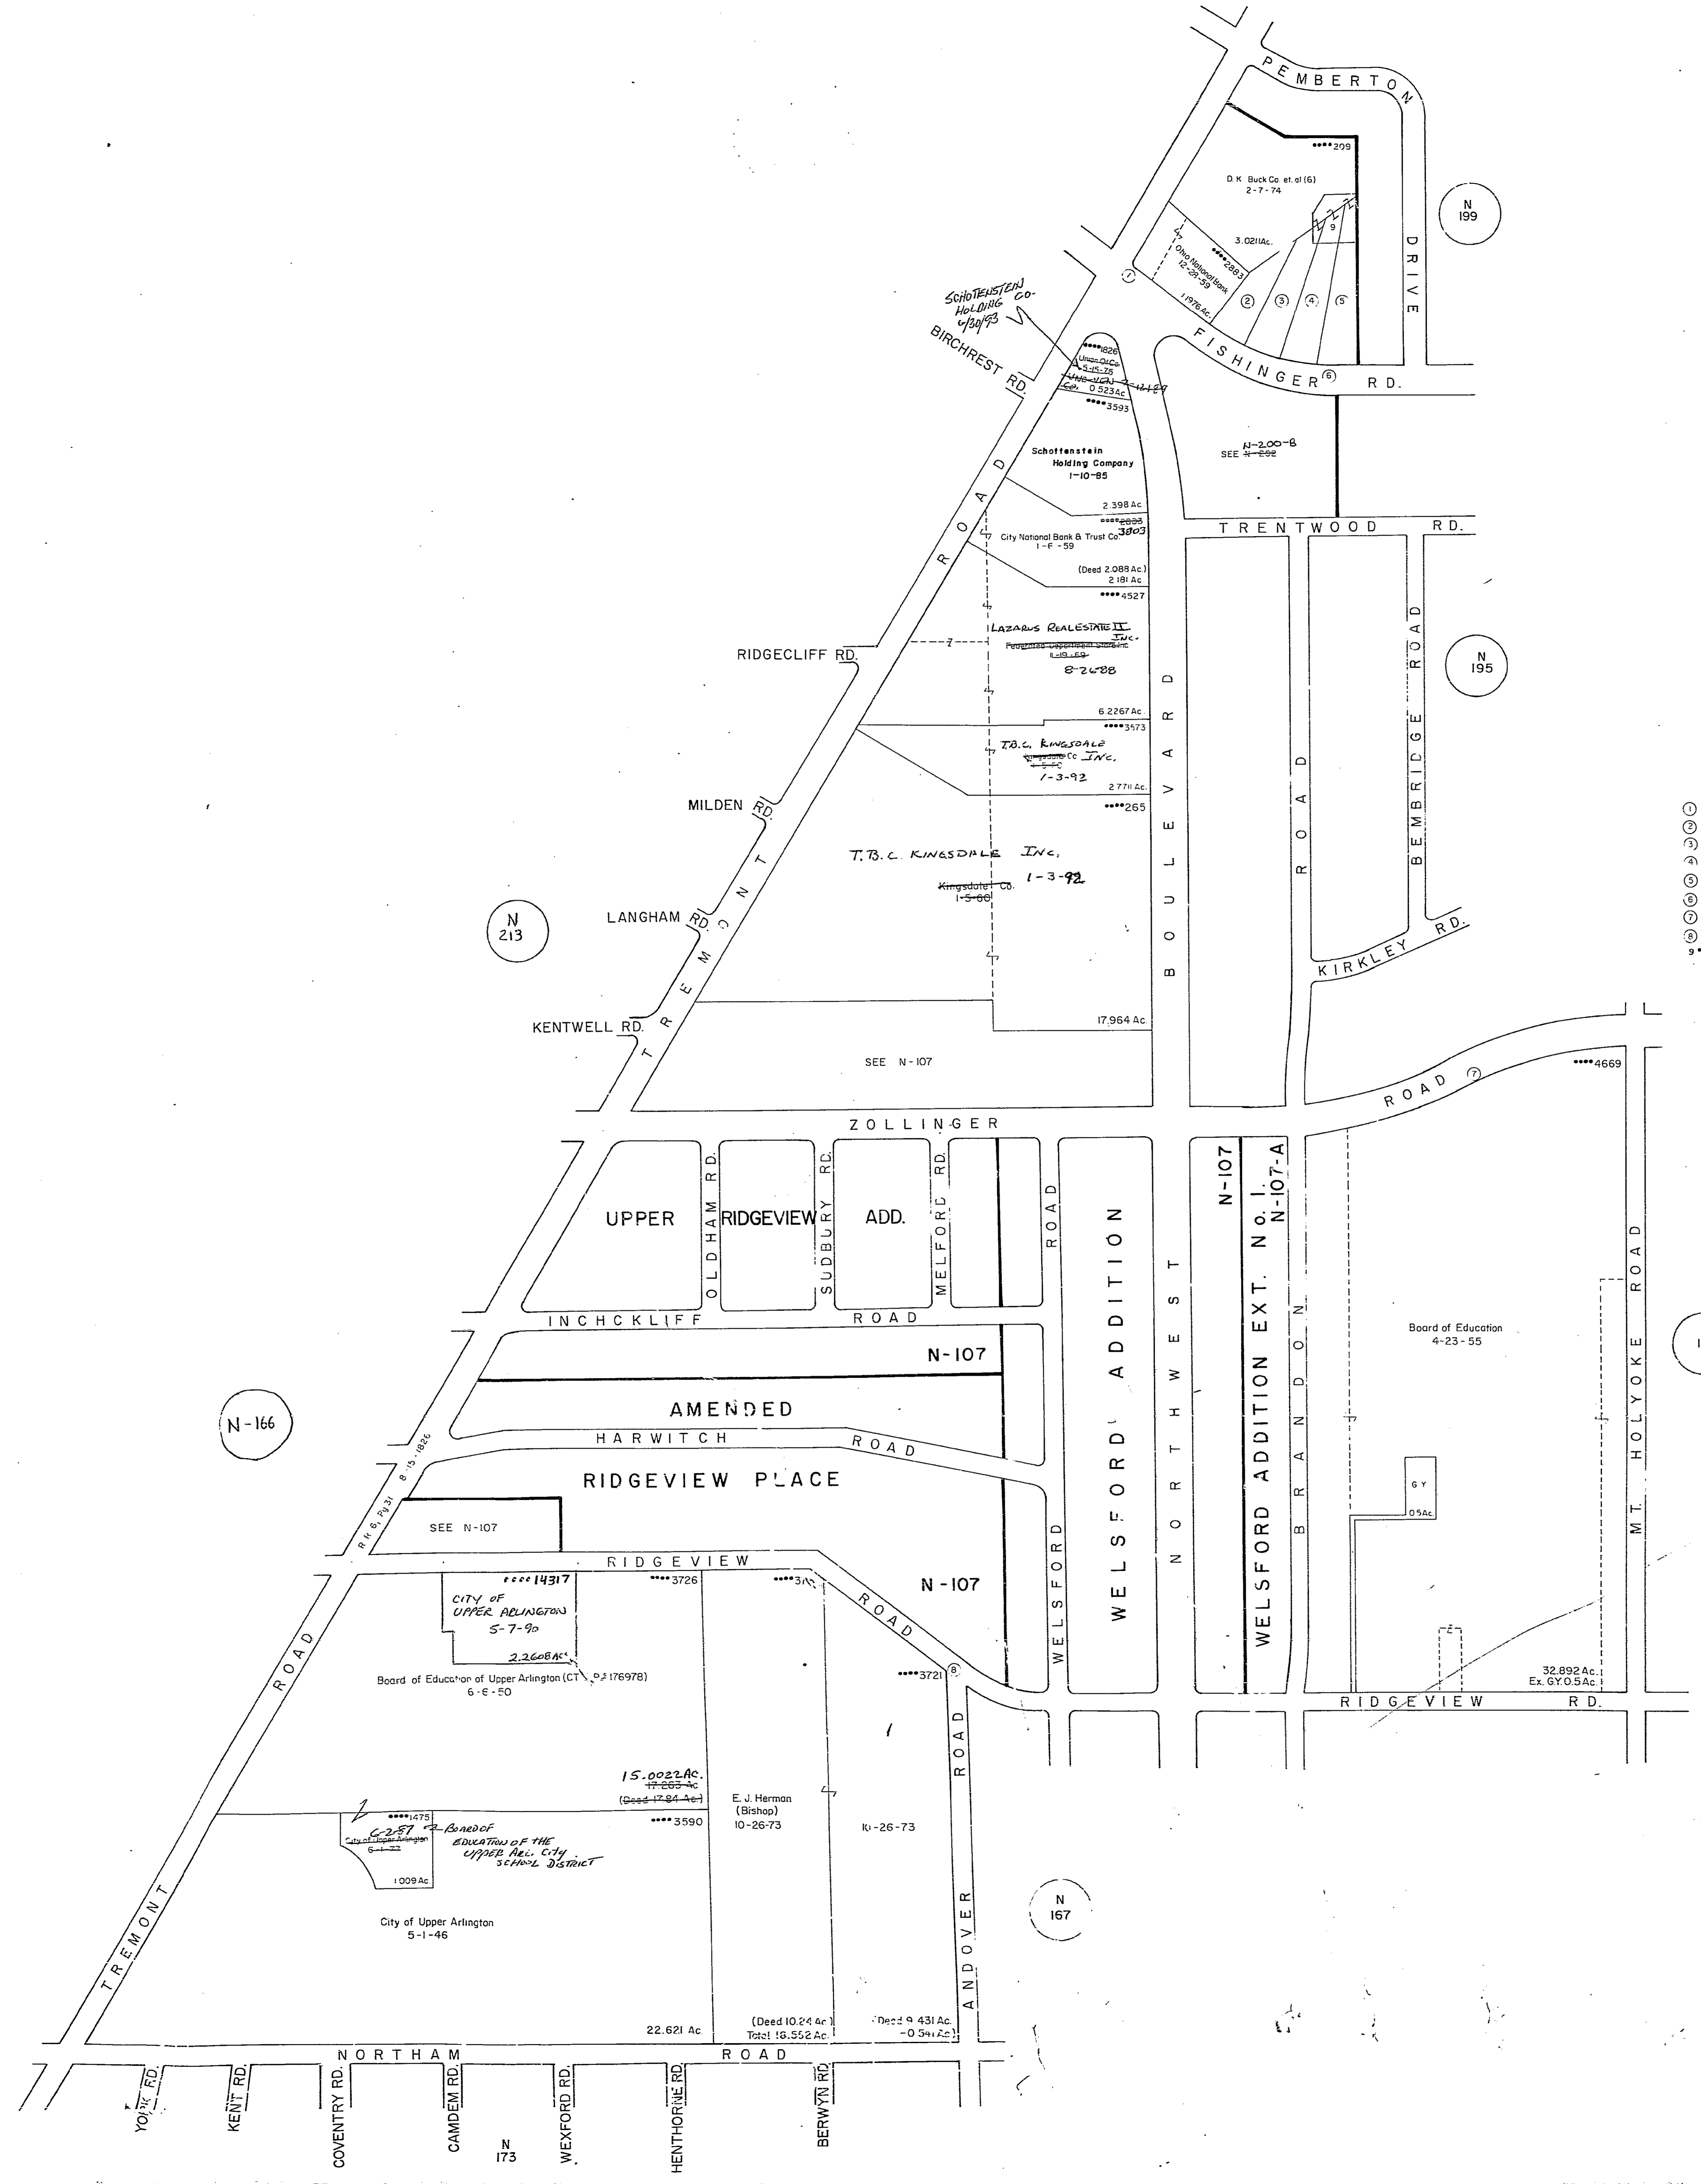

SCALE: 1"=200'  
 E = HI-WAY EASEMENT  
 TAXING DISTRICT DISTRICT CODE  
 \*\*\*\*\*UPPER ARLINGTON 070



1	DRDP City of Upper Arlington	8-27-70	0.0024 Ac.
2	****7662 Daniel K. Bush	4-9-72	6.1838 Ac.
3	****7672 Daniel K. Bush	12-23-71	0.6429 Ac.
4	****2691 " " " "	4-23-73	0.9487 Ac.
5	****7735 " " " "	11-23-74	0.6151 Ac.
6	DRDP City of Upper Arlington	8-4-60	0.9372 Ac.
7	DRDP " " " "	10-4-55	3.379 Ac.
8	DRDP " " " "	12-18-48	0.92 Ac.
9	****13851 Daniel K. Bush	4-11-78	0.1517 Ac.

**O-66-D**  
 107  
 11/12/65