0-70-FF

PERRY TWP.
R.19 TWP.2

N

SCALE 1" = 100
E=HIGHWAY EASEMENT

TAXING DISTRICTS	DISTRICTS CODE
PERRY-WORTH S.D.	213
••CITY OF COLUMBUS	010
∴ COLS. WORTH S.D.	610
::::CITY OF WORTH	100

H---HOUSE NUMBERS

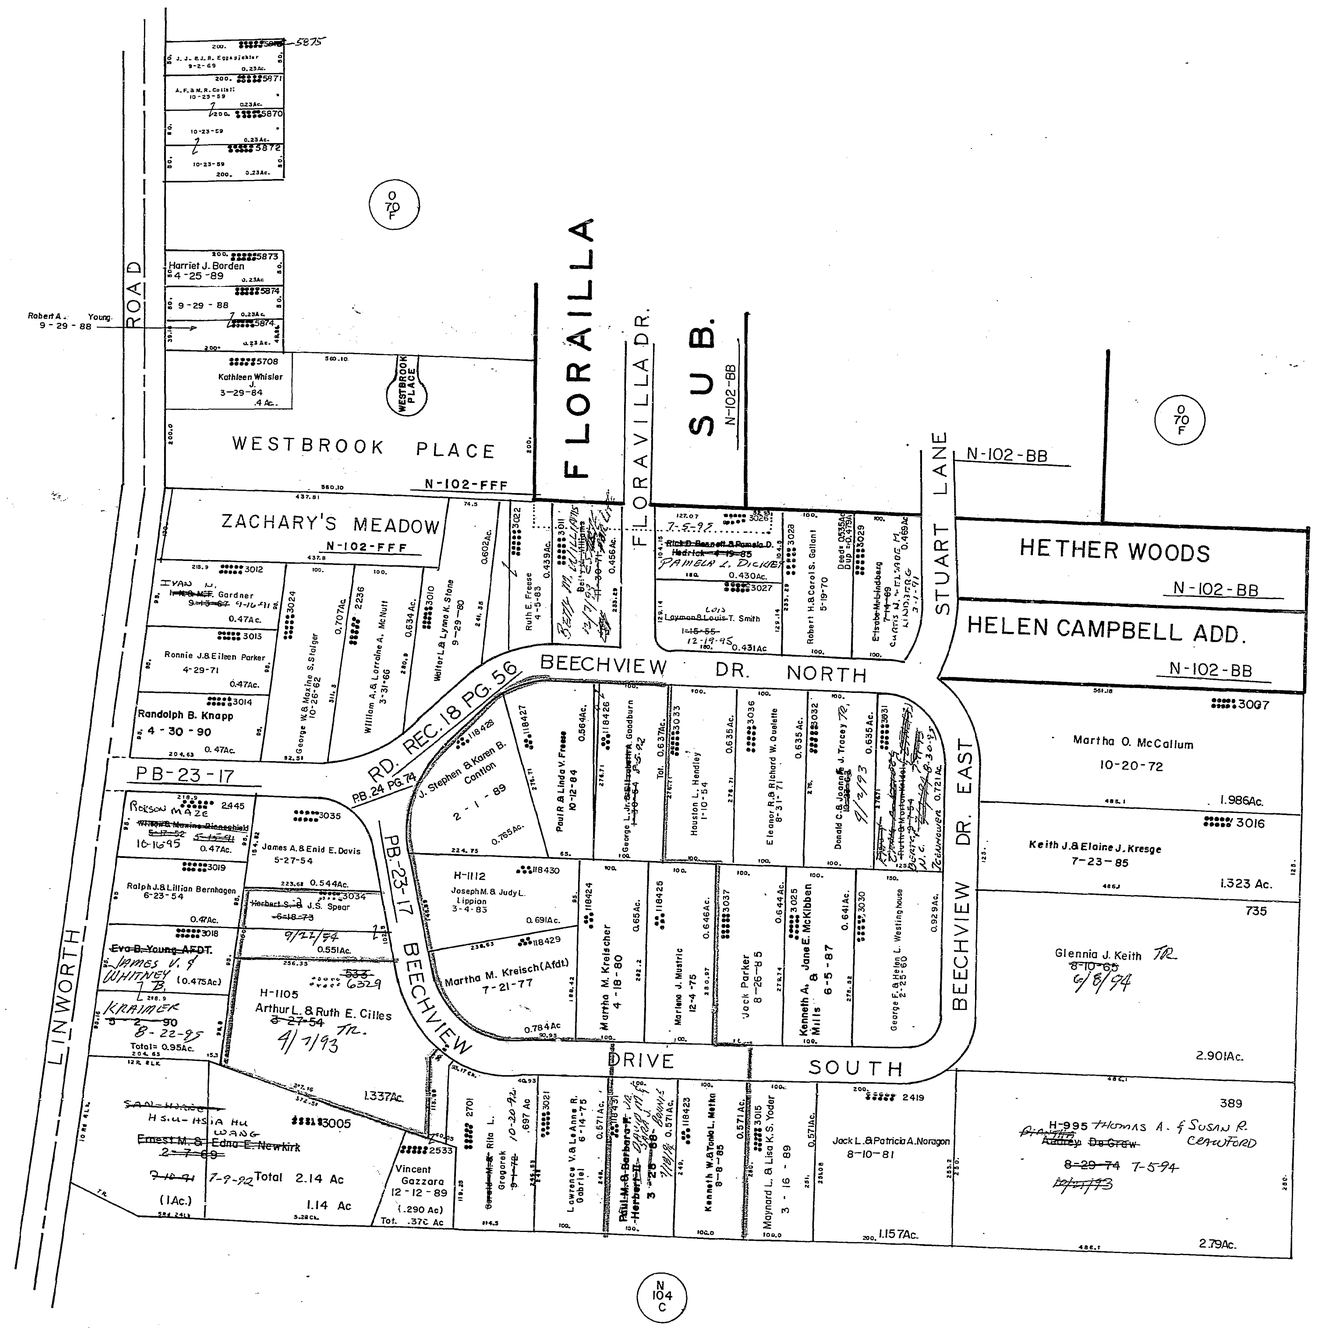
LINWORTH ROAD
WESTBROOK PLACE
N-102-FFF
ZACHARY'S MEADOW
N-102-FFF
FLORAILLA
FLORAVILLA DR.
SUB.
N-102-BB
STUART LANE
N-102-BB
HETHER WOODS
N-102-BB
HELEN CAMPBELL ADD.
N-102-BB
BEECHVIEW DR. NORTH
RD. REC. 18 PG. 56
PB. 24 PG. 74
PB-23-17
BEECHVIEW DRIVE SOUTH
BEECHVIEW DR. EAST
Robert A. Young 9-29-88
Harriet J. Borden 4-25-89
9-29-88
Kathleen Whisler 3-29-84
Gardner
Ronnie J.& Eileen Parker 4-29-71
Randolph B. Knapp 4-30-90
Robson Mace
James A.& Enid E. Davis 5-27-54
Ralph J.& Lillian Bernhagen 6-23-54
Eva B. Young AFDT.
James V. & Whitney B. Kramer 8-22-85
Total= 0.95Ac.
H-1105 Arthur L.& Ruth E. Cilles
H-1112 Joseph M.& Judy L. Lippian 3-4-83
Martha M. Kreisch(Afdt) 7-21-77
Martha M. Kreischer 4-18-80
Martha O. McCallum 10-20-72
Keith J.& Elaine J. Kresge 7-23-85
Glennia J. Keith
H-995 Thomas A. & Susan R. Crawford
Jack L.& Patricia A. Noragon 8-10-81
Vincent Gazzara 12-12-89
Total 2.14 Ac
1.14 Ac
(1Ac.)
Ernest M.& Edna E. Newkirk
Hsiu-Hsia Hu Wang
Rita L. Gregorek
Lawrence V.& LeAnna R. Gabriel
Kenneth W.& Tod L. Metin 8-8-85
Maynard L.& Lisa K.S. Yoder 3-16-89
Paul R.& Linda V. Freese 10-12-84
J. Stephen & Karen B. Conlon 2-1-89
Houston L. Hendley 11-10-54
Eleanor R.& Richard W. Ouellette 8-31-71
Donald C.& Joanne J. Tracey
Jack Parker 8-26-85
Kenneth A. & Jane E. McKibben 6-5-87
George F.& Helen L. Westinghouse 2-25-80
Mariana J. Nastric 12-4-75
Robert H.& Carol S. Gallant 5-19-70
Lyman & Louis T. Smith
Elmore M.& Lindsay 3-17-77
0.430Ac.
0.431Ac.
0.635Ac.
0.721Ac.
1.986Ac.
1.323 Ac.
735
2.901Ac.
389
2.79Ac.
1.157Ac.
1.337Ac.
0.47Ac.
0.47Ac.
0.47