


DELAWARE COUNTY

0-71-B

PERRY TWP  
R 19 TWP 2

SCALE 1" = 200'  
E=HIGHWAY EASEMENT  
TAXING DISTRICTS DISTRICTS CODE

FRANKLIN COUNTY SURVEY MONUMENTS  
H---HOUSE NUMBERS

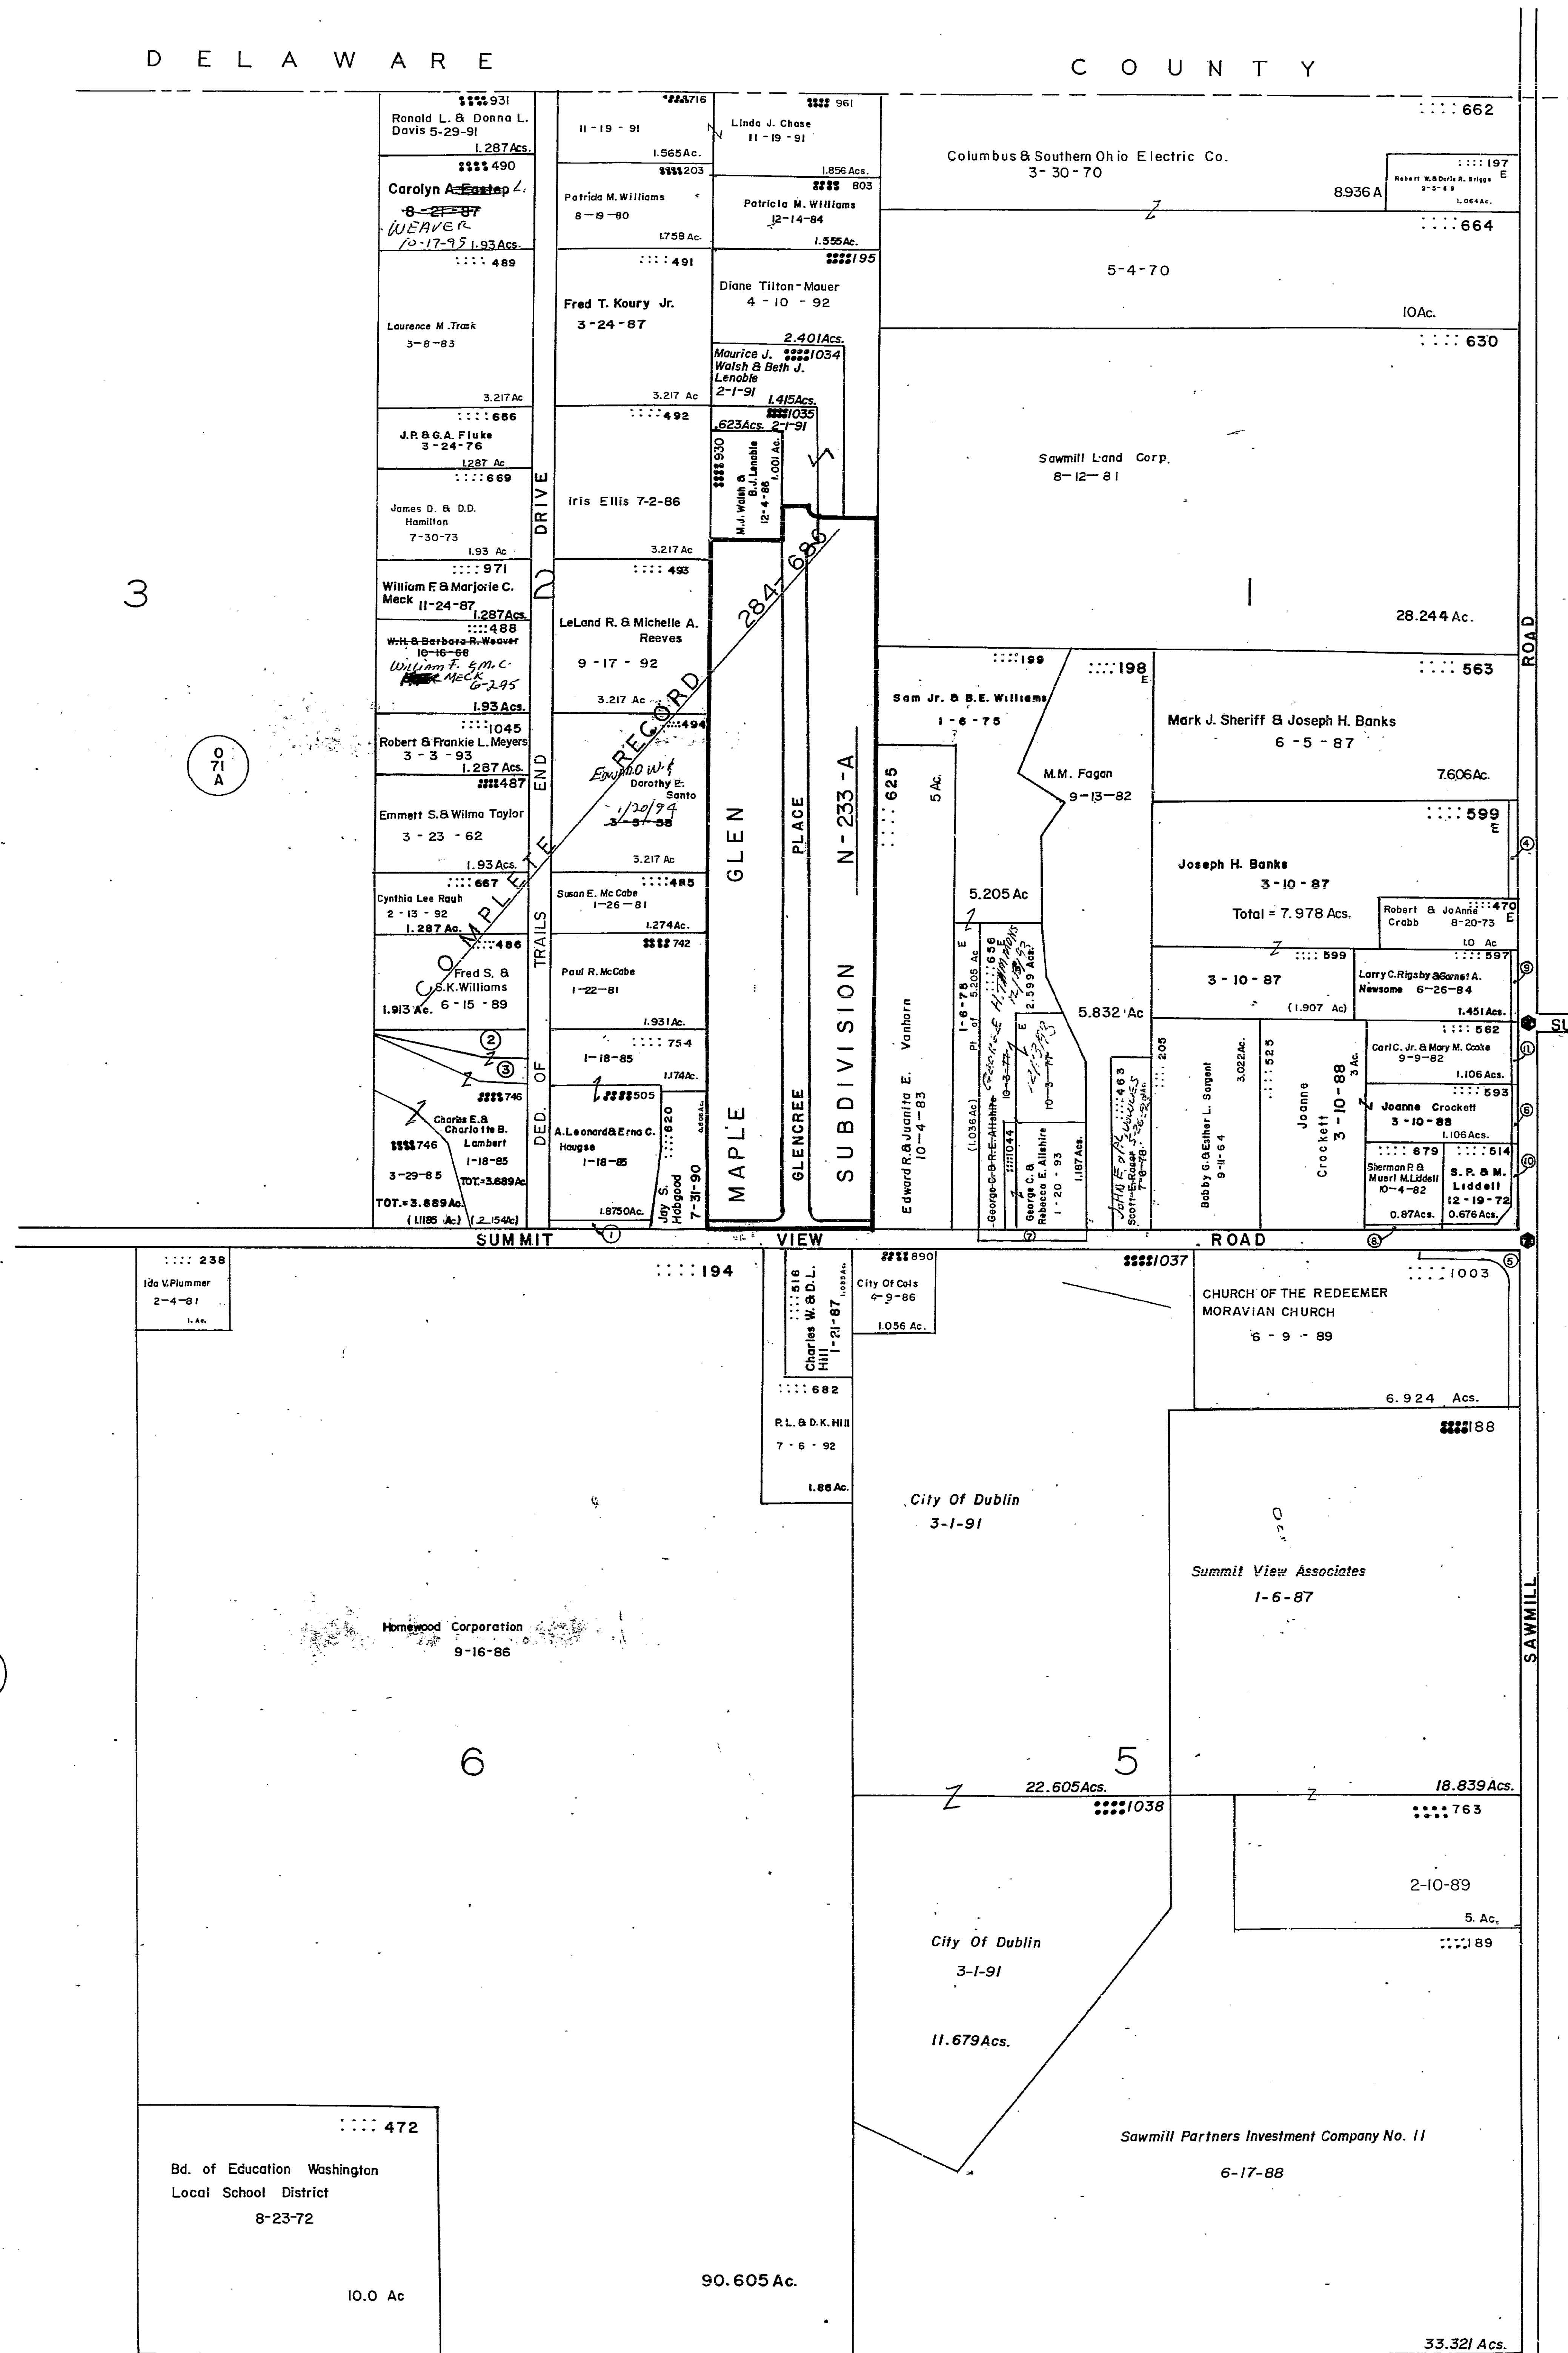

0 71 A

0 71 A

0 71 A

0 71 A

1-Drop Village Of Dublin (Hi-way)	4-27-82	0.231 Ac.
2-Drop 998 Charles E. & Charlotte B. Lambert	12-13-88	0.416 Ac.
PT OF 746 Charles E. & Charlotte B. Lambert 2-6-87 (0.416 Ac.)		
4-Drop FRANKLIN COUNTY COMMISSIONERS	10-6-92	0.222 Ac.
5-Drop " " "	10-30-92	0.576 "
6-Drop " " "	12-22-92	0.129 "
7-Drop CITY OF DUBLIN	12-11-92	0.178 "
8-Drop FRANKLIN COUNTY COMMISSIONERS	1-4-93	0.132 "
9-Drop " " "	"	0.156 "
10-Drop " " "	"	0.322 "
11-Drop " " "	1-7-93	0.129 "

0-71-B

33.321 Ac.