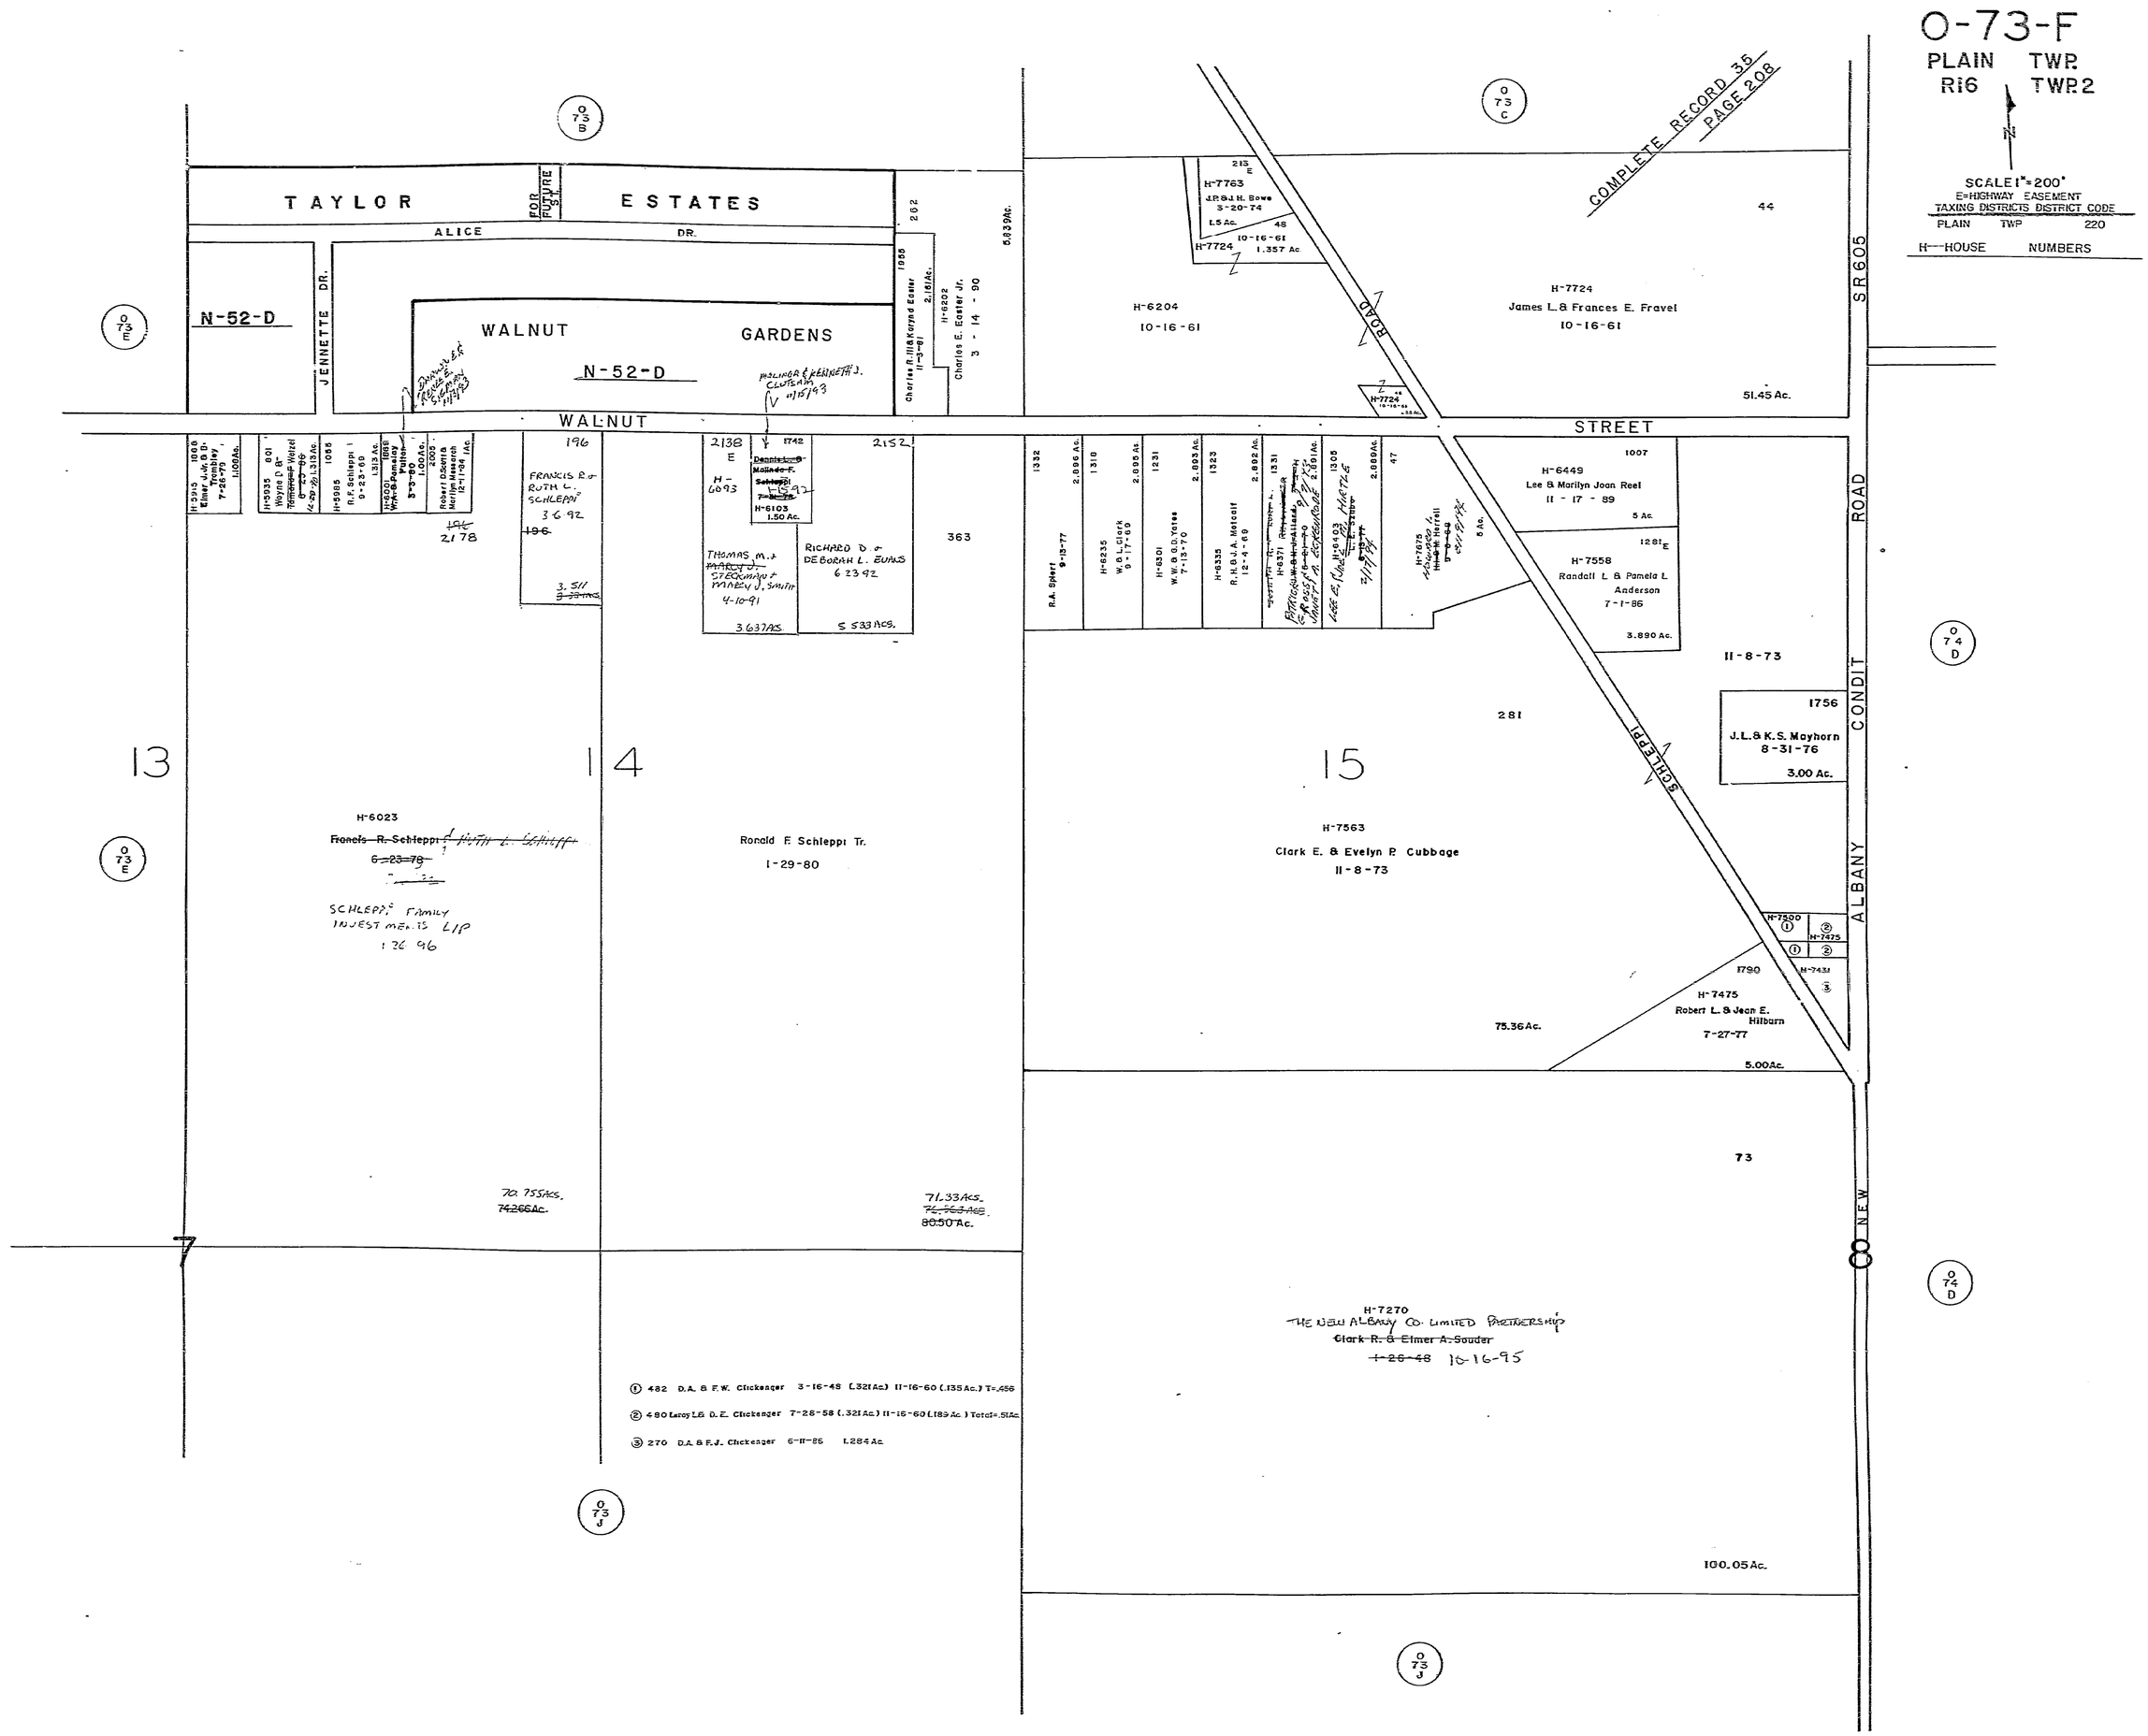
O-73-F
PLAIN TWP.
R16 TWP.2
SCALE 1"=200'
E=HIGHWAY EASEMENT
TAXING DISTRICTS DISTRICT CODE
PLAIN TWP 220
H--HOUSE NUMBERS
TAYLOR ESTATES
FOR FUTURE USE
ALICE DR.
JENNETTE DR.
N-52-D
WALNUT GARDENS
N-52-D
WALNUT STREET
COMPLETE RECORD 35 PAGE 208
SCHLEPPI ROAD
SR 605
ALBANY CONDIT ROAD
NEW
H-7763 J.P.&J.H. Bowe 3-20-74 1.5 Ac.
H-7724 10-16-61 1.357 Ac.
H-6204 10-16-61
H-7724 James L.& Frances E. Fravel 10-16-61
51.45 Ac.
H-6449 Lee & Marilyn Joan Reel 11-17-89 5 Ac.
H-7558 Randall L & Pamela L Anderson 7-1-86 3.890 Ac.
11-8-73
1756 J.L.& K.S. Mayhorn 8-31-76 3.00 Ac.
H-6093
H-6103 1.50 Ac.
FRANCIS R. & RUTH L. SCHLEPPI 3-6-92
THOMAS M. & STECKMAN & MARCY J. SMITH 4-10-91 3.637 ACS.
RICHARD D. & DEBORAH L. EVANS 6-23-92 5.533 ACS.
13
14
15
H-6023
Ronald F. Schleppi Tr. 1-29-80
H-7563 Clark E. & Evelyn P. Cubbage 11-8-73
H-7475 Robert L. & Jean E. Hilburn 7-27-77
5.00 Ac.
75.36 Ac.
73
70.755 ACS.
71.33 ACS.
80.50 Ac.
H-7270 THE NEW ALBANY CO. LIMITED PARTNERSHIP
100.05 Ac.
① 482 D.A. & F.W. Clickenger 3-16-48 (.321 Ac.) 11-16-60 (.135 Ac.) T=.456
② 480 Leroy L.& D.E. Clickenger 7-28-58 (.321 Ac.) 11-16-60 (.189 Ac.) Total=.51 Ac.
③ 270 D.A. & F.J. Clickenger 6-11-86 1.284 Ac.

O-73-F