



O-77-F
PLEASANT TWP.

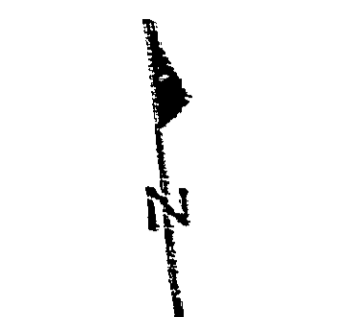

SCALE 1"=200'

V.M.S.
E-HIGHWAY EASEMENT
TAXING DISTRICTS DISTRICT CODE
PLEASANT TWP 230

HOUSE NUMB.P.

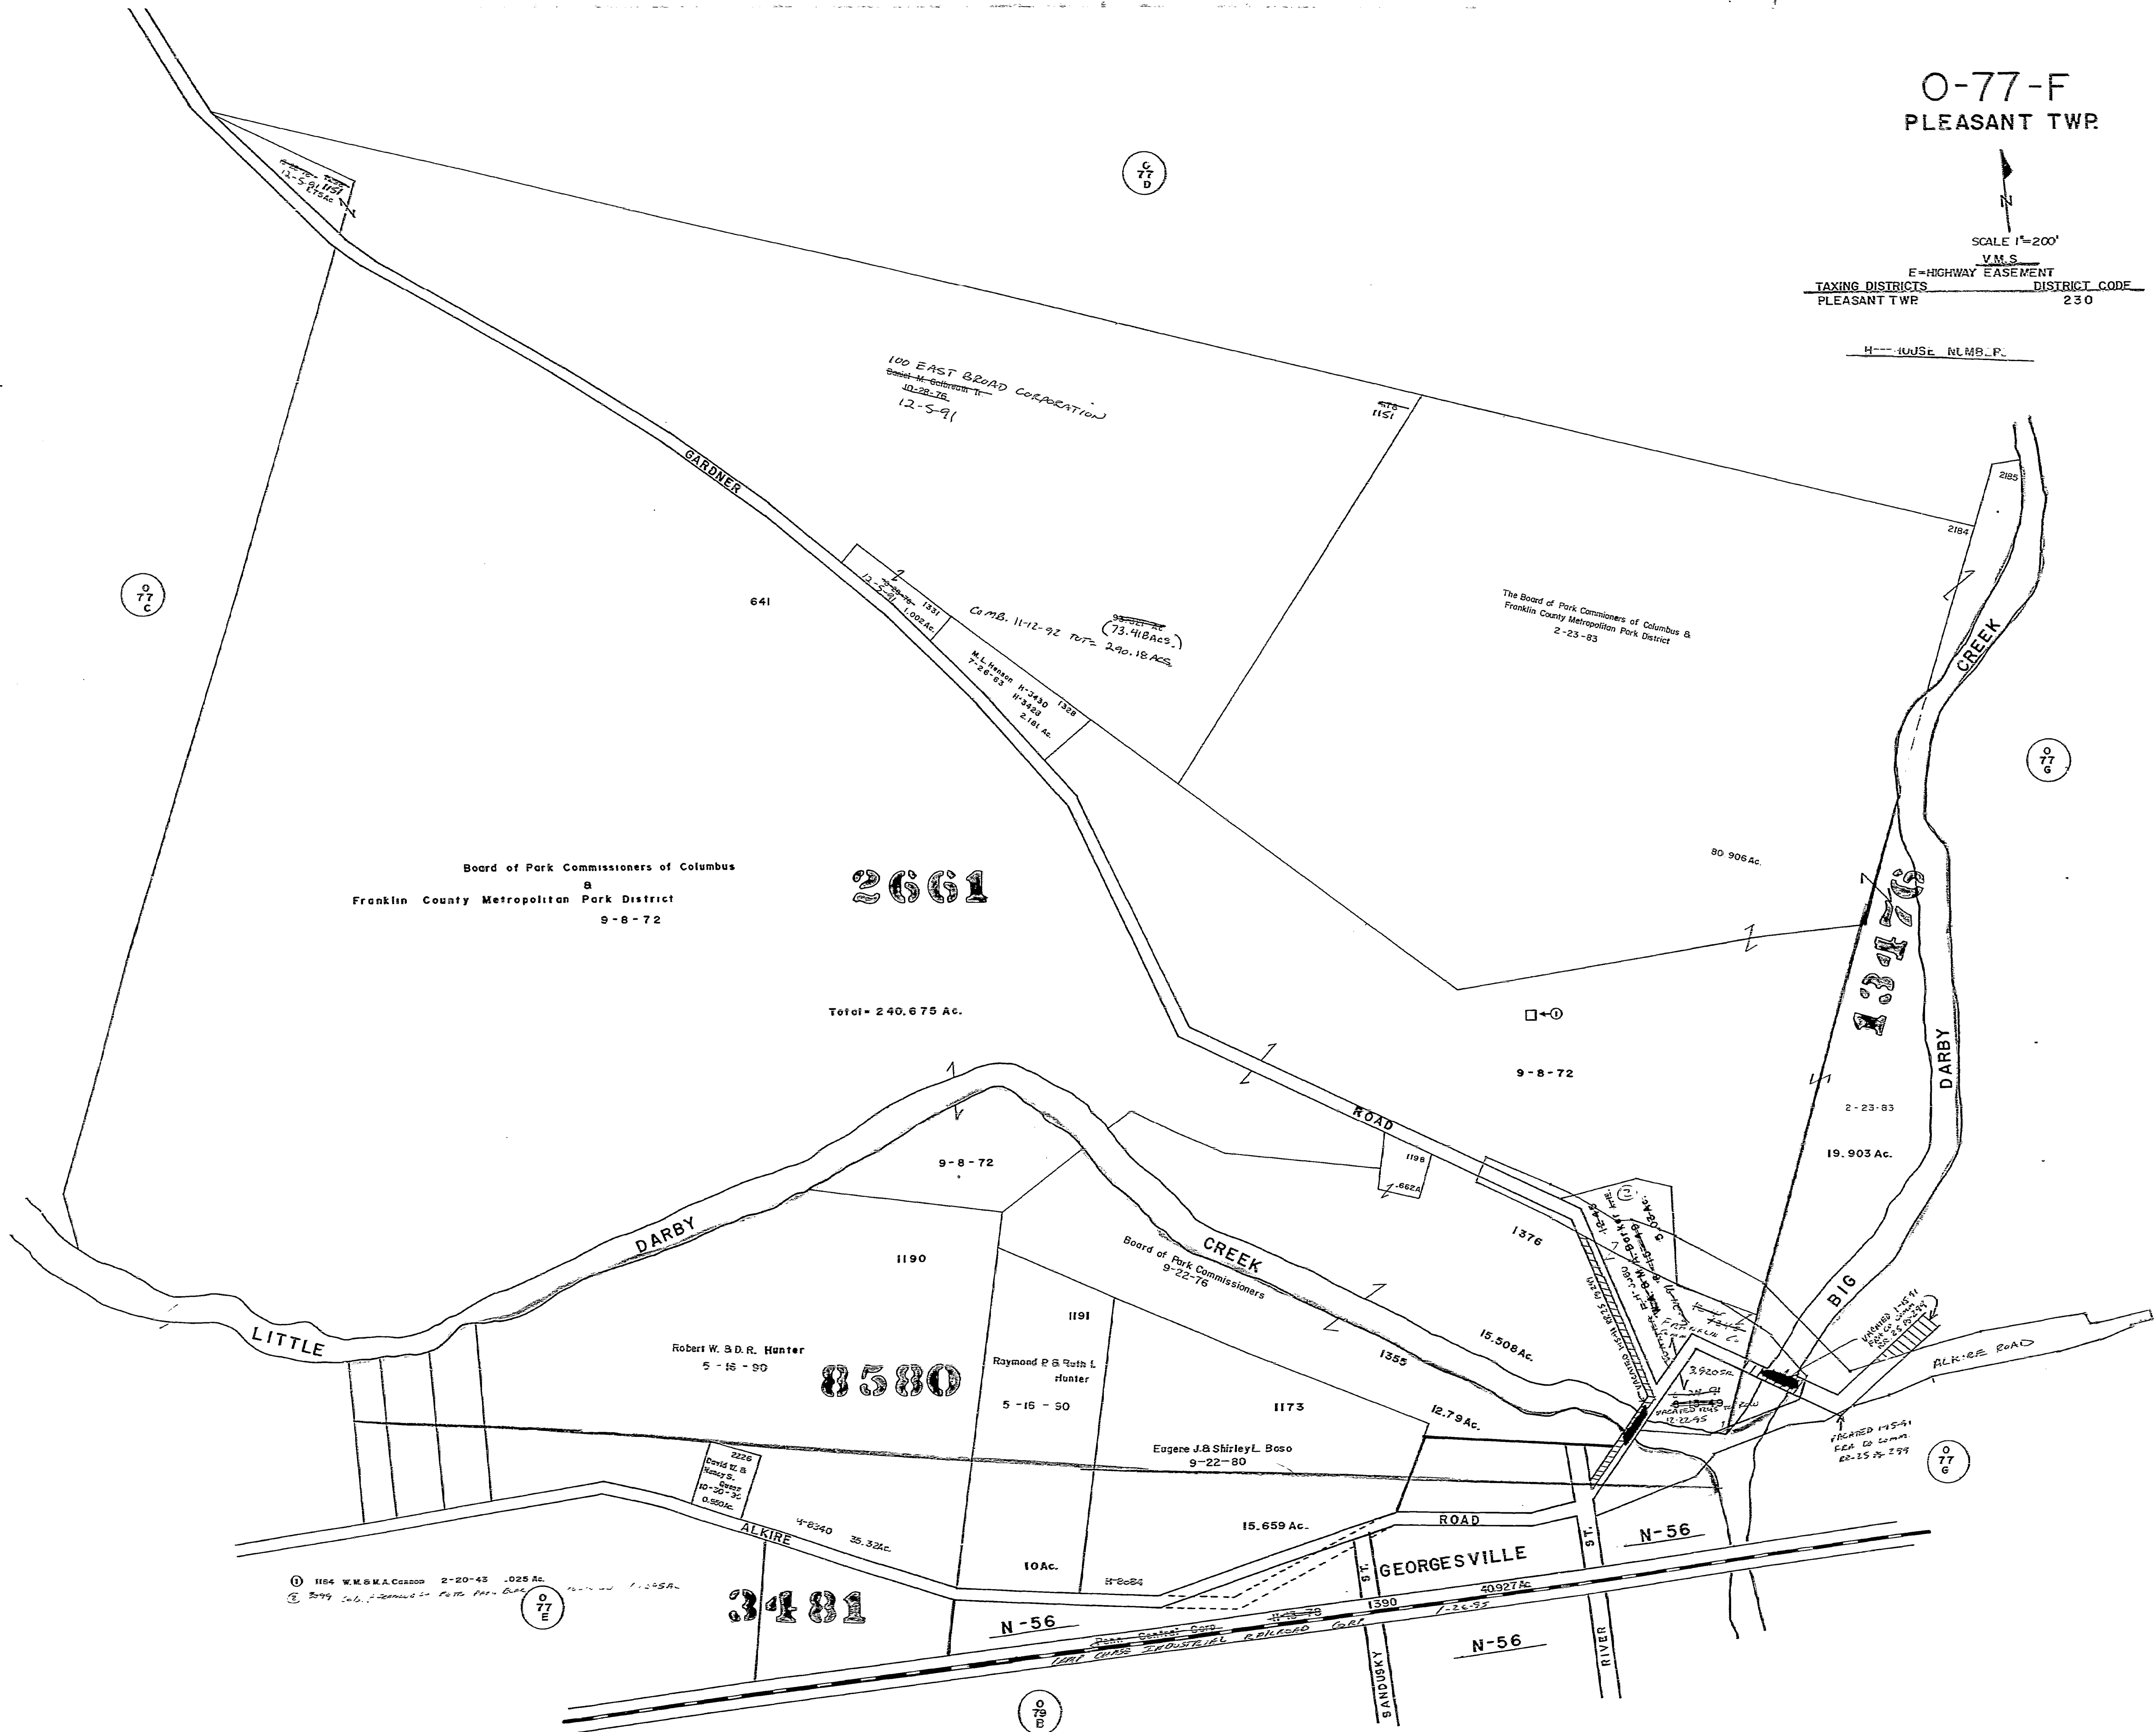

① 1164 W.M.S.A. Caspary 2-20-43 .025 Ac.

O-77-F
11/10/84
