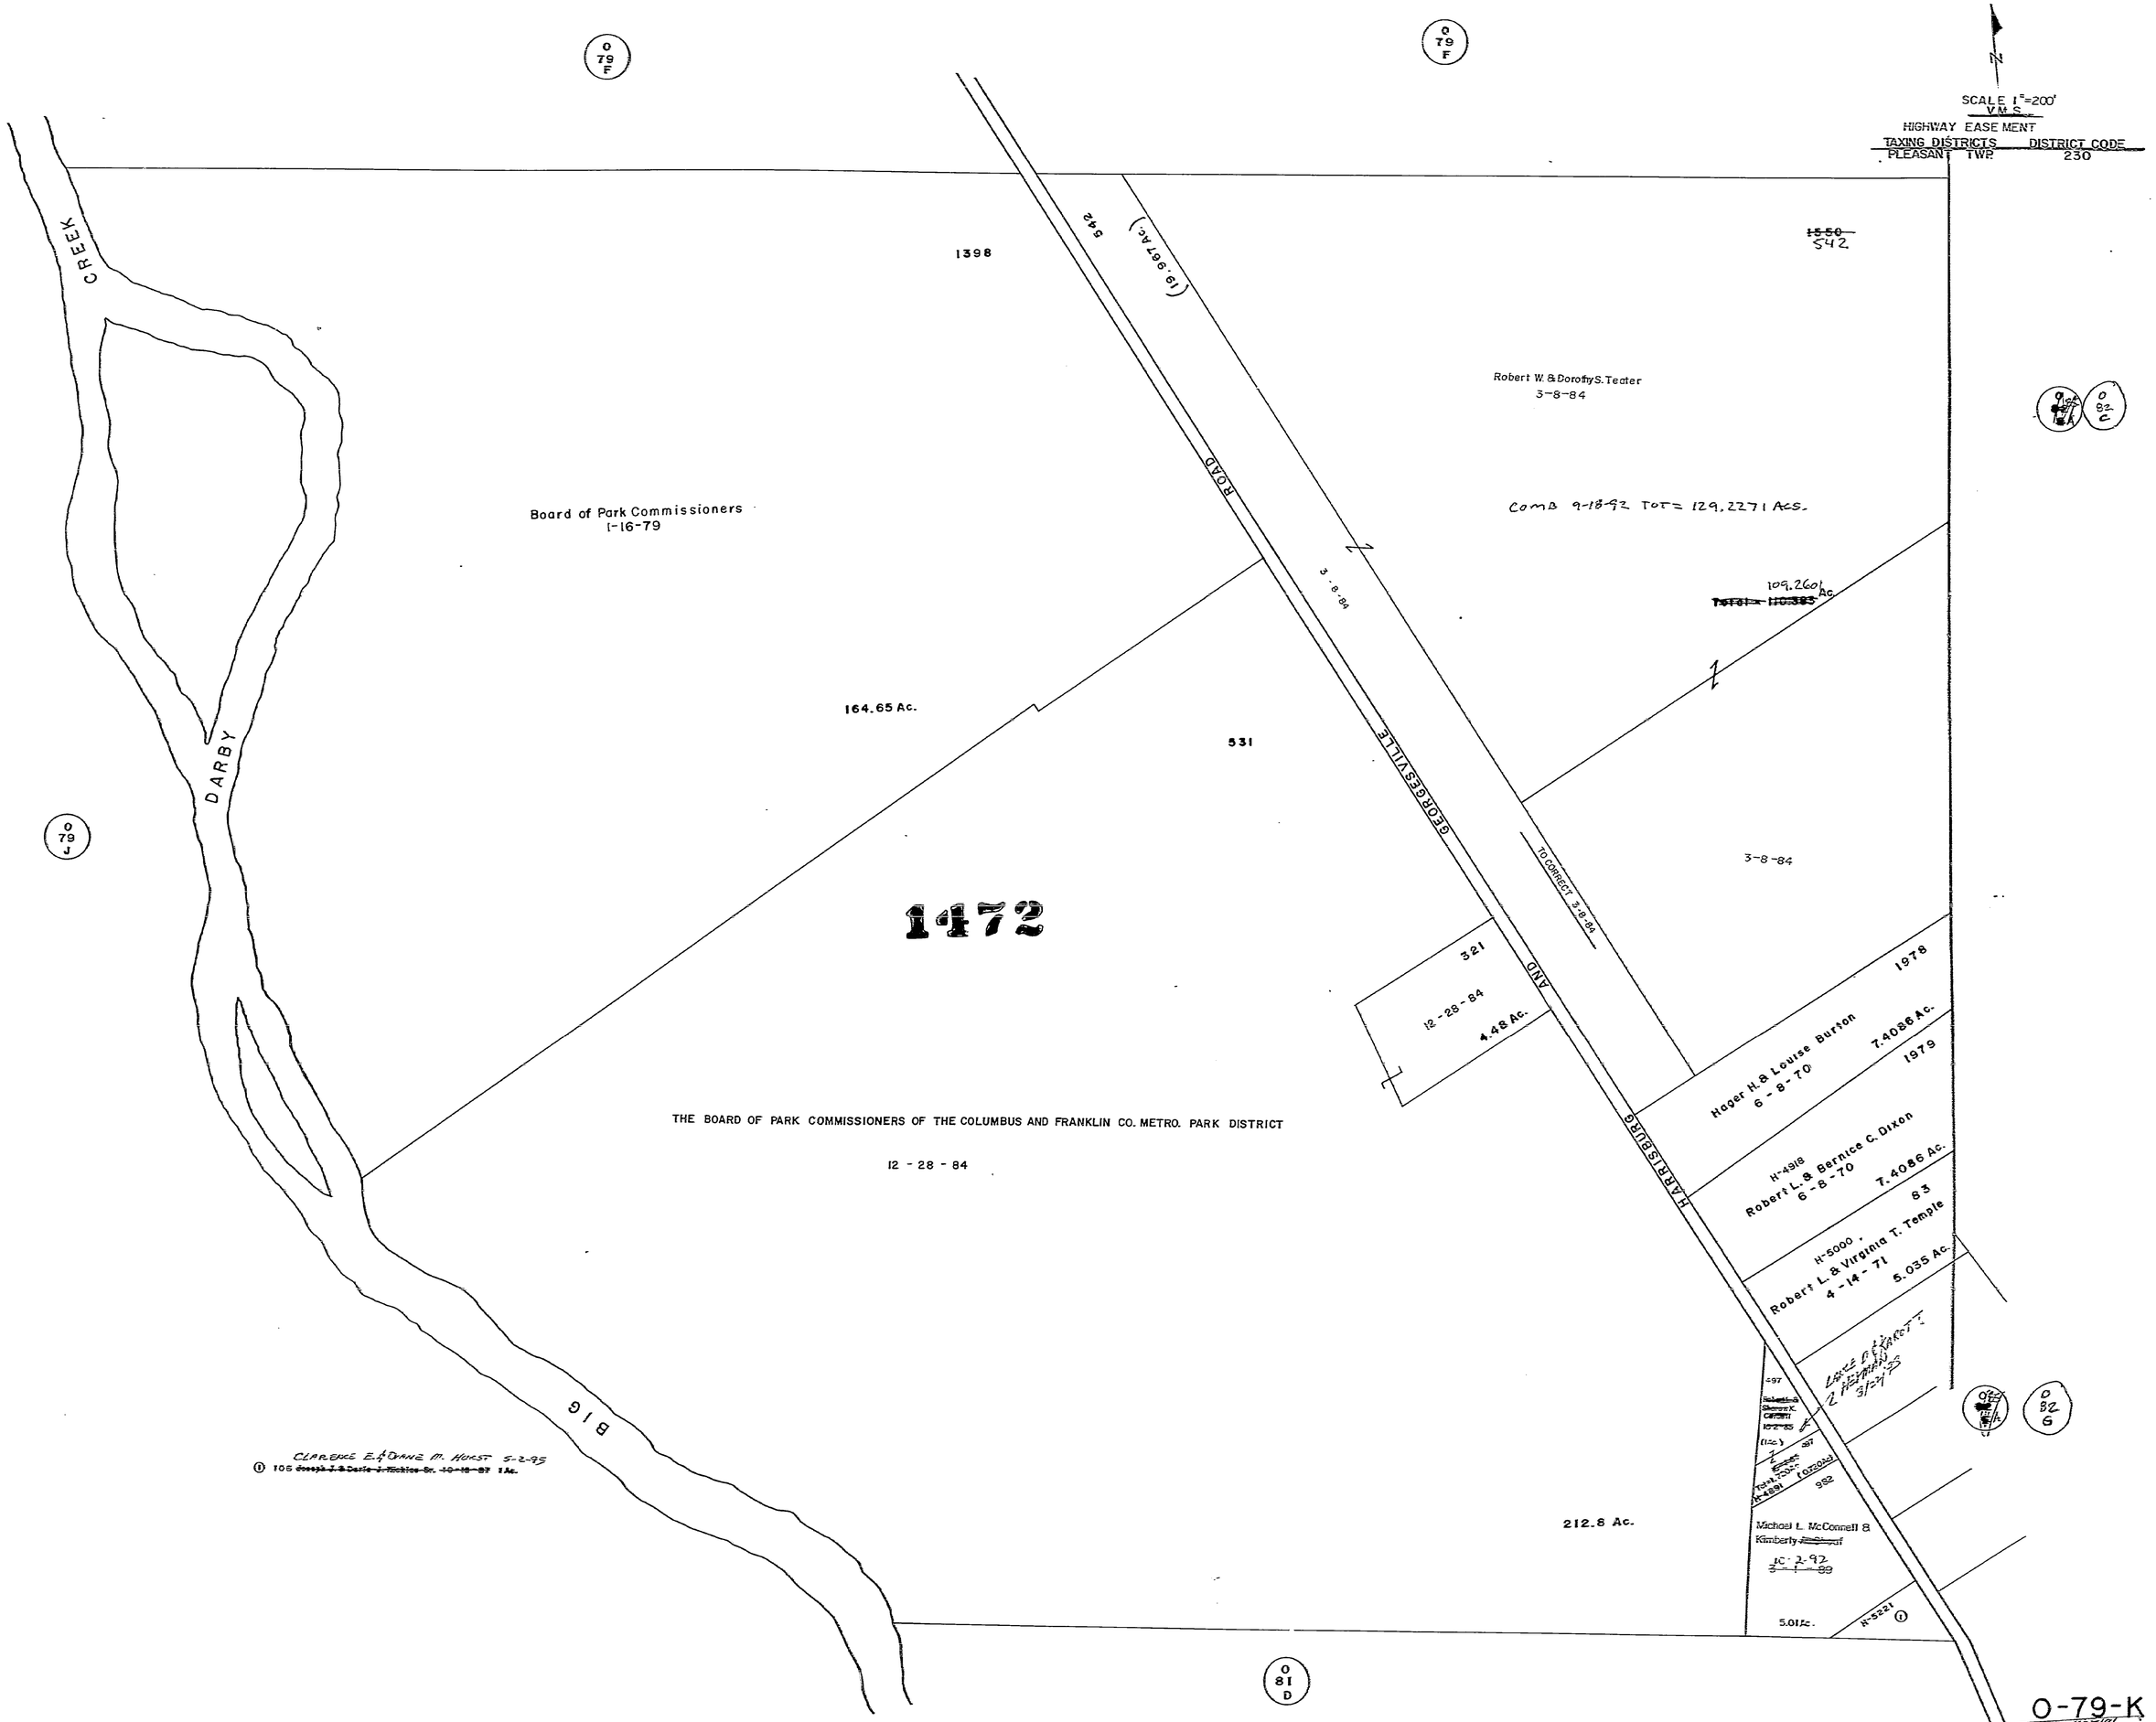PLEASANT TWP.