

0-81-A
PLEASANT TWP



SCALE 1" = 200'
V.M.S.
E = HIGHWAY EASEMENT

TAXING DISTRICTS	DISTRICT CODE
PLEASANT TWP	230
PLAINS LOCAL S.D. MADISON CO.	232
H - HOUSE NUMBERS	

O
81
B

601


8423

15532

8420

8094

6285
13258

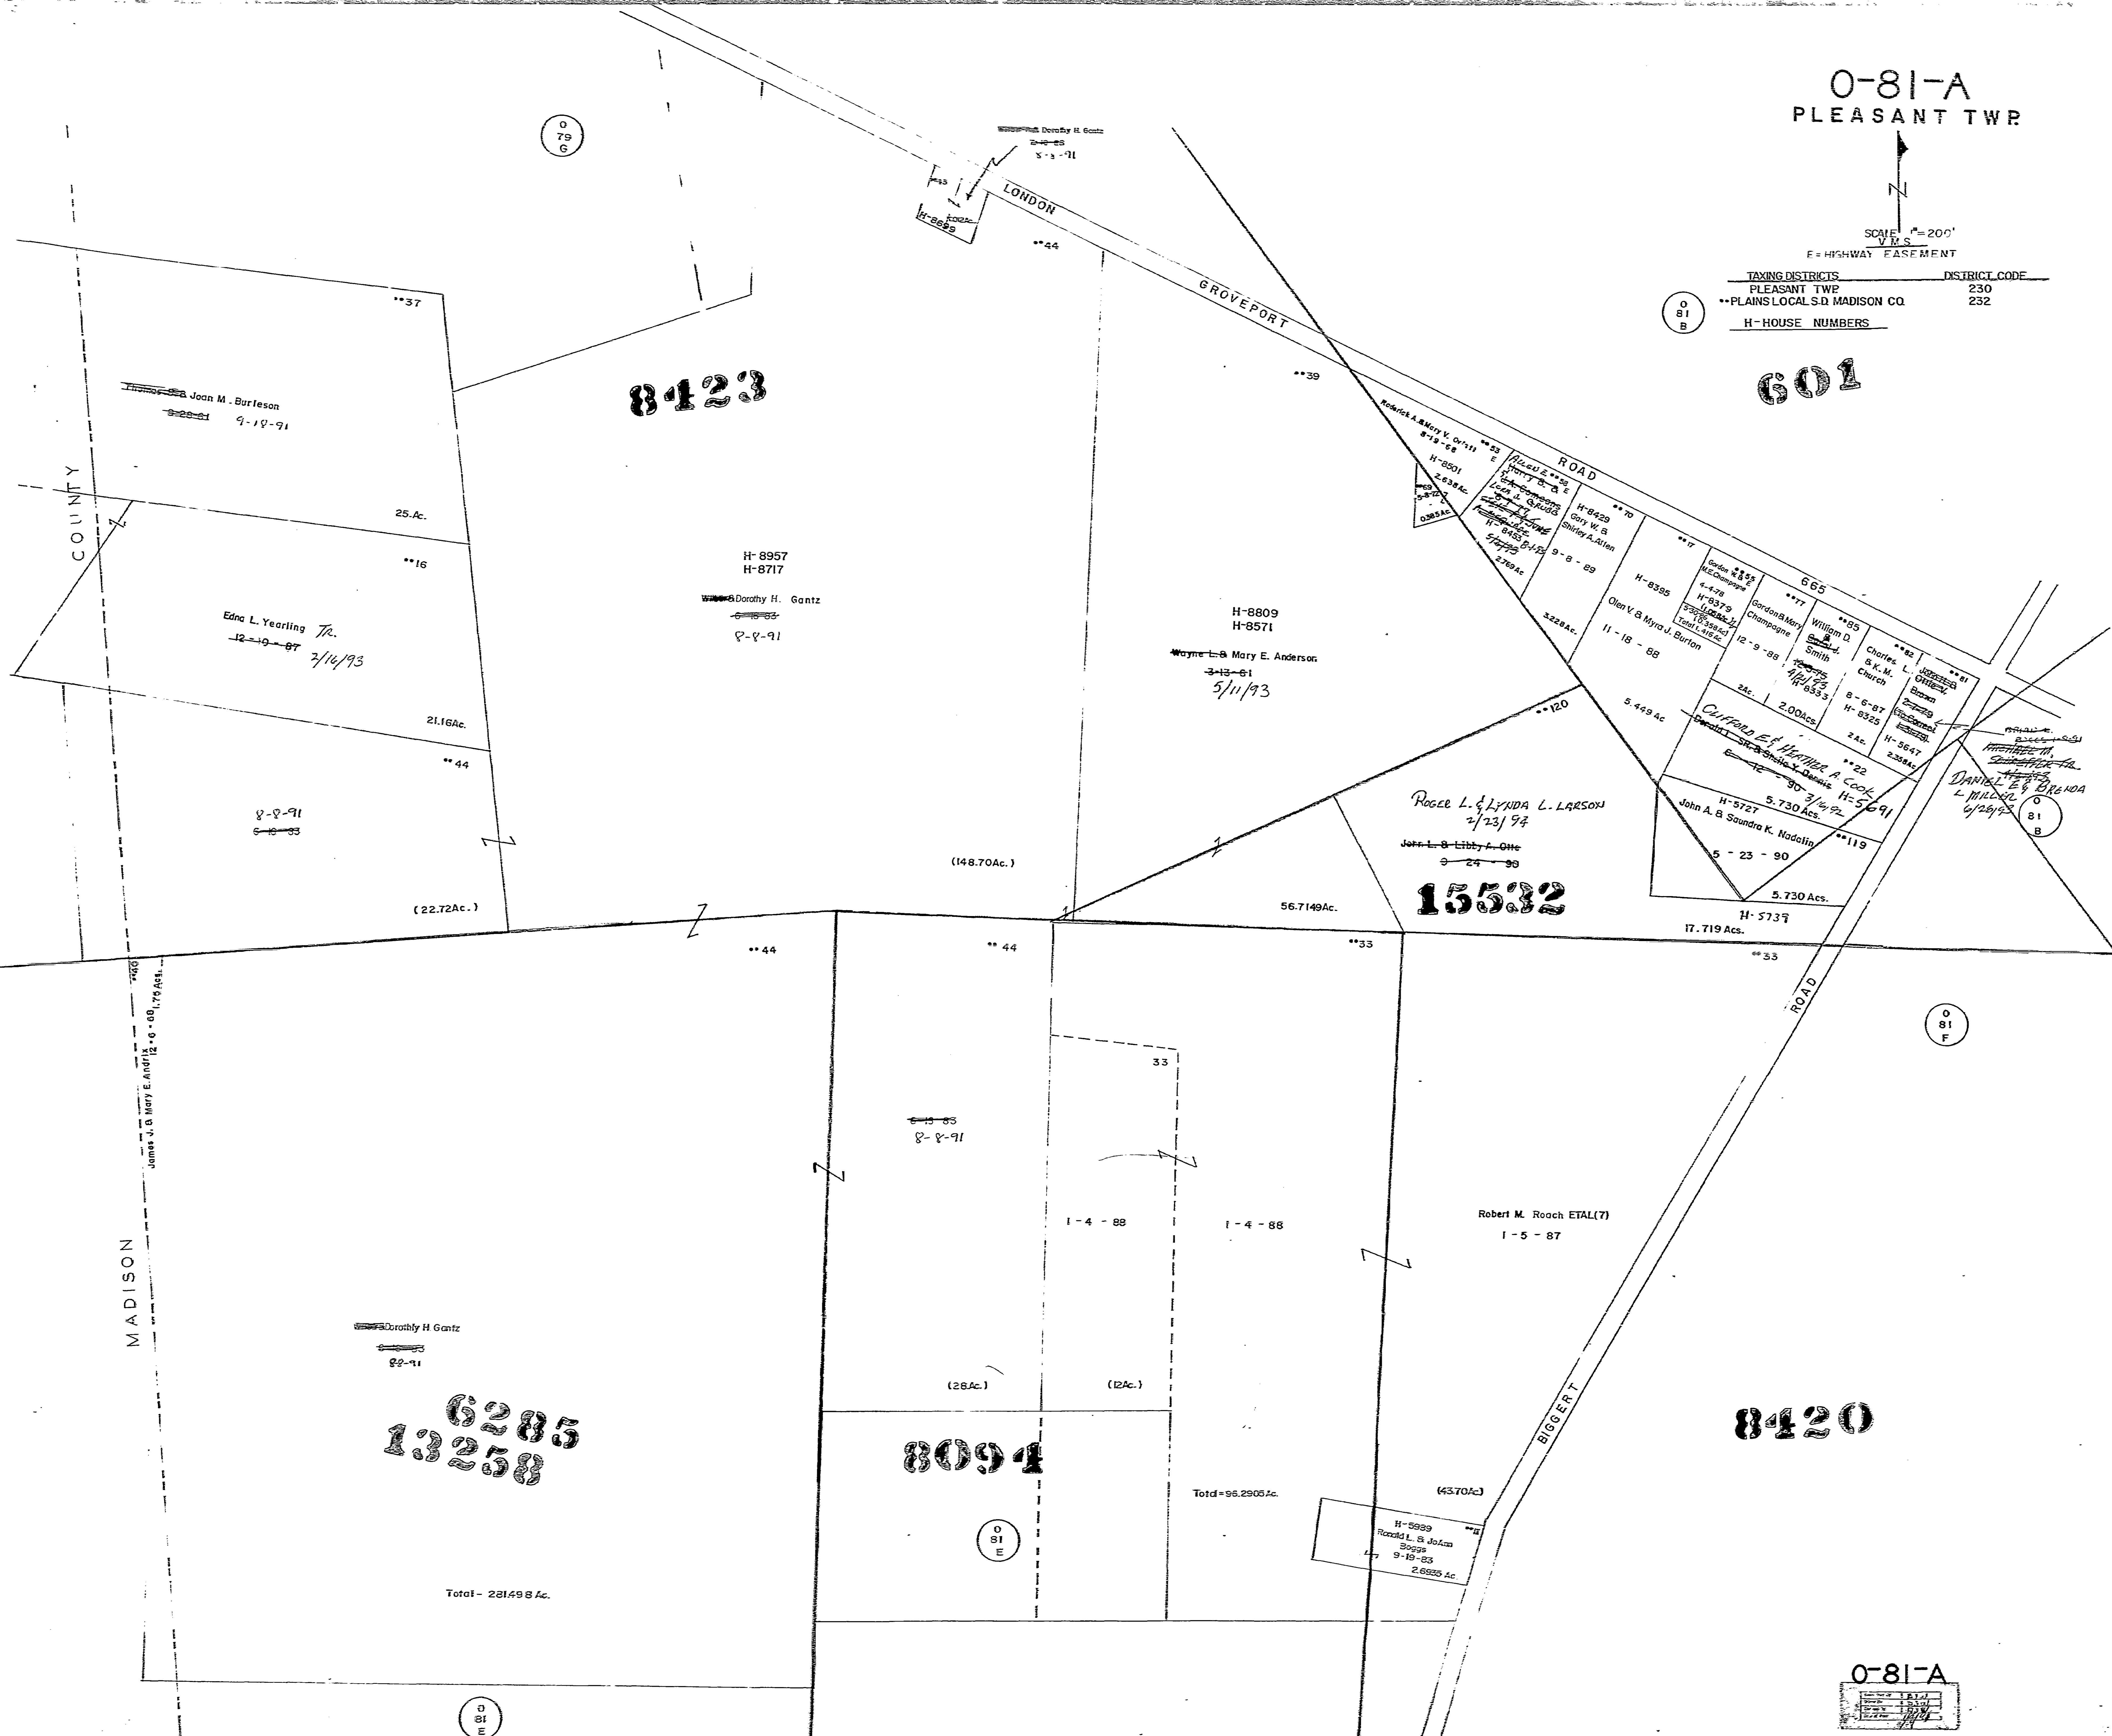

0-81-A

