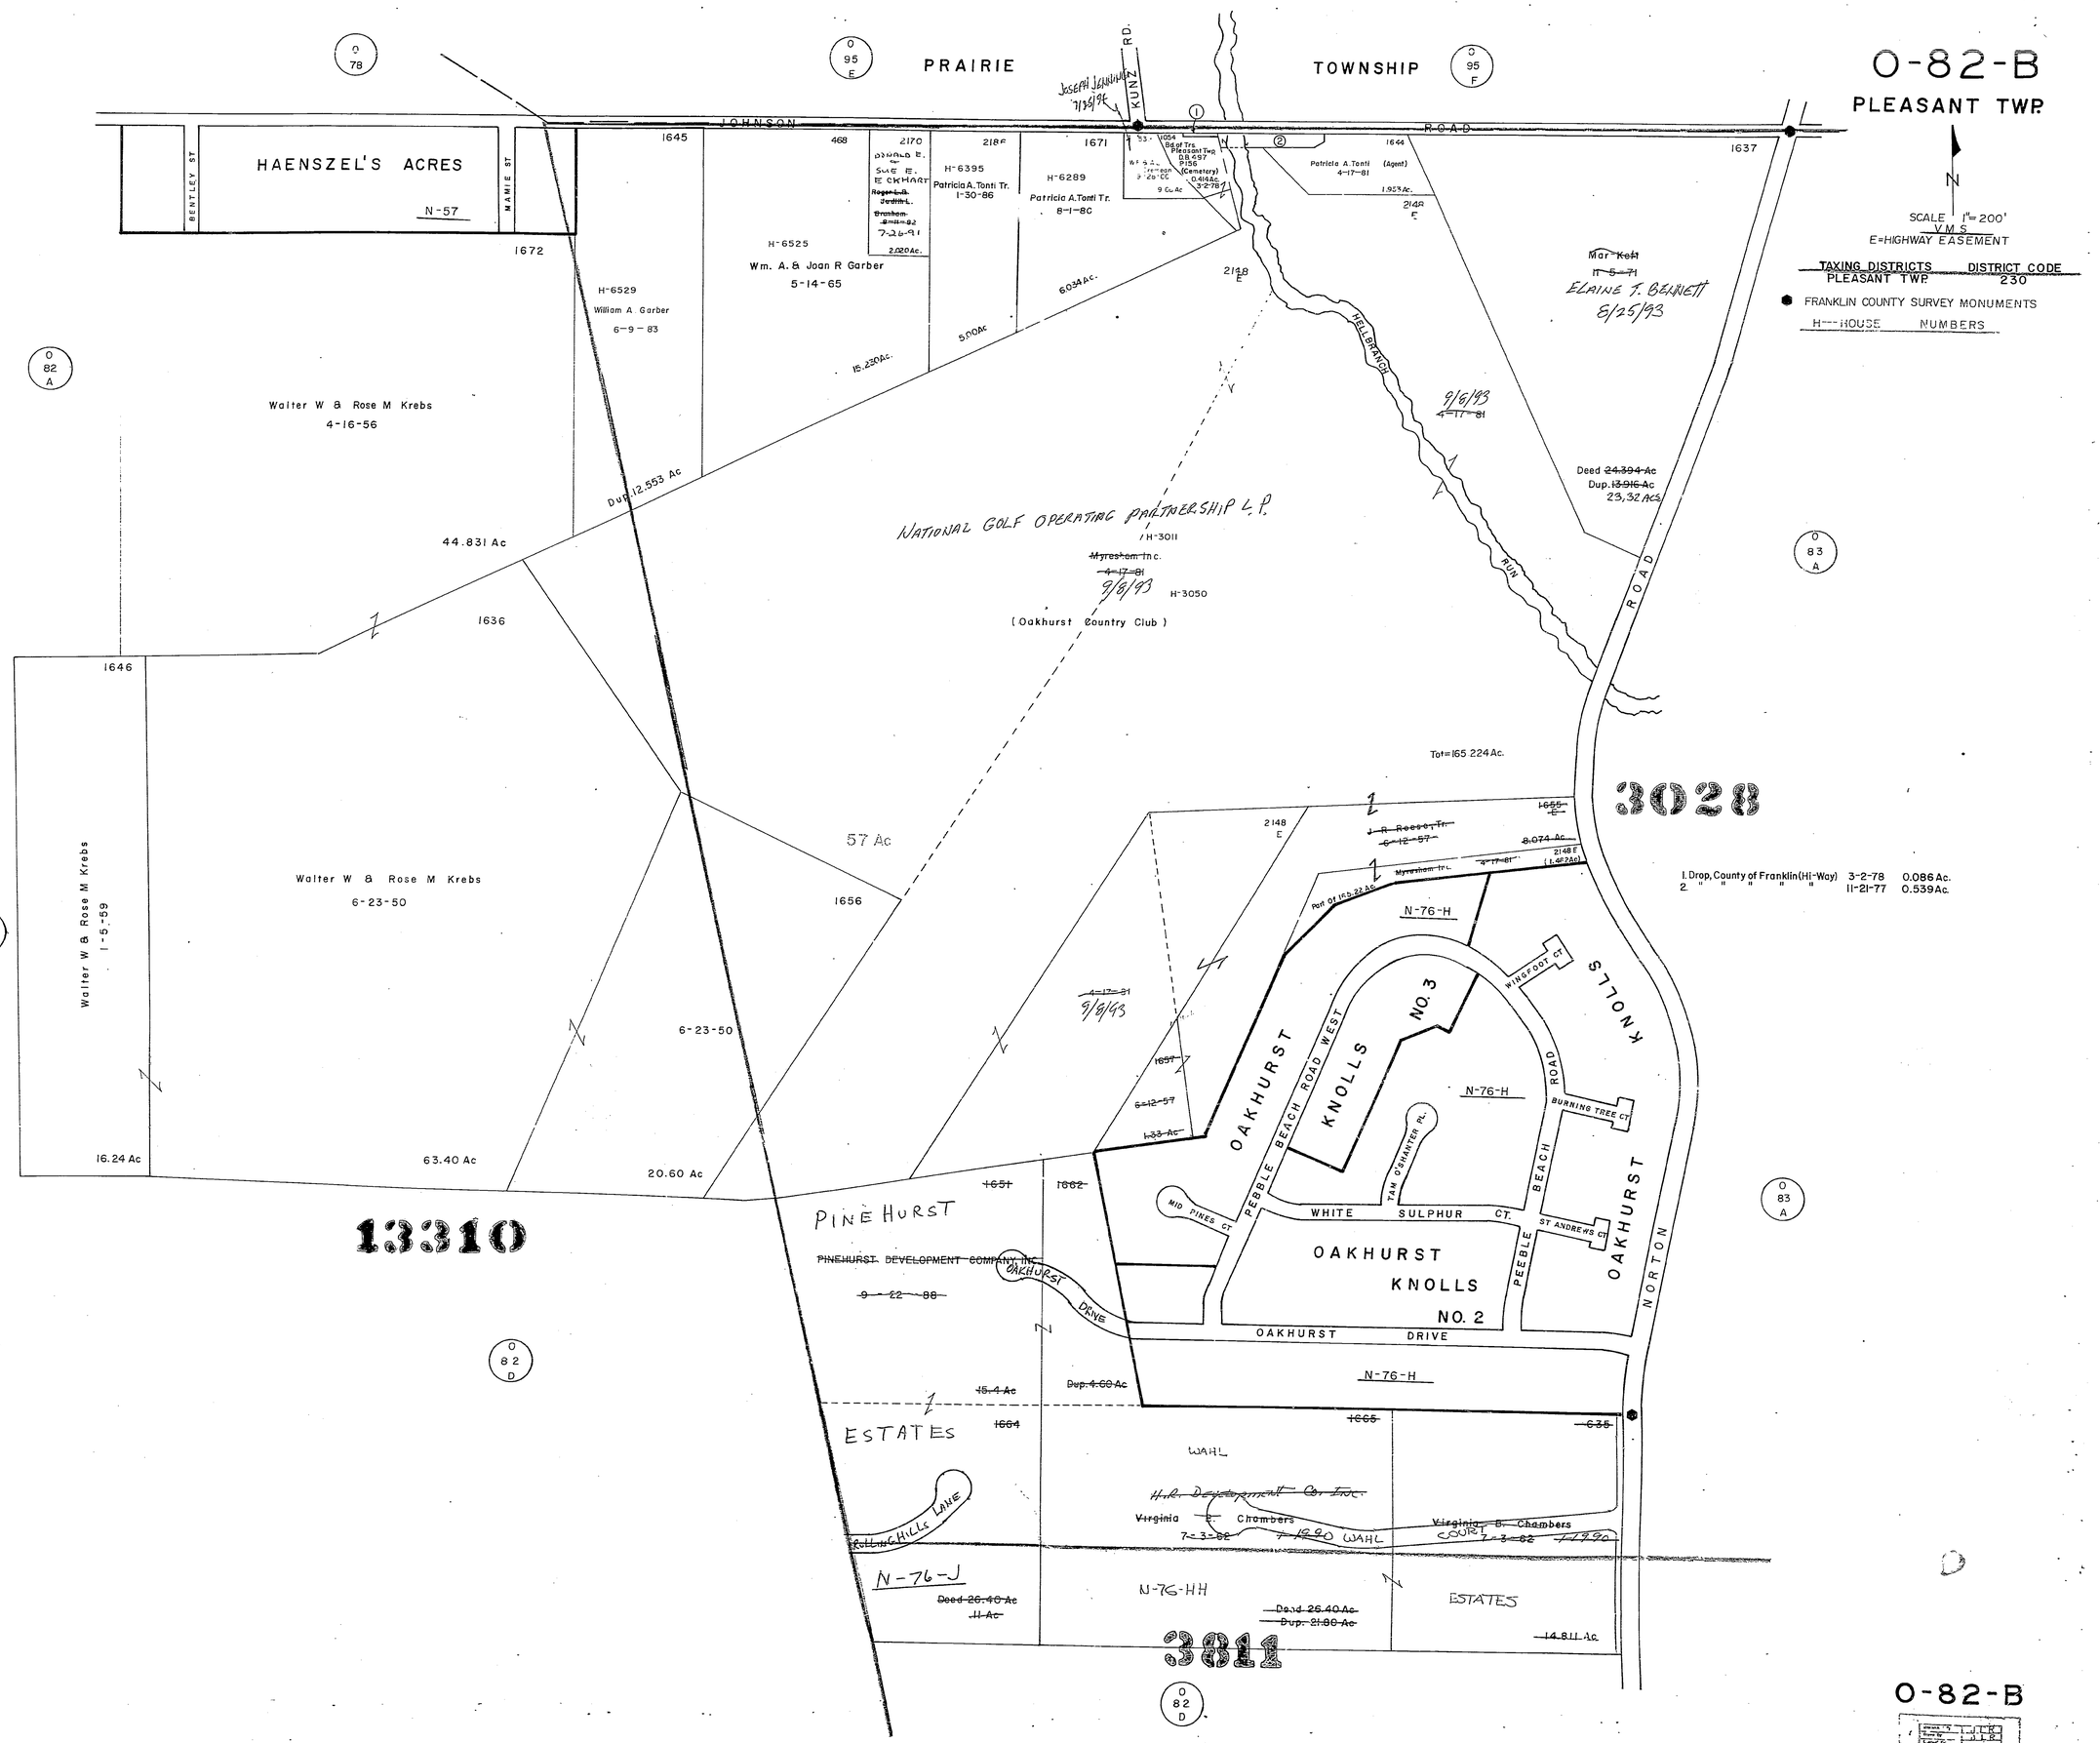
O-82-B
PLEASANT TWP.
N
SCALE 1"=200'
V.M.S.
E=HIGHWAY EASEMENT
TAXING DISTRICTS
PLEASANT TWP.
DISTRICT CODE
230
FRANKLIN COUNTY SURVEY MONUMENTS
H---HOUSE NUMBERS
PRAIRIE TOWNSHIP
JOHNSON ROAD
KUNZ RD.
HELL BRANCH RUN
HAENSZEL'S ACRES
N-57
BENTLEY ST
MAMIE ST
Walter W & Rose M Krebs
4-16-56
H-6529
William A. Garber
6-9-83
H-6525
Wm. A. & Joan R Garber
5-14-65
H-6395
Patricia A. Tonti Tr.
1-30-86
H-6289
Patricia A. Tonti Tr.
8-1-86
Patricia A. Tonti (Agent)
4-17-81
ELAINE T. BENNETT
8/25/93
Deed 24.394 Ac
Dup. 13.916 Ac
23.32 Acs
Dup. 12.553 Ac
44.831 Ac
NATIONAL GOLF OPERATING PARTNERSHIP L.P.
H-3011
H-3050
(Oakhurst Country Club)
Tot=165.224 Ac.
3028
1 Drop, County of Franklin (Hi-Way) 3-2-78 0.086 Ac.
2 " " " " 11-21-77 0.539 Ac.
Walter W & Rose M Krebs
6-23-50
Walter W & Rose M Krebs
1-5-59
57 Ac
6-23-50
16.24 Ac
63.40 Ac
20.60 Ac
13310
N-76-H
OAKHURST KNOLLS NO. 3
OAKHURST KNOLLS NO. 2
PEBBLE BEACH ROAD WEST
PEBBLE BEACH ROAD
WINGFOOT CT.
BURNING TREE CT.
MID PINES CT.
WHITE SULPHUR CT.
ST ANDREWS CT.
OAKHURST DRIVE
NORTON ROAD
PINE HURST ESTATES
OAKHURST DRIVE
ROLLING HILLS LANE
N-76-J
N-76-HH
WAHL COURT
ESTATES
3811
O-82-B