


SCALE 1"=200'
V.M.S.
E=HIGHWAY EASEMENT

TAXING DISTRICTS DISTRICT CODE
PLEASANT TWP. 230

FRANKLIN COUNTY SURVEY MONUMENTS
H—HOUSE NUMBERS

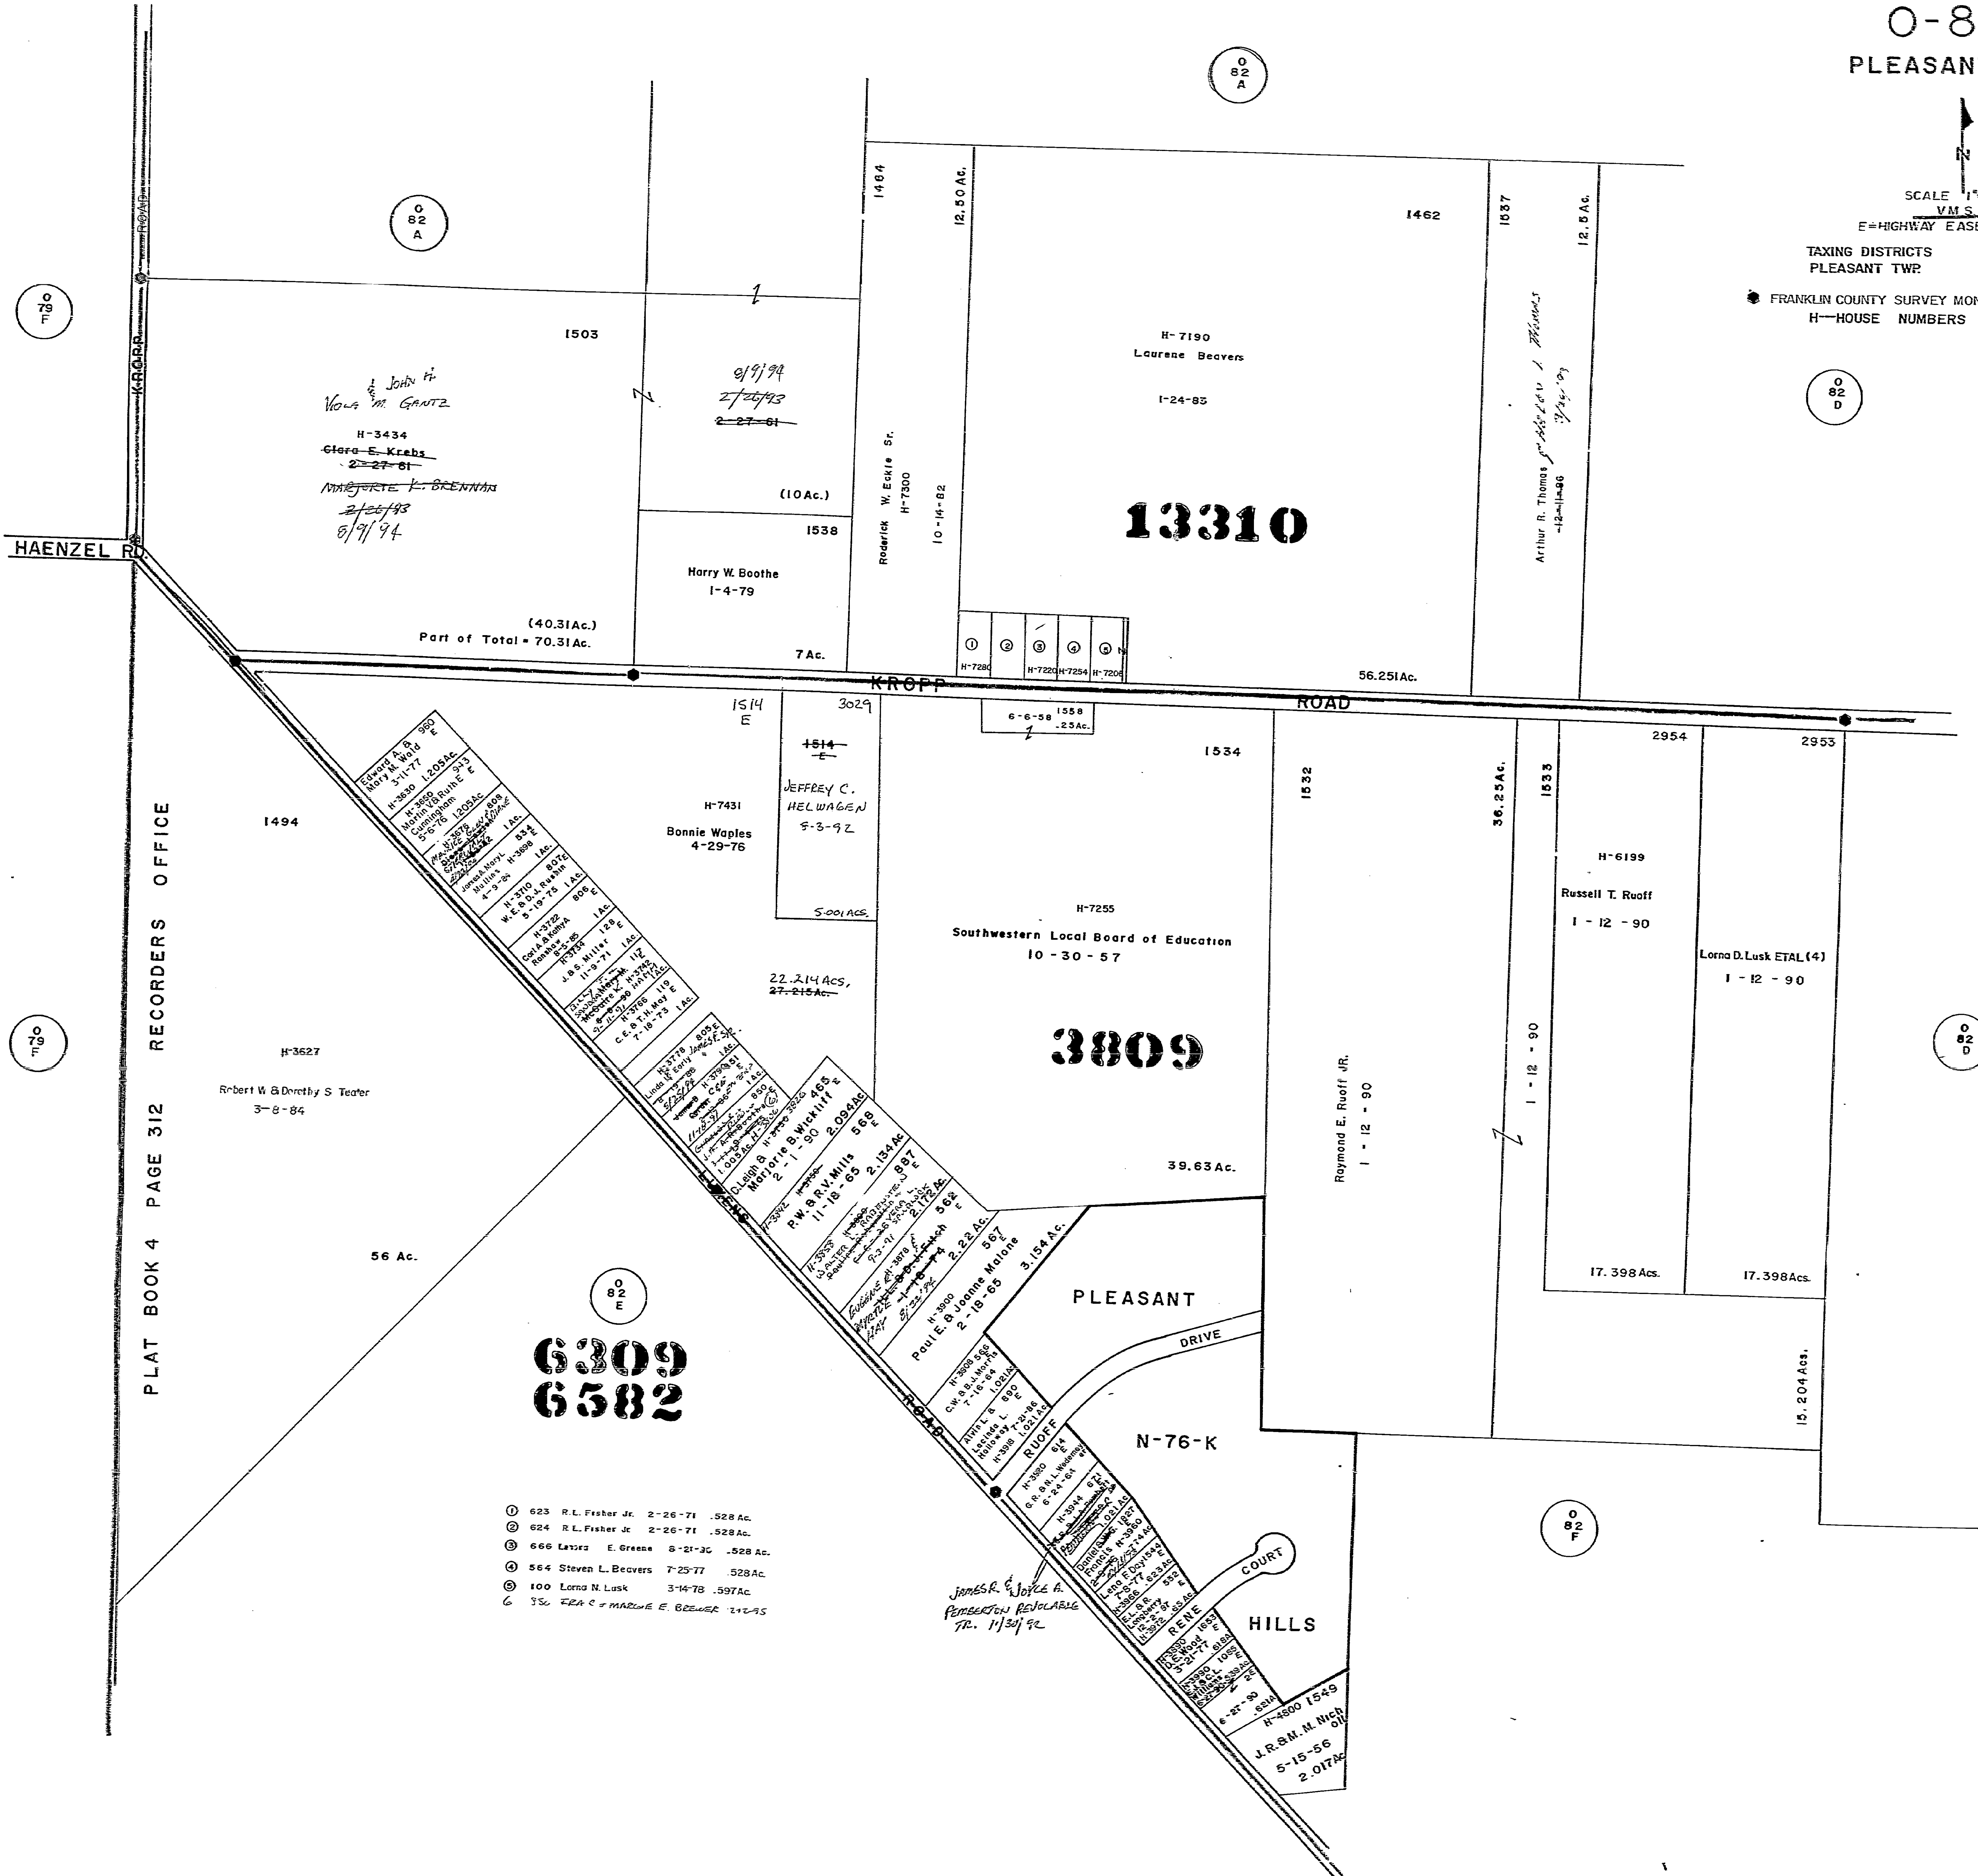

O 79 F

O 82 A

O 82 A

O 82 D

O 79 F

O 82 D

O 82 E

O 82 F

PLAT BOOK 4 PAGE 312 RECORDERS OFFICE

- ① 623 R.L. Fisher Jr. 2-26-71 .528 Ac.
- ② 624 R.L. Fisher Jr. 2-26-71 .528 Ac.
- ③ 666 Laura E. Greene 8-21-30 .528 Ac.
- ④ 564 Steven L. Beavers 7-25-77 .528 Ac.
- ⑤ 100 Lorna N. Lusk 3-14-78 .597 Ac.
- ⑥ 356 FRAZ & MARION E. BEAVER 2-14-75