


0-82-F
PLEASANT TWP

SCALE 1" = 200'
V.M.S.
E = HIGHWAY EASEMENT

TAXING DISTRICT DISTRICT CODE
PLEASANT TWP 230
FRANKLIN COUNTY SURVEY MONUMENTS
H---HOUSE NUMBERS

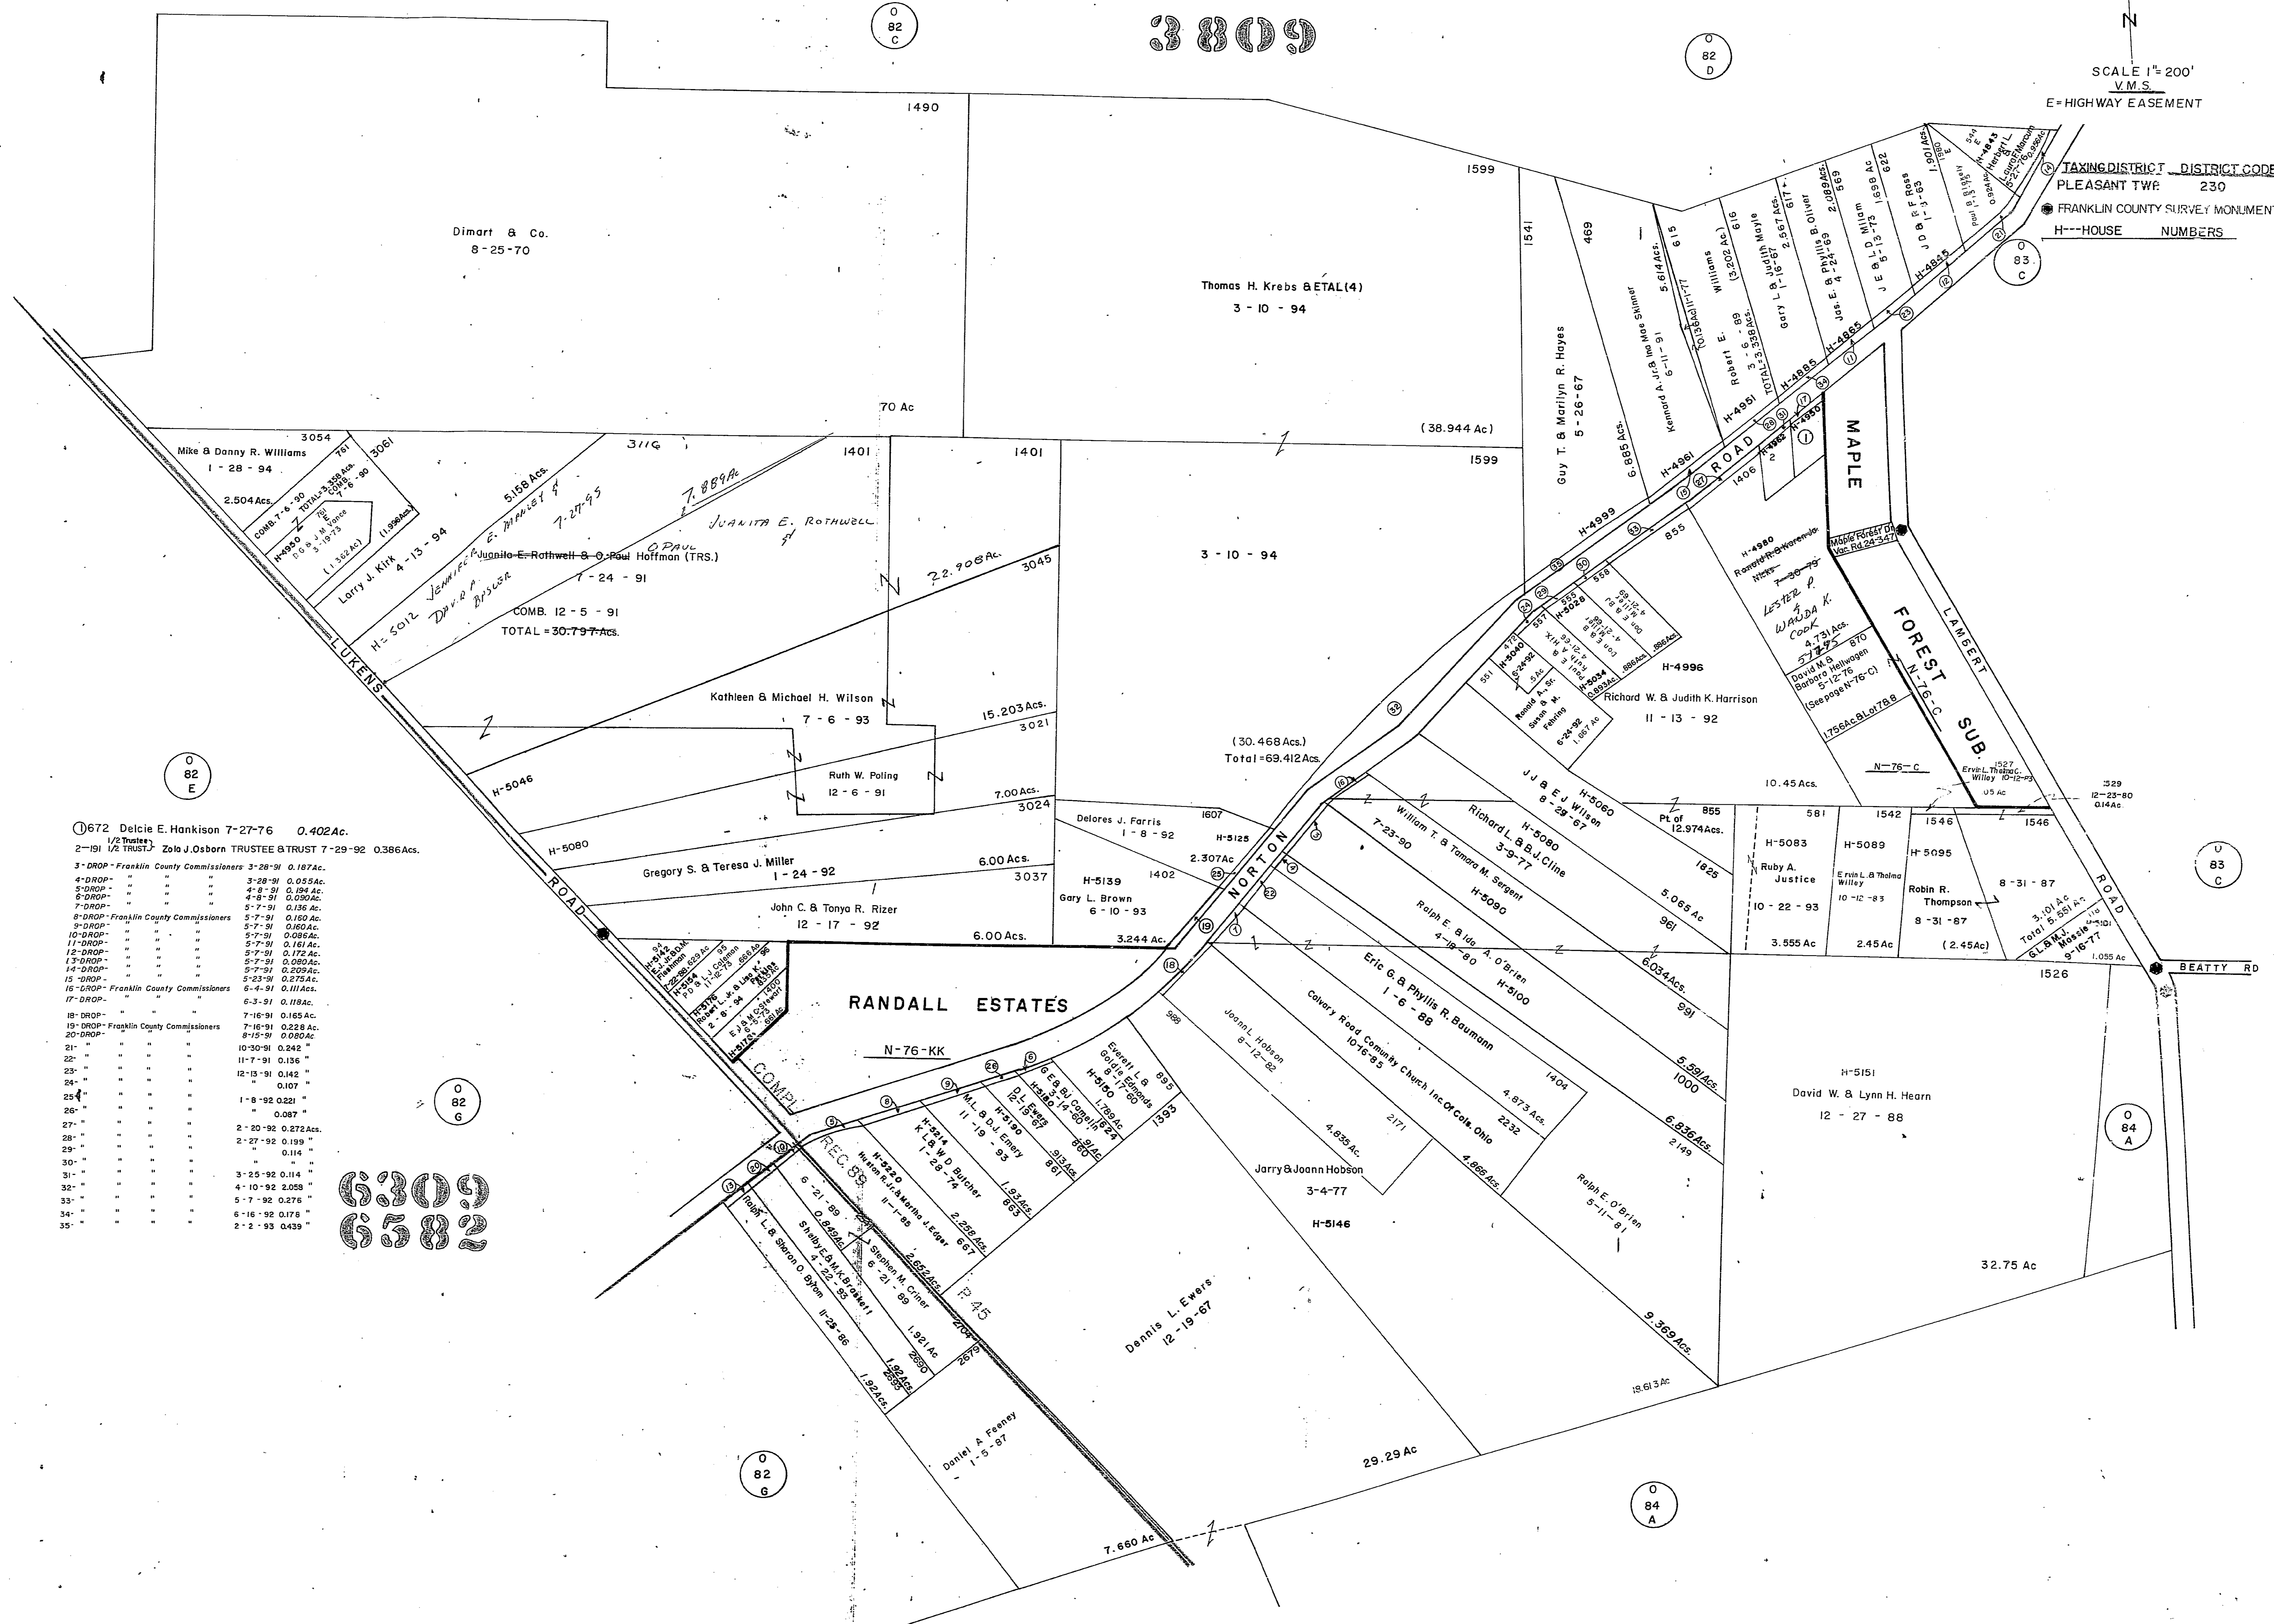

672 Delcie E. Hankison 7-27-76 0.402 Ac.

1/2 TRUST Zola J. Osborn TRUSTEE & TRUST 7-29-92 0.386 Ac.

3-DROP - Franklin County Commissioners	3-28-91	0.187 Ac.
4-DROP - " "	3-28-91	0.055 Ac.
5-DROP - " "	4-8-91	0.194 Ac.
6-DROP - " "	4-8-91	0.090 Ac.
7-DROP - " "	5-7-91	0.136 Ac.
8-DROP - Franklin County Commissioners	5-7-91	0.169 Ac.
9-DROP - " "	5-7-91	0.024 Ac.
10-DROP - " "	5-7-91	0.088 Ac.
11-DROP - " "	5-7-91	0.161 Ac.
12-DROP - " "	5-7-91	0.172 Ac.
13-DROP - " "	5-7-91	0.069 Ac.
14-DROP - " "	5-7-91	0.239 Ac.
15-DROP - " "	5-23-91	0.275 Ac.
16-DROP - Franklin County Commissioners	6-4-91	0.111 Ac.
17-DROP - " "	6-3-91	0.118 Ac.
18-DROP - " "	7-16-91	0.165 Ac.
19-DROP - Franklin County Commissioners	7-16-91	0.228 Ac.
20-DROP - " "	8-15-91	0.080 Ac.
21 - " "	10-30-91	0.242 "
22 - " "	11-7-91	0.136 "
23 - " "	12-13-91	0.142 "
24 - " "	" "	0.107 "
25 - " "	1-8-92	0.221 "
26 - " "	" "	0.087 "
27 - " "	2-20-92	0.272 Ac.
28 - " "	2-27-92	0.199 "
29 - " "	" "	0.114 "
30 - " "	" "	" "
31 - " "	3-25-92	0.114 "
32 - " "	4-10-92	2.058 "
33 - " "	5-7-92	0.276 "
34 - " "	6-16-92	0.176 "
35 - " "	2-2-93	0.439 "

6309
6582