



0-84-F
PLEASANT TWP.

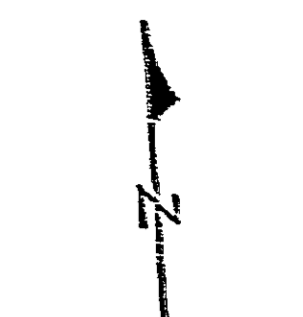

SCALE 1"=200'
V.M.S.
E=HIGHWAY EASEMENT
TAXING DISTRICTS PLEASANT TWP DISTRICT CODE 230
H-HOUSE NUMBERS
● - FRANKLIN COUNTY SURVEY MONUMENT

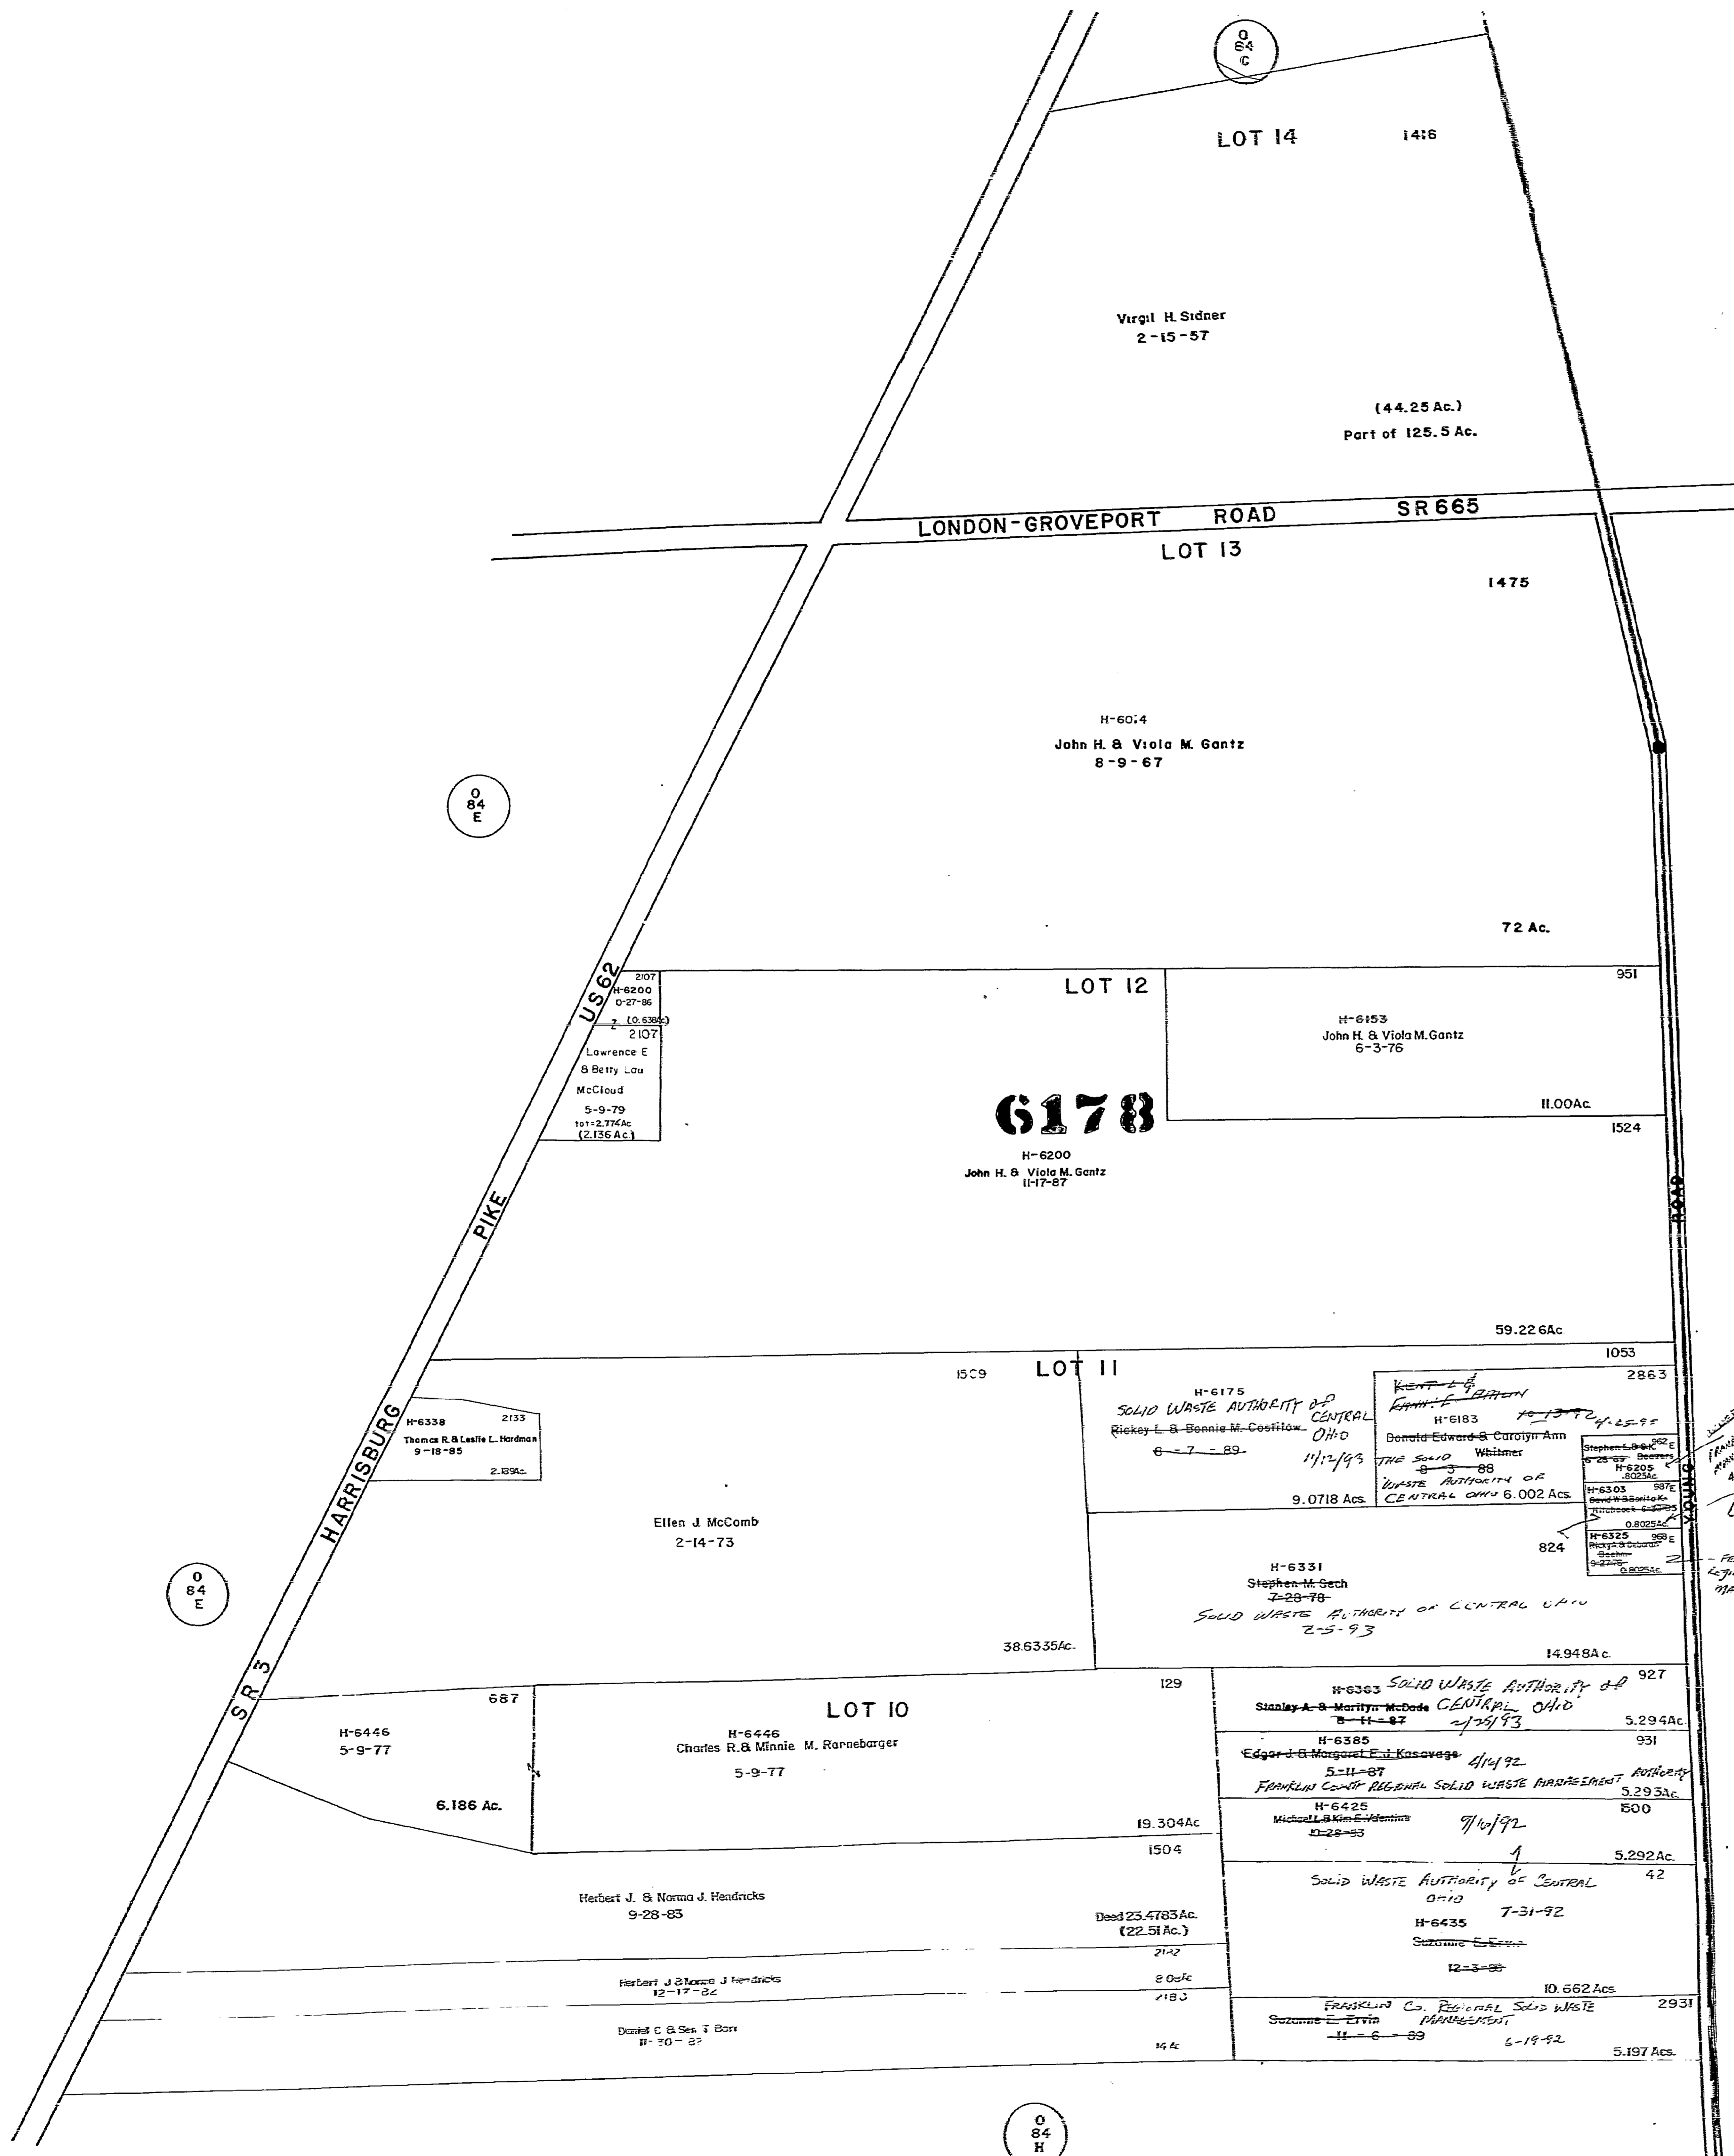

FRANKLIN COUNTY REGIONAL SOLID WASTE MANAGEMENT AUTHORITY
 11/12/93
 11/10/92
 7-31-92
 6-19-92