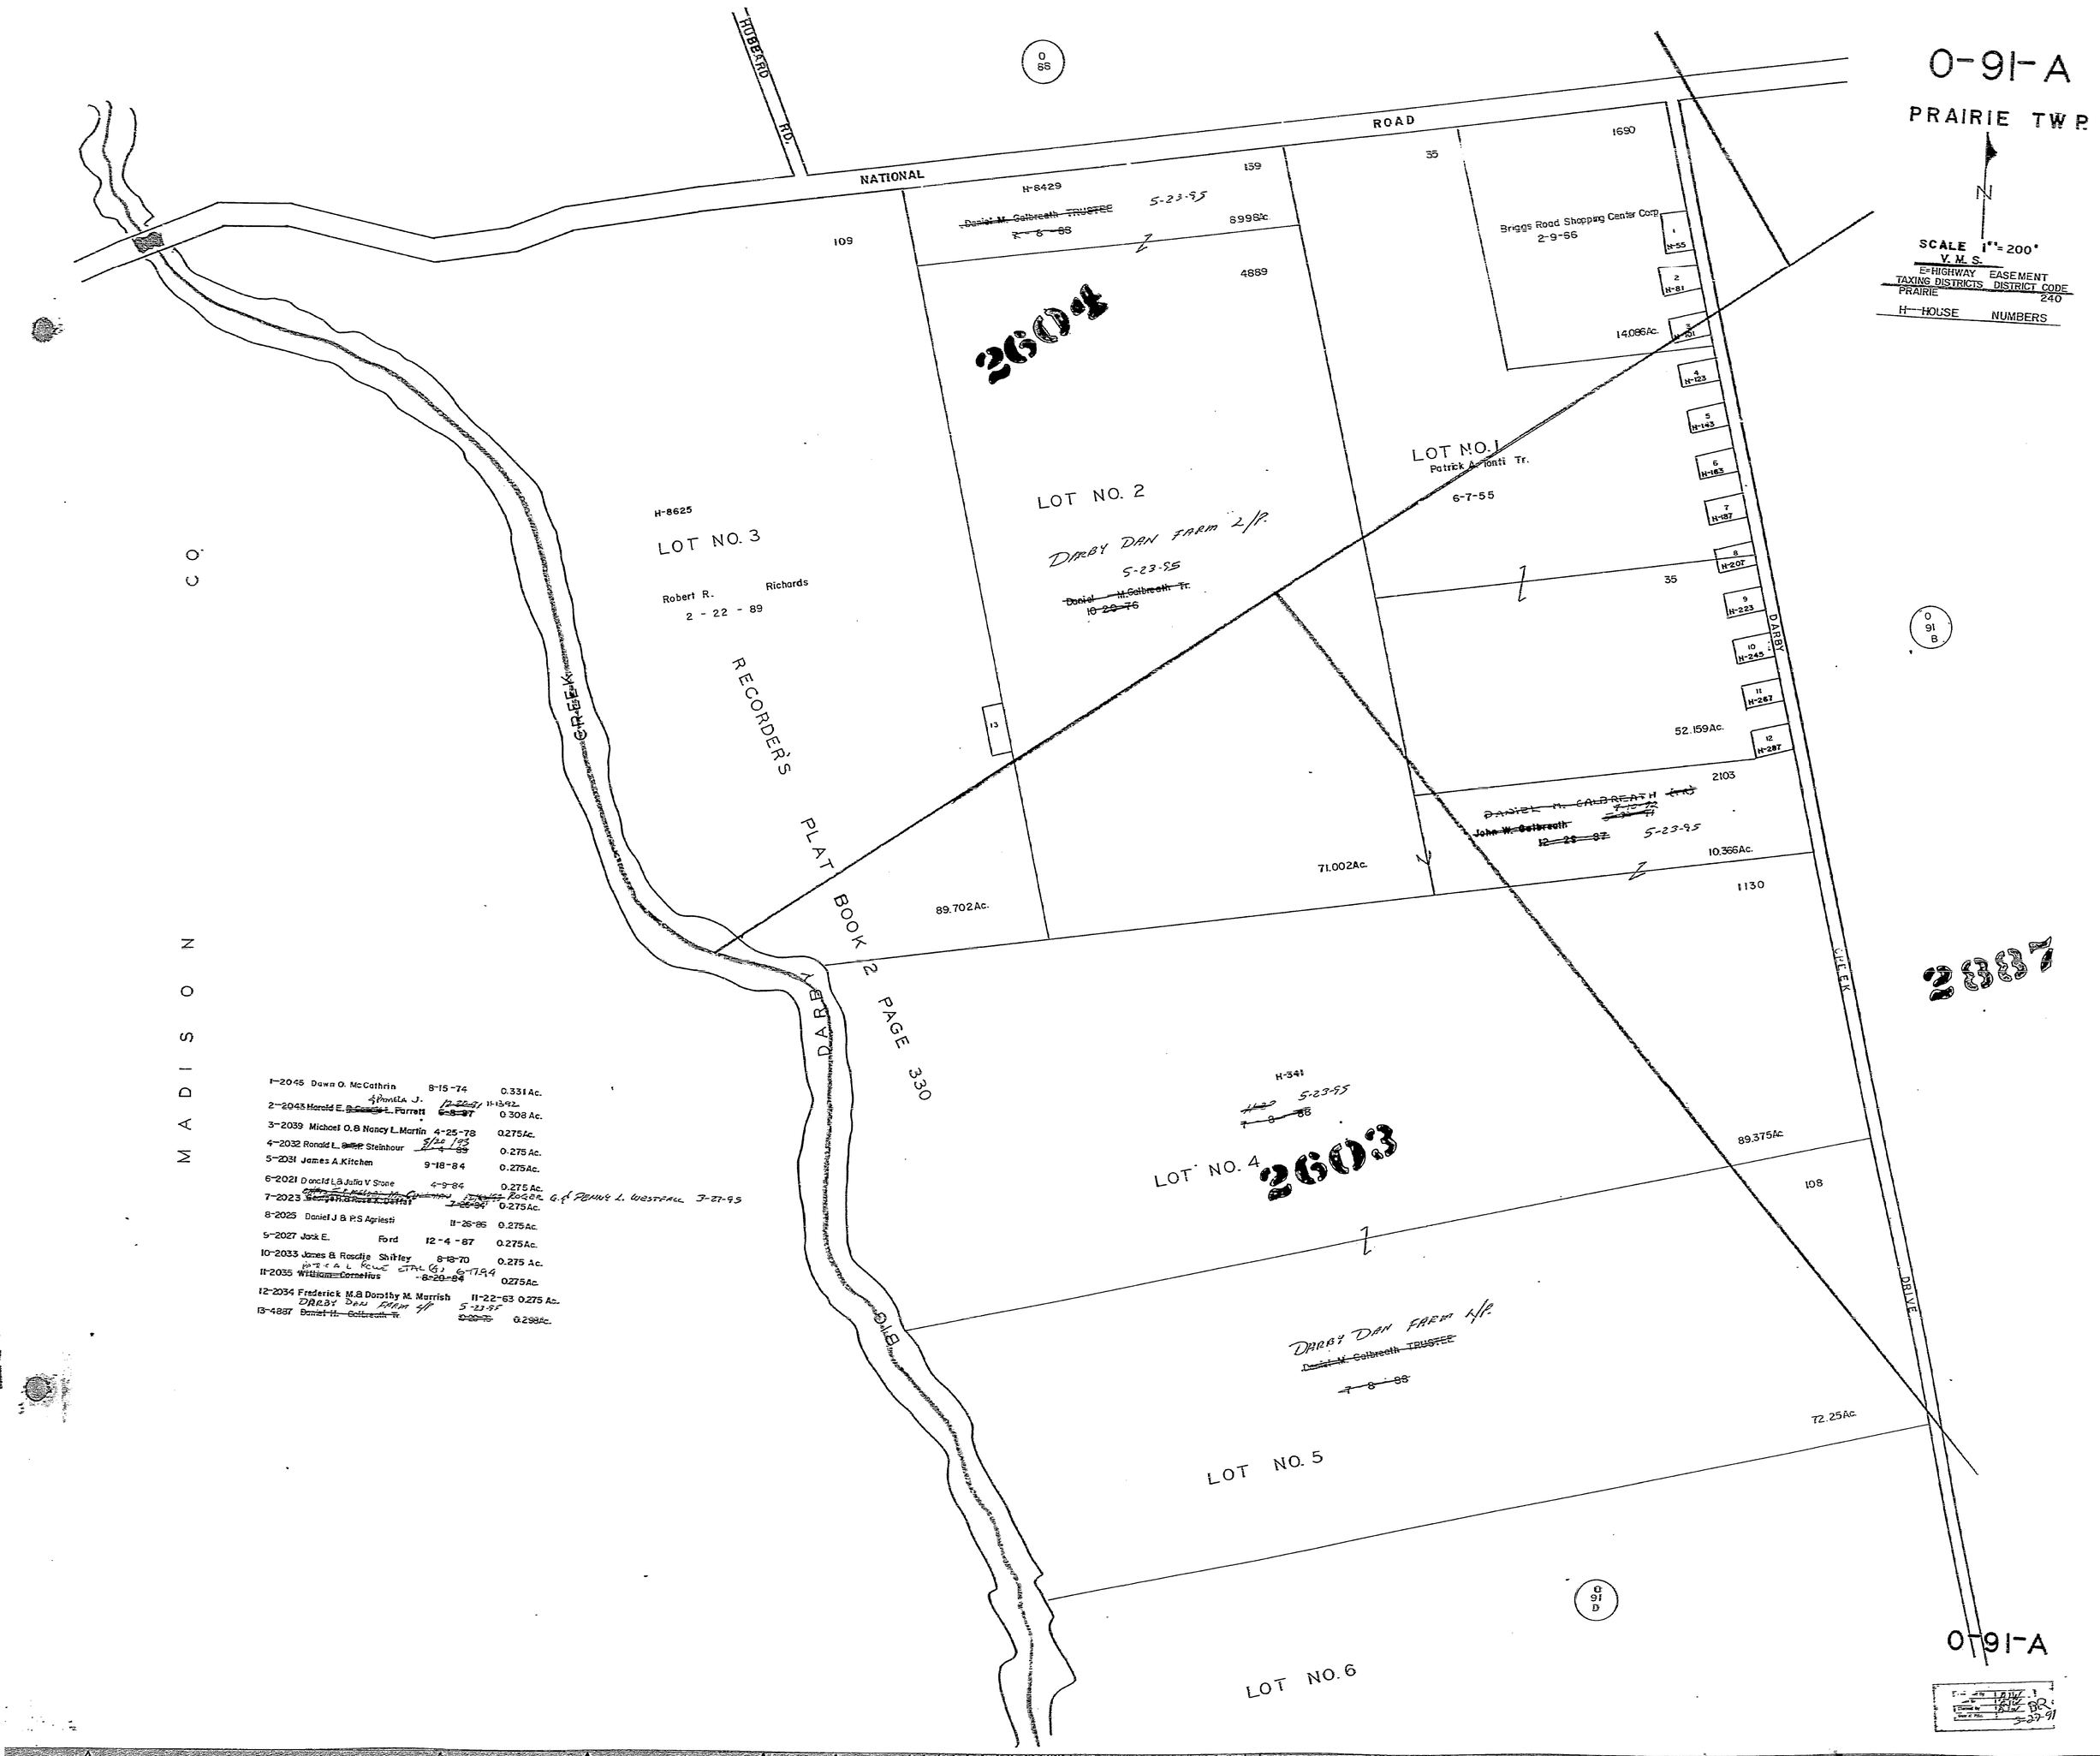
0-91-A
PRAIRIE TWP.
N
SCALE 1" = 200'
V.M.S.
E=HIGHWAY EASEMENT
TAXING DISTRICTS DISTRICT CODE
PRAIRIE 240
H—HOUSE NUMBERS
NATIONAL ROAD
HUBBARD RD.
0 68
0 91 B
159
H-8429
~~Daniel M. Galbreath TRUSTEE~~
~~7-8-88~~
5-23-95
8.998Ac.
109
4889
2604
LOT NO. 2
DARBY DAN FARM L/P.
5-23-95
~~Daniel M. Galbreath Tr.~~
~~10-29-76~~
35
1690
Briggs Road Shopping Center Corp.
2-9-56
14.086Ac.
LOT NO. 1
Patrick A. Tonti Tr.
6-7-55
35
52.159Ac.
2103
~~DANIEL M. GALBREATH TRUSTEE~~
~~John W. Galbreath~~
~~12-29-87~~
5-23-95
10.366Ac.
1130
71.002Ac.
H-8625
LOT NO. 3
Robert R. Richards
2-22-89
RECORDER'S PLAT BOOK 2 PAGE 330
13
89.702Ac.
DARBY CREEK
MADISON CO.
H-341
~~H-23~~
~~7-8-88~~
5-23-95
LOT NO. 4
2603
89.375Ac.
108
DARBY DAN FARM L/P.
~~Daniel M. Galbreath TRUSTEE~~
~~7-8-88~~
72.25Ac.
LOT NO. 5
LOT NO. 6
0 91 D
DARBY CREEK DRIVE
28837
1-2045 Dawn O. McCathrin 8-15-74 0.331 Ac.
2-2043 Harold E. & Pamela J. Forrett ~~8-8-87~~ 12-22-92 11-13-92 0.308 Ac.
3-2039 Michael O. & Nancy L. Martin 4-25-78 0.275Ac.
4-2032 Ronald L. Steinhour 3/24/93 ~~11-4-88~~ 0.275 Ac.
5-2031 James A. Kitchen 9-18-84 0.275Ac.
6-2021 Donald L. & Julia V. Stone 4-9-84 0.275 Ac.
7-2023 ~~Scott Michael Westfall~~ ~~7-26-94~~ Roger G. & Penny L. Westfall 3-27-95 0.275Ac.
8-2025 Daniel J. & P.S. Agriesti 11-26-86 0.275Ac.
9-2027 Jack E. Ford 12-4-87 0.275Ac.
10-2033 James & Rosalie Shirley 8-18-70 0.275 Ac.
11-2035 ~~William Cornelius~~ ~~8-20-84~~ 0.275Ac.
12-2034 Frederick M. & Dorothy M. Marrish 11-22-63 0.275 Ac.
13-4887 DARBY DAN FARM L/P. ~~Daniel M. Galbreath Tr.~~ 5-23-95 ~~10-29-76~~ 0.298Ac.