0-98-D

SHARON TWP.

R.18 ▶ TWP 2

N

SCALE 1"=200'

E = HIGHWAY EASEMENT

TAXING DISTRICTS	DISTRICT CODE
***COLUMBUS	010
****SHARON-WEST.	252
*****WESTERVILLE	080
***COLS. WESTERVILLE S.D.	600

H---HOUSE NUMBERS
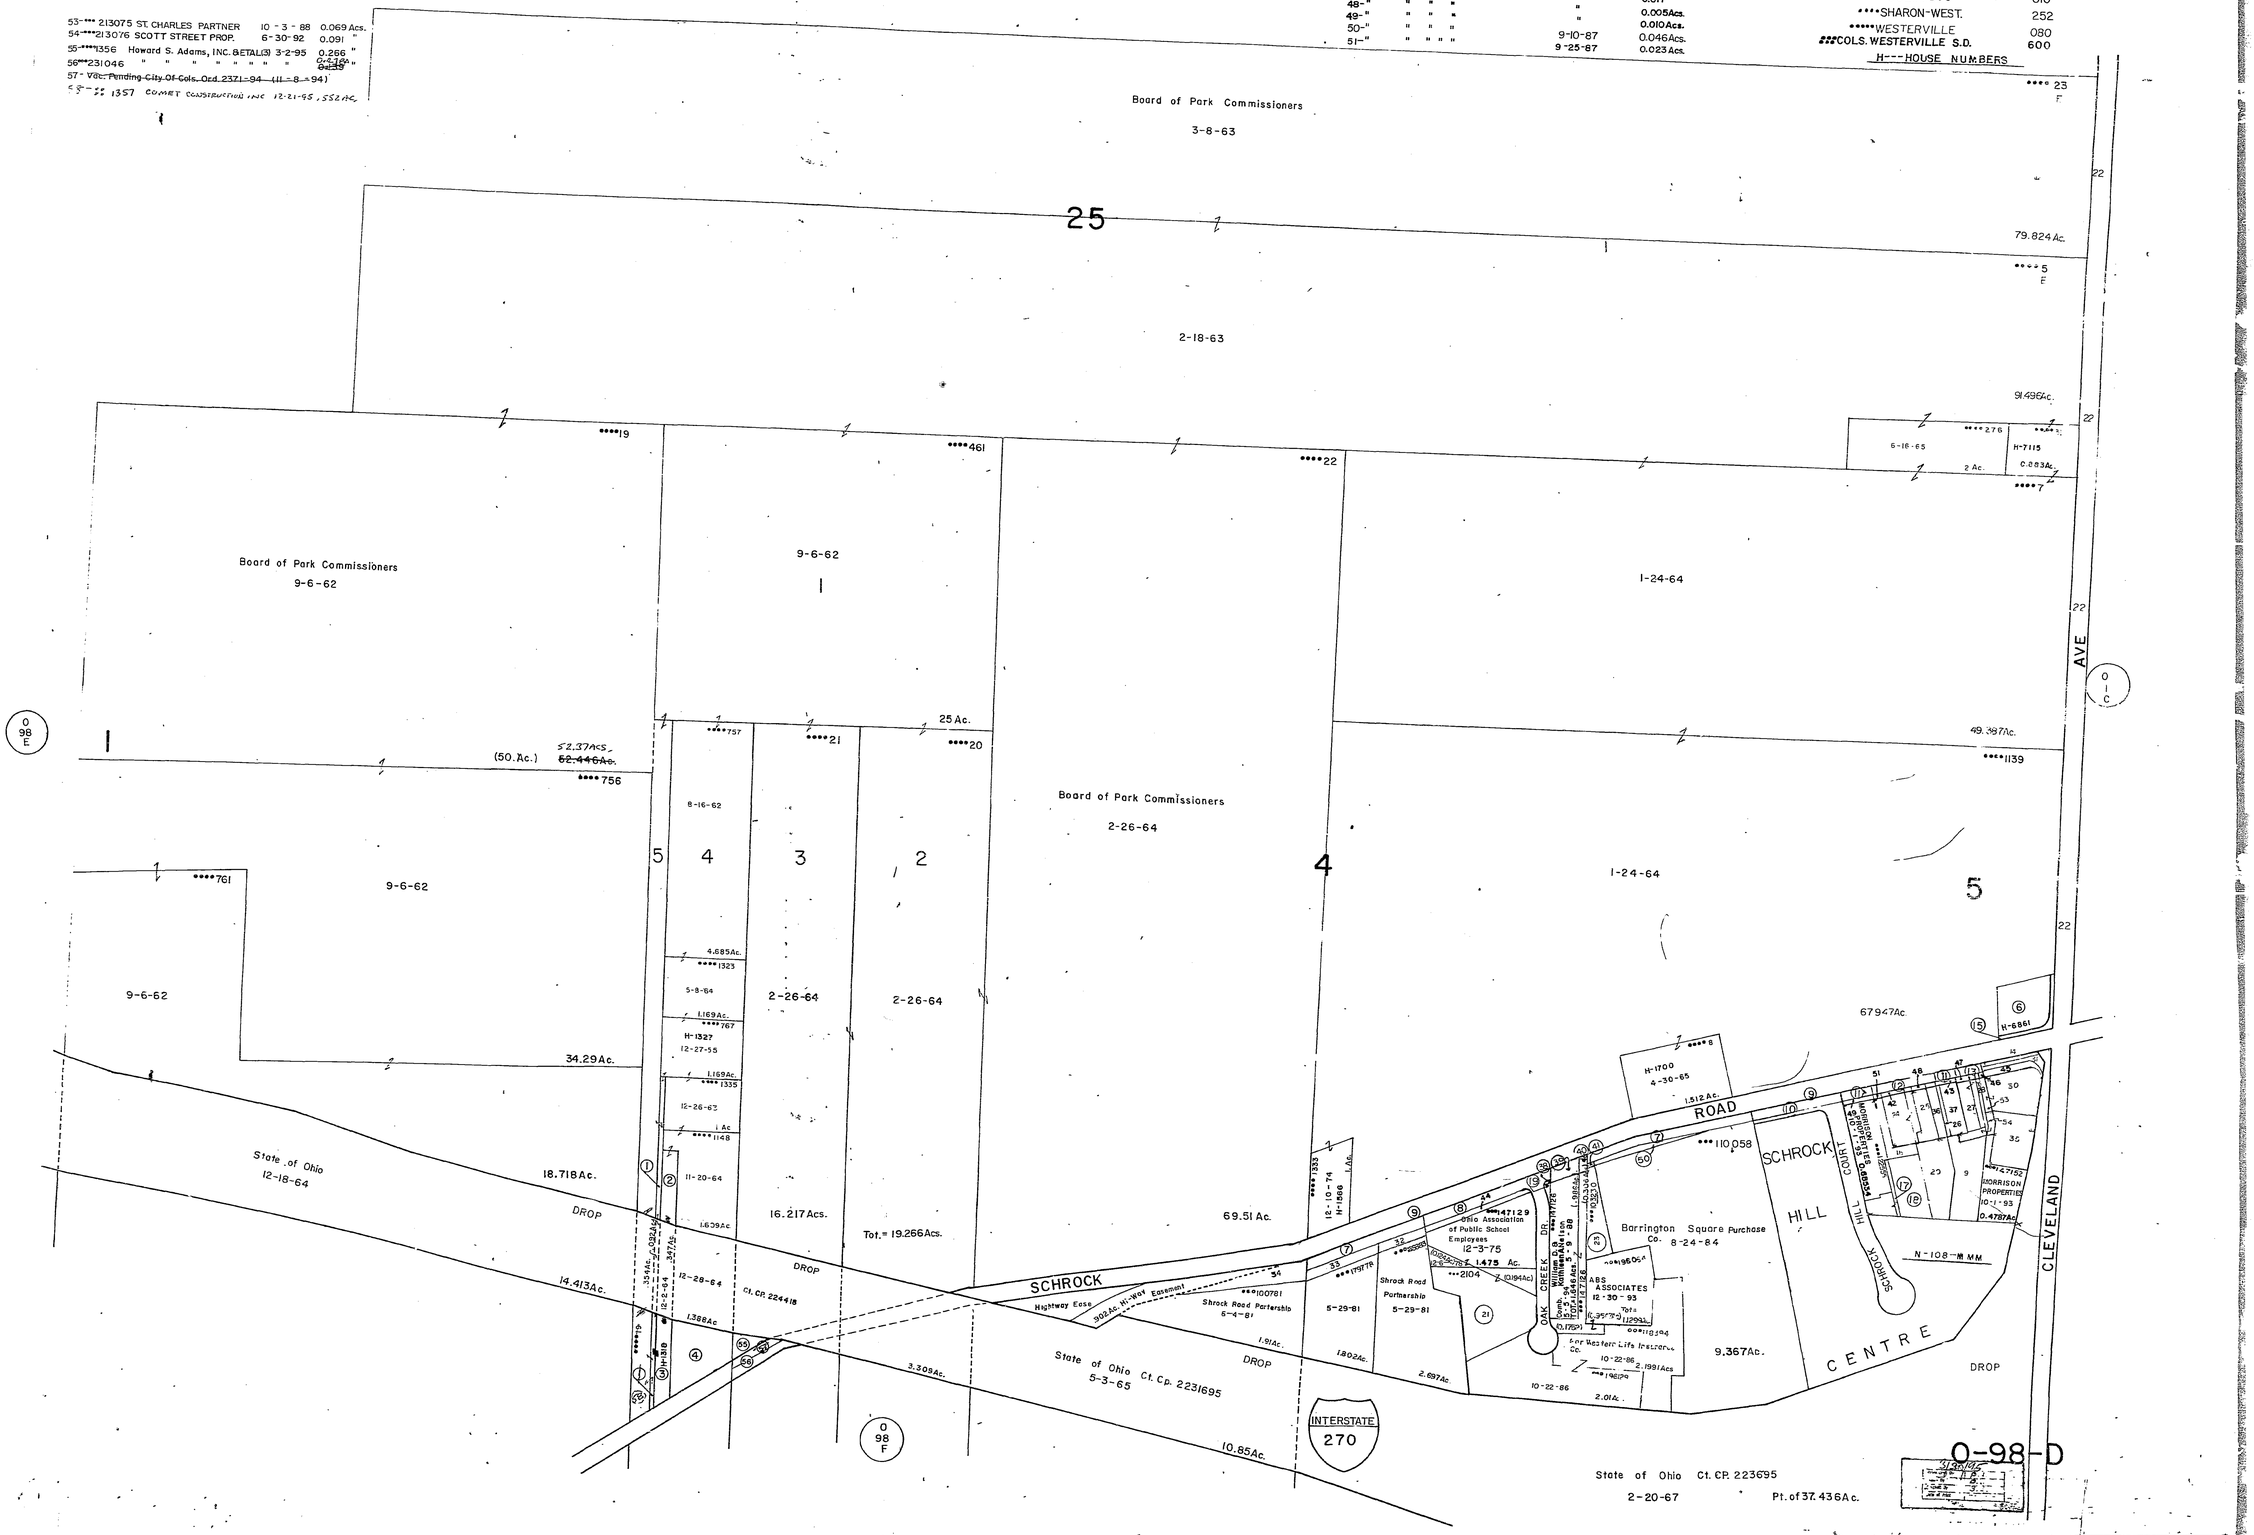
1 ****13 Board of Park Commissioners	1-5-65	~~.263Ac.~~ .233 Ac.	
2 ****759 " " "	11-20-64	.281Ac.	
3 ****265 Howard I.& G.M. Lowery	4-21-56	.372 Ac.	
4 ***226266 W.L. & V.A. Gaddis	9-10-76	1.003 Ac.	
5 ***			
6 ***208645 UNO-VEN COMPANY	12-1-89	.6697Ac.	
7 DROP City of Cols.	3-12-71	.671Ac.	
8 DROP " "	1-17-75	.620Ac.	
9 ***18880 MORRISON PROPERTIES	10-1-93	0.6796Ac.	
10 DROP City of Cols.	3-12-71	.207Ac.	
11 " " "	3-12-71	.177Ac.	
12 " " " "		.275Ac.	
13 " " " "		.158Ac.	
14 DROP Drop Hi-Way Ct 32508		0.1411 Ac.	
15 DROP City of Cols.	7-31-73	.363 Ac.	
16 ***1669 MORRIS PROPERTIES	10-1-93	(0.3941)&(0.00306Ac.	
17 ***17810 " " "		(.044Ac.)&(0.152Ac.) =0.196 Acs.	
18 ***17805 " " "		.459Ac.	
19 ***147128 William D.&Kathleen A. Nelson	8-22-94	.045 Acs.	
20 ***18862 MORRISON PROPERTIES	10-1-93	0.3728 Ac.	
21 ****2104 Ohio Assoc. Of Public School E.M.P.	12-13-79	1.564Ac.	
22 ****8311 Board Of Park Commiss	1-28-81	1.98 Ac.	
23 ***147216 William D.&Kathleen A. Nelson	1-10-85	(0.354Acs.)	
24 - ***190907 Wendy's International Inc.	4-27-82	(0.2872Ac.)&(0.0598Ac.) Tot=0.3701 Acs.	
25 - ***98316 MORRISON PROPERTIES	10-1-93	0.205Ac.	
26 - ***20448 K.F.C. National Management Co.	8-21-85	(0.0449Ac.)	
27 - ***191317 VALVOLINE INSTANT OIL CHANGE INC.	10-25-89	0.2619 Ac.	
28 - ***191317 " " " " "	"	(0.107Ac.)(0.0363Ac.) TOT=0.4222 Ac.	
29 - *****			
30 - ***191334 ST. CHARLES PARTNERS	9-30-87	0.4522 Acs.	
31 - DROP City of Cols (Hi-Way) Ct 32509		0.0844Ac.	
32 - Drop City OF Columbus (Hi-Way)	11-1-92	0.0342Ac.	
33 - Drop " " "		0.1204Ac.	
34 - Drop " " "		1.4962	
35 - ***198720 ~~Pacific Ventures~~ LINDA A.& BRENDA L. PAGEHAUSER	8-31-84	8-31-93 0.5367Ac.	
36 - ***20448 K.F.C. National Management Co.	8-21-85	0.106Ac.	
37 - ***20448 " " "	"	(0.0013Ac)(0.1386Ac)(0.1004Ac) Total=0.3572 Ac.	
38 - Drop City of Cols (Hi-Way)		(0.0006 Acs.)	
39 - Drop City of Cols	9-19-86	0.166Acs	
40 - Drop " " "	10-22-86	.0.055 Acs.	
41 - Drop " " "	10-22-86	0.004 Acs	
42 - Drop " " "	2-27-87	0.023 Acs.	
43 - " " " "	3-3-87	0.034 Acs.	
44 - " " " "	6-30-87	0.168 Acs.	
45 - " " " "	7-13-87	0.080 Acs.	
46 - " " " "	"	0.013 Acs.	
47 - " " " "	"	0.017 "	
48 - " " " "	"	0.005 Acs.	
49 - " " " "	"	0.010 Acs.	
50 - " " " "	9-10-87	0.046 Acs.	
51 - " " " " "	9-25-87	0.023 Acs.	
53 - *** 213075 ST. CHARLES PARTNER	10-3-88	0.069 Acs.	
54 - ****213076 SCOTT STREET PROP.	6-30-92	0.091 "	
55 - ****1356 Howard S. Adams, INC. & ETAL (3)	3-2-95	0.266 "	
56 - ***231046 " " " " " " " "		~~0.4750~~ 0.4750 "	
57 - Vac. Pending City Of Cols. Ord. 2371-94 (11-8-94)			
58-55 1357 COMET CONSTRUCTION INC	12-21-95	.552Ac.