0-101-C

TRURO TWP.

R. 21 TWP. 12

N

SCALE 1"=200'

E = HI-WAY EASEMENT

TAXING DISTRICT	DISTRICT CODE
WHITEHALL	090

H--HOUSE NUMBERS

1	DROP	City of Whitehall	3-19-73	0.066 Ac
2	"	" " "	3-19-73	0.576 Ac
3	48	Esther J. Early	12-16-91	0.56 Ac
4	1007	Dragan Saveski	3-25-82	0.219 Ac
5	633	William M. McGlaughlin	9-14-87	0.239 Ac
6	737	The McGlaughlin Oil Co.	8-11-86	0.53 Ac
7	896	KEMBA Columbus Credit Union Inc	5-24-73	0.06 Ac
8	896	" " " " "	5-24-73	0.3889 Ac. 1-26-84
9	13	Hamilton Acceptance Corp	2-15-89	Tot=0.2411 Ac.
10	13	" " " " "		
11	DROP	City of Whitehall	4-23-74	0.011 Ac.
12	2487	Jack Bloom	12-30-86	0.324 Ac.
13	5630	" "	"	0.3241 Ac.
14	1834	" " (Fee)	"	0.273 Ac.
15	32	Venus Sparks	10-16-73	0.1926 Ac.
16	6757	Robert J. & Linda K. Robert	12-2-74	0.383 Ac.
17	7560	Marguerite Larimer	1-22-87	0.159 Ac
18	2483	" "	"	0.17 Ac.
19	7497	Beulah T. Grandinetti	1-24-80	0.17 Ac.
20	2482	~~Merle & Janet M. Stewart~~ JOHN R. PATTERSON	~~8-11-94~~ 10-17-94	0.17 Ac.
21	3852	~~Pam A. Collis~~ GARY E. LAMB	~~10-1-84~~ 5-11-95	0.17 Ac.
22	2174	Rodney W. & Alice A. M. Rice	6-8-71	0.17 Ac.
23	4313	Elizabeth A. Anderson	6-25-92	0.17 Ac
24	7609	Marvin & Theresa Thompson	8-4-75	0.17 Ac.
25	47	Marguerite W. Larimer	2-4-87	0.142 Ac.
26	3775	CAROL J. HETRICK ~~Carol J. & Robert E. Hetrick (LE)~~	2-11-92 ~~5-8-91~~ ~~6/11/94~~	0.142 Ac.
27	5611	Board of Library Trustees of the Library of Columbus & Franklin County	1-31-77	0.59 Ac.
28	347	Board of Library Trustees of the Library of Columbus & Franklin County	1-31-77	0.289 Ac.
29	34	William M. & Deborah R. Angeletti	1-31-86	0.179 Ac
30	DROP	City of Whitehall	8-28-61	0.360 Ac.
31	96	Ashland Inc	5-25-79	0.50 Ac
32	543	Schmidt and Company	4-8-53	0.46 Ac
33	8217	Sherwin Williams Development Corporation	3-5-85	0.0887 Ac.

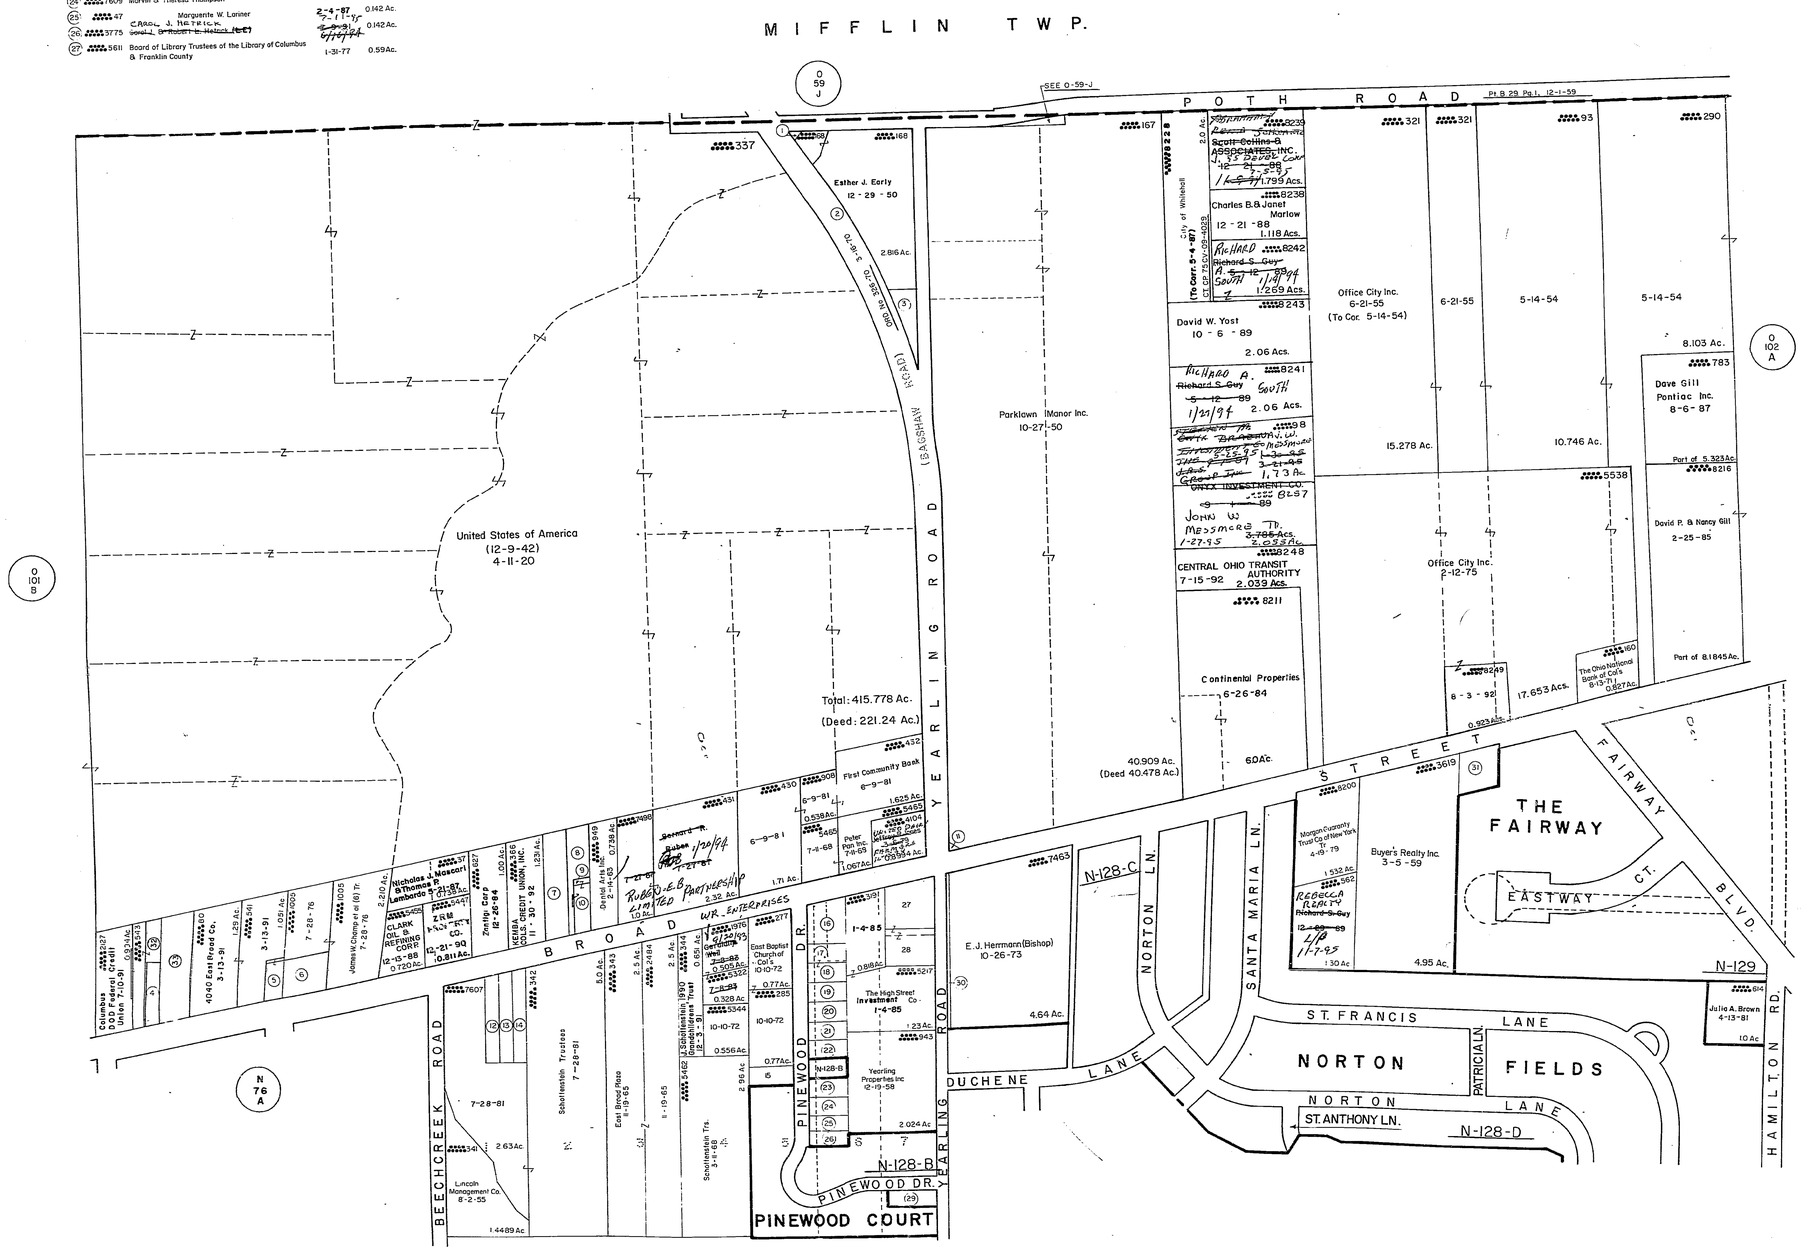

O-101-C

Plan Prep By	J. C.
Chk'd By	
Checked By	
Date Of Issue	5/16/95