



0-107-E  
WASHINGTON TWP.

SCALE 1" = 200'  
V.M.S.

E = HIWAY EASEMENT  
TAXING DISTRICT DISTRICT CODE  
WASHINGTON 270  
\* WASH, DUBLIN CORP 273

H--HOUSE NUMBERS

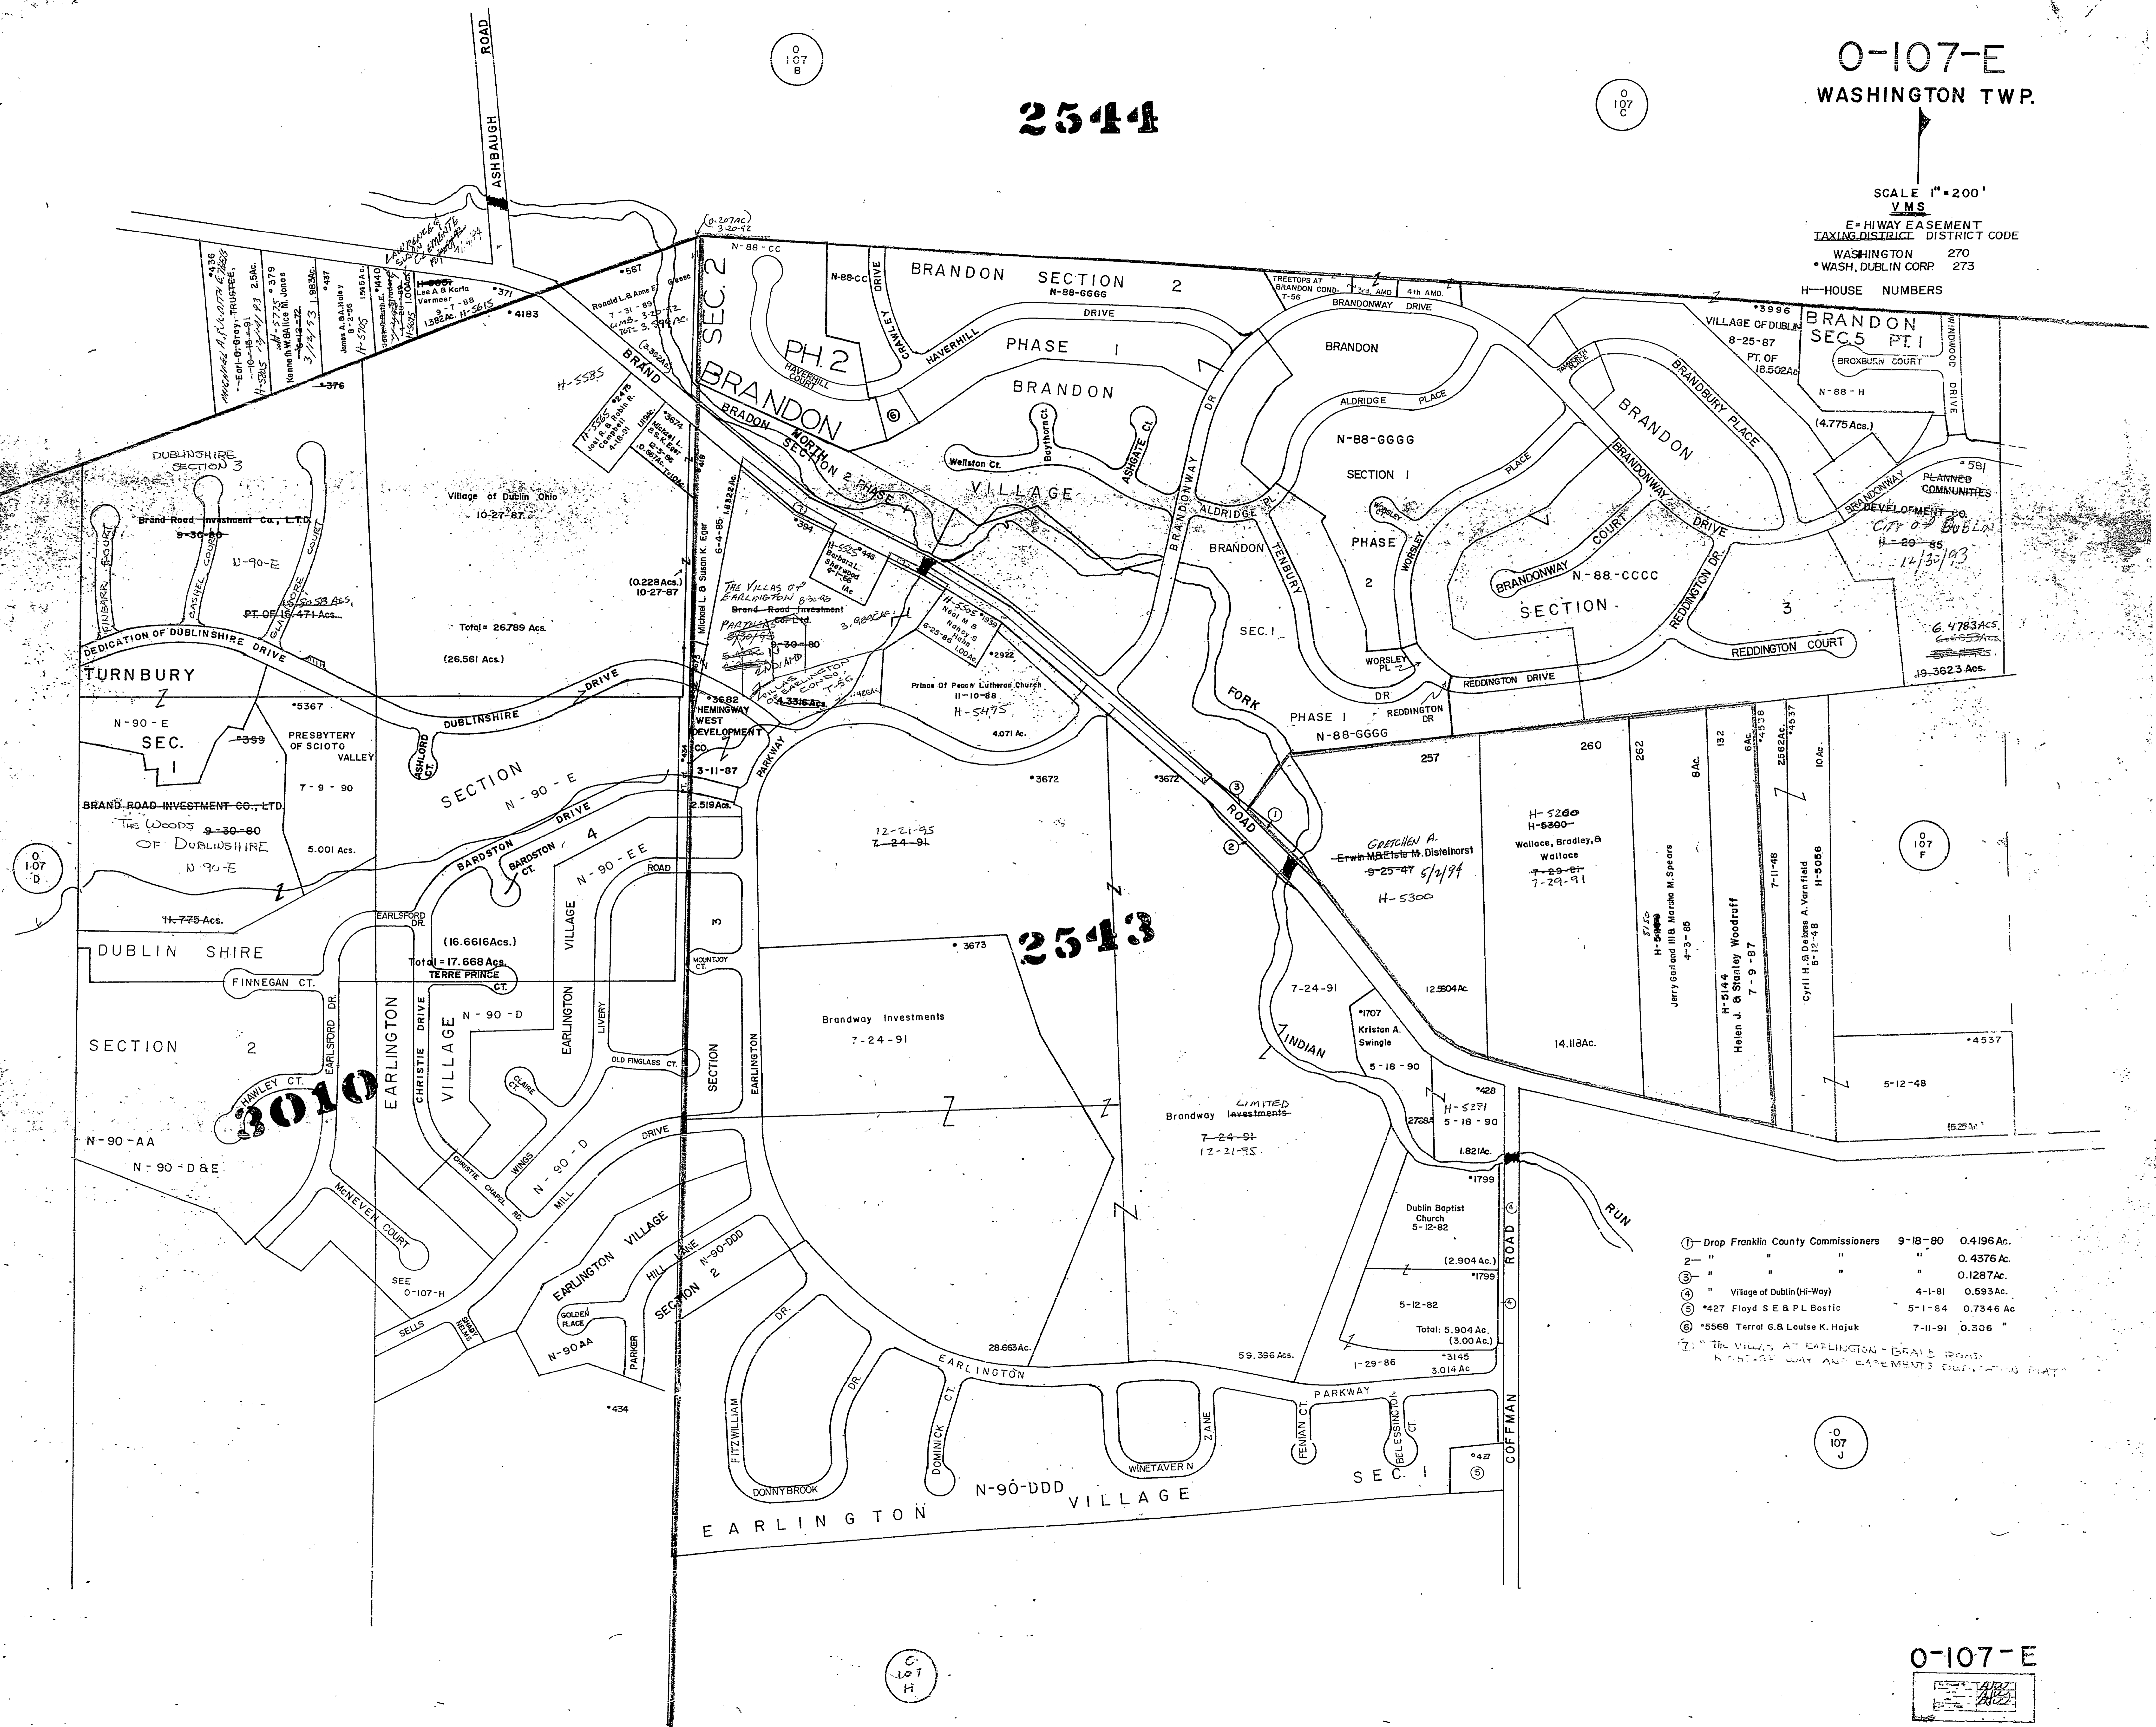

①	Drop Franklin County Commissioners	9-18-80	0.4196 Ac.
②	"	"	0.4376 Ac.
③	"	"	0.1287 Ac.
④	Village of Dublin (Hi-Way)	4-1-81	0.593 Ac.
⑤	*427 Floyd S & P L Bostic	5-1-84	0.7346 Ac.
⑥	*5568 Terrol G & Louise K. Hajak	7-11-91	0.306 "

0-107-E

