# Survey Plat Showing a 5.924 acre tract, located in Virginia Military Survey No. 5985, in Brown Township, Franklin County, Ohio

for

Mr. Gary J. Cook
3400 Walker Road
Hilliard, Ohio 43026

0 - 8 - B

7660732
7857350

0 100 200 400

Scale 1"=200'
December 16, 1993

*Basis of Bearings from O.R. 24191, A-17 based on the centerline Walker Road.*

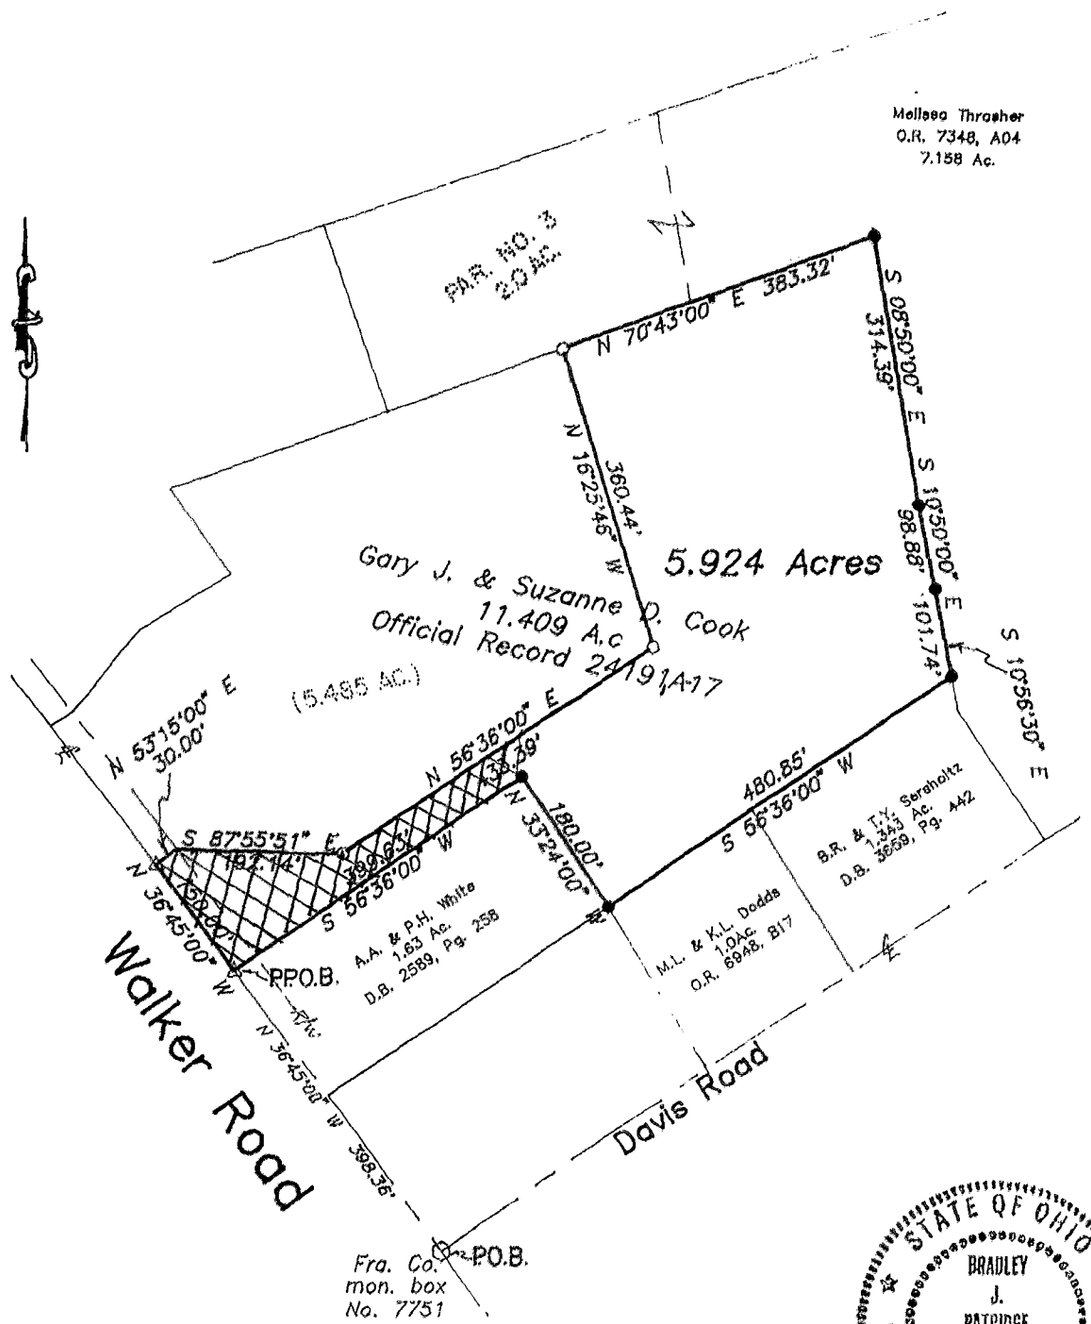


## LEGEND

- ● *fnd. iron pin*
- ○ *set iron pin (capped PATRIDGE SURVEYING)*
- ⬡ *Franklin Co. monument box*
- △ *Set PK nail*

STATE OF OHIO
BRADLEY J. PATRIDGE
7068
REGISTERED PROFESSIONAL SURVEYOR

*I hereby certify that I have surveyed the property described in the foregoing title caption, and that said survey and plat are accurate and correct to the best of my knowledge. Easements, restrictions, and rights-of-way not located, unless noted.*

Bradley J. Patridge
Professional Surveyor No. 7068


*PREPARED BY*
R. T. PATRIDGE AND ASSOCIATES
PROFESSIONAL SURVEYORS AND ENGINEERS
8460 DUBLIN ROAD
POWELL, OHIO 43065
FAX (614)-881-5038
TEL. (614)-881-5575


Brown Twp
0-8-B

Cook

1953-93