
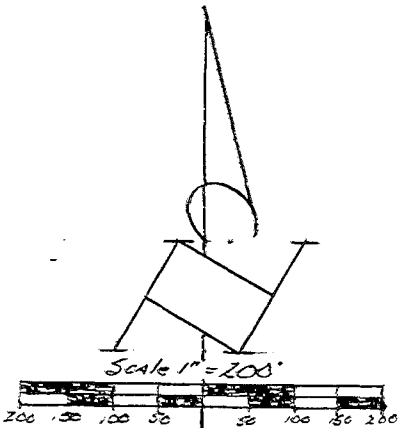


Exhibit "A-1"

Survey of Five Tracts
in WMS 2605, Brown Township,
Franklin County, Ohio

3-11-8

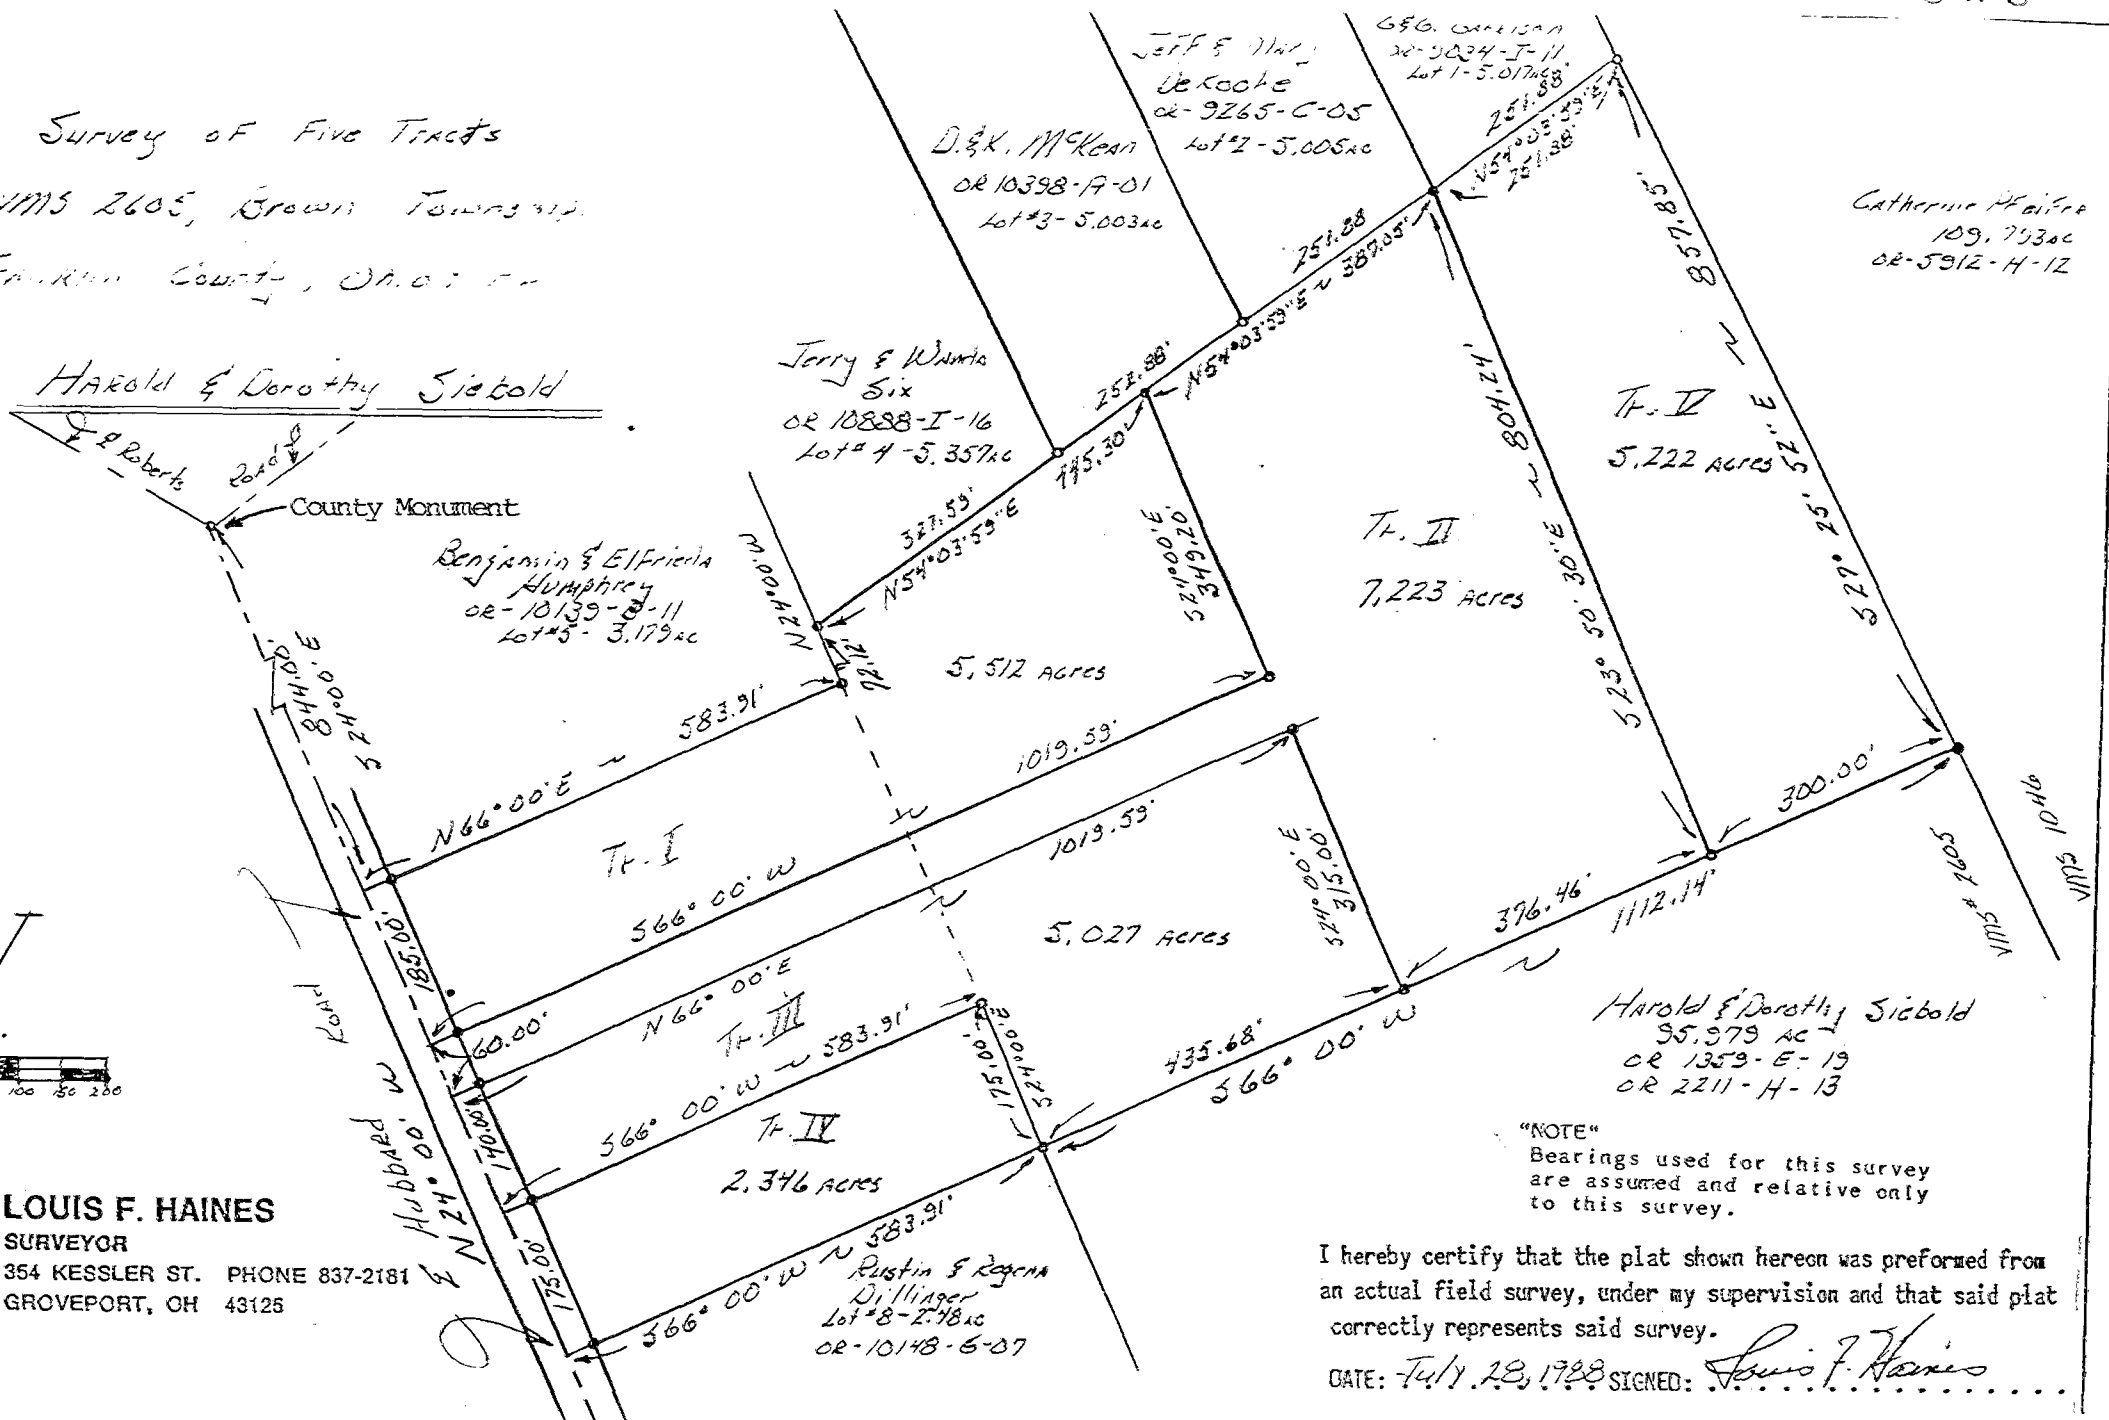

LOUIS F. HAINES
 SURVEYOR
 354 KESSLER ST. PHONE 837-2181
 GROVEPORT, OH 43125

"NOTE"
 Bearings used for this survey
 are assumed and relative only
 to this survey.

I hereby certify that the plat shown hereon was performed from
 an actual field survey, under my supervision and that said plat
 correctly represents said survey.

DATE: July 28, 1988 SIGNED: *Louis F. Haines*