
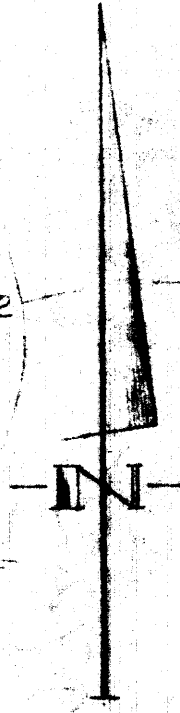



N-42-B

ROAD

ALTON LARBY ROAD
CREEK

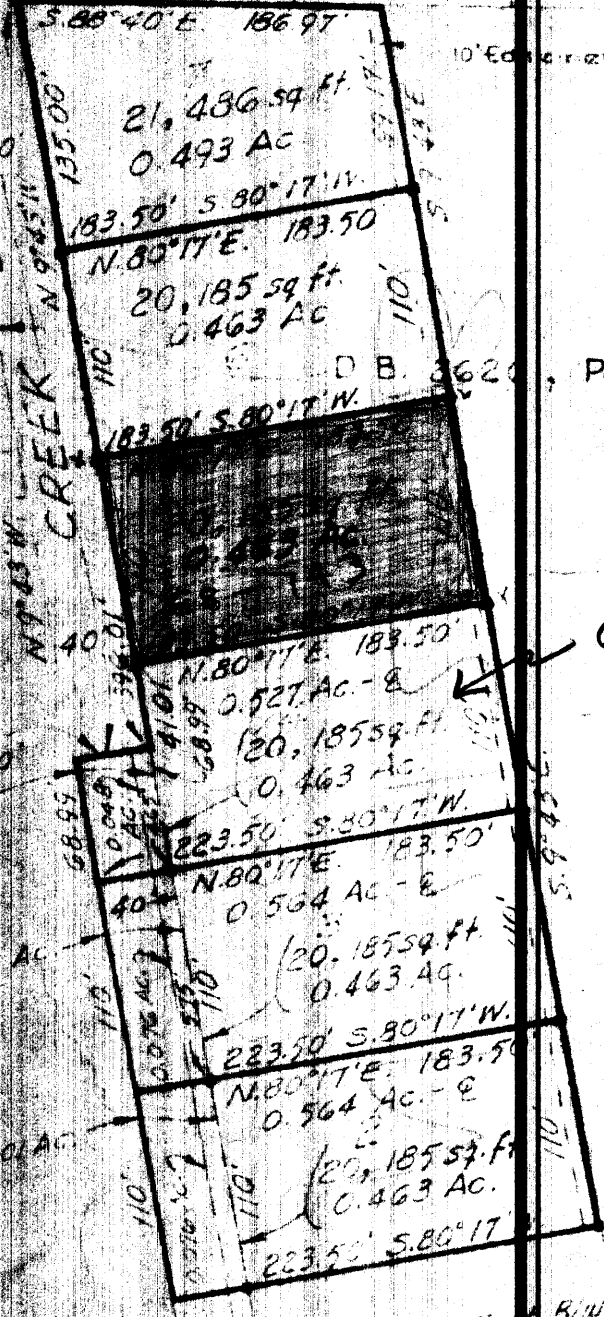

July 8, 1967.
 Scale 1" = 100'
 Revised April 22, 1967
 May 18, 1967

 

Plot showing various Ac. Tracts in V. A. Lands, Survey No. 2635, Norwich Township, Franklin County, Ohio, being part of the lands conveyed to GREEN MEADOW DEVELOPMENT, as of record in Deed Book 2620, Page 462, Recorder's Office, Franklin County, Ohio.

Harry L. Greene
 Harry L. Greene, Reg. Surveyor - No. 4058.