


NEWICH Twp
 2-64-E

M-E BUILDING CONSULTANTS, INC.
CIVIL ENGINEERING DIVISION
 1015 EAST BROAD STREET
 COLUMBUS, OHIO 43205
 (614) 258-4903


C-4-E

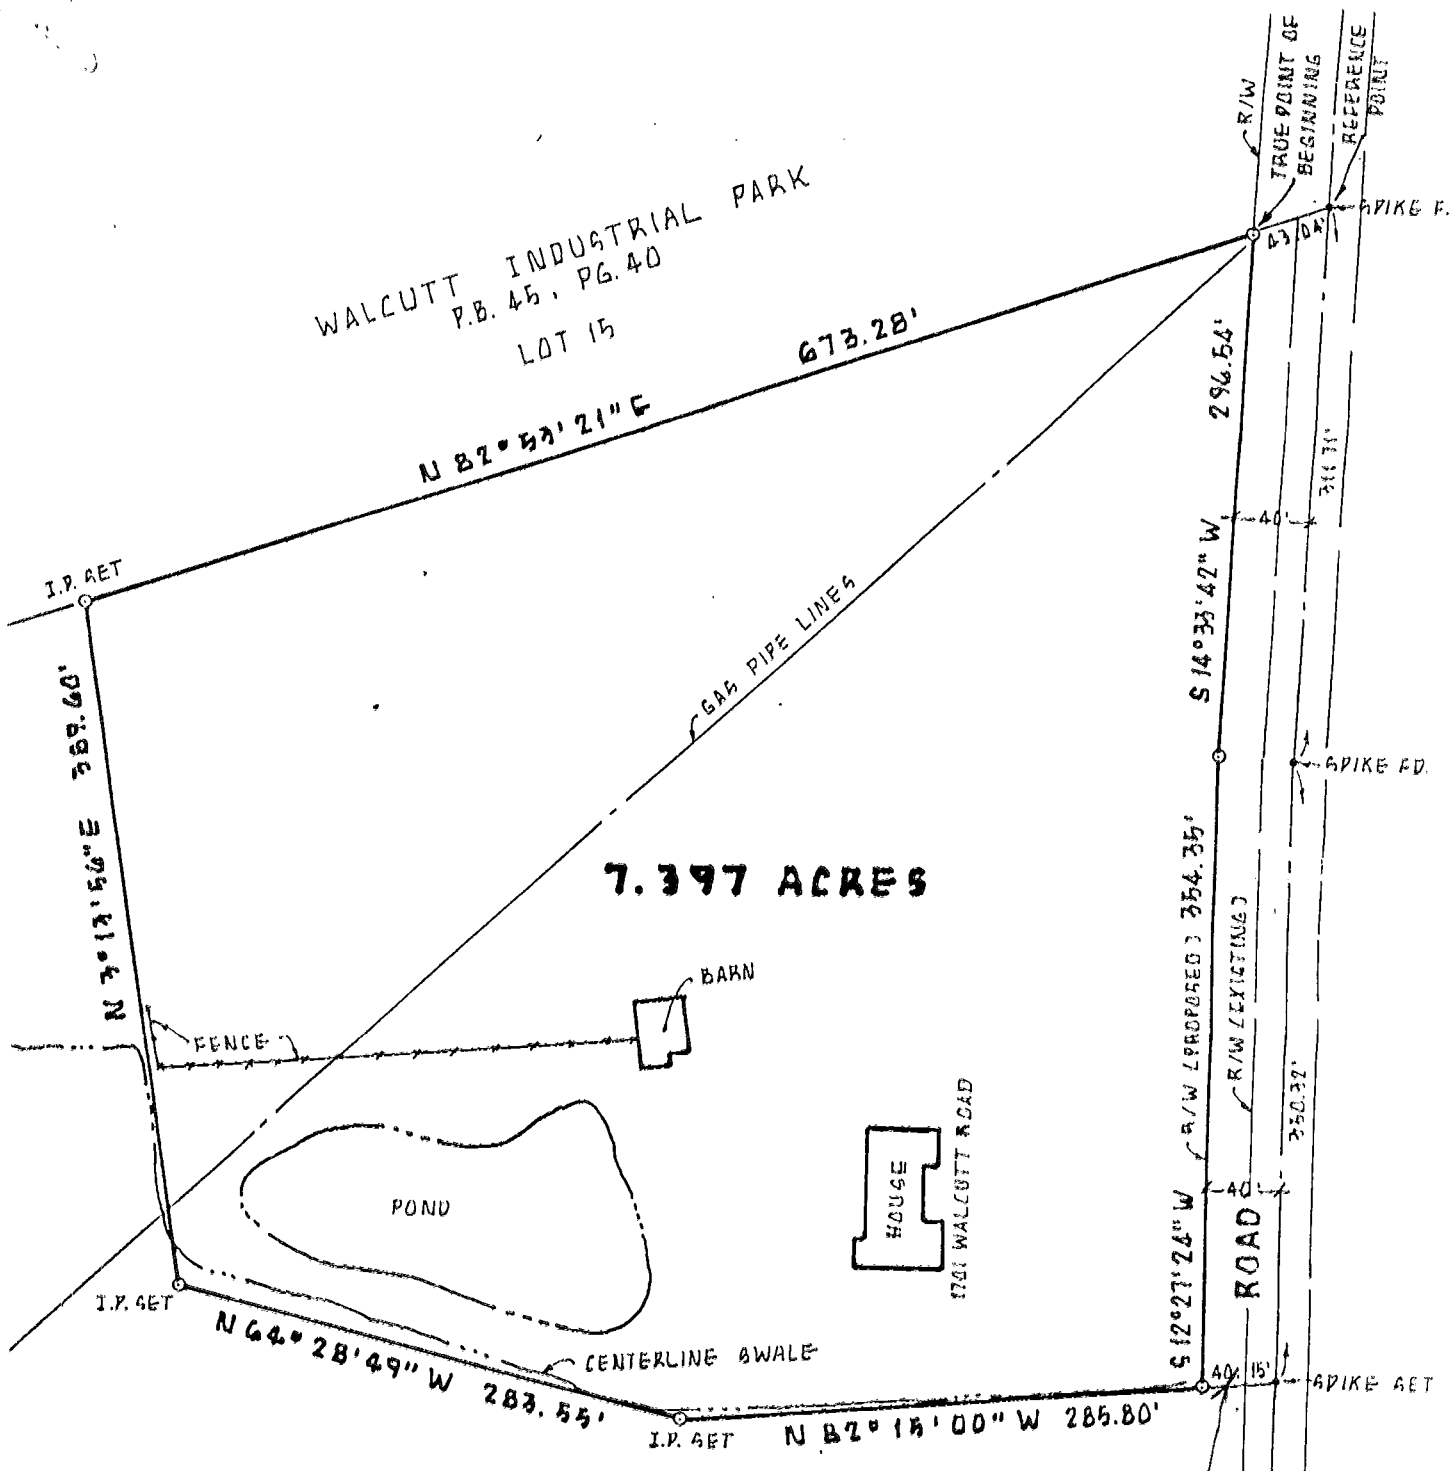

DORCUS RIEBEL WILLIAMS
 69.307 ACRES
 D.B. 3675, PG. 564

TOTAL OF
 0.003 ACRES
 IN R/W

0.003 ACRES
 IN EXISTING
 (R/W)

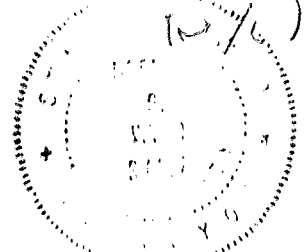

BY: *Robert Sedw...*
 REGISTERED SURVEYOR 6872



SCALE 1" = 100'

DATE: 1-14-87	B6102BC
REVISED DATES	JOB NUMBERS
1-22-87	(R/W OUT)

SURV'D. E. MCB.	DRAWN RAW	CHECKED DHM.
--------------------	--------------	-----------------

572/5725