


M-E BUILDING CONSULTANTS, INC.
 CIVIL ENGINEERING DIVISION

1015 EAST BROAD STREET
 COLUMBUS, OHIO 43205
 (614) 258-4903

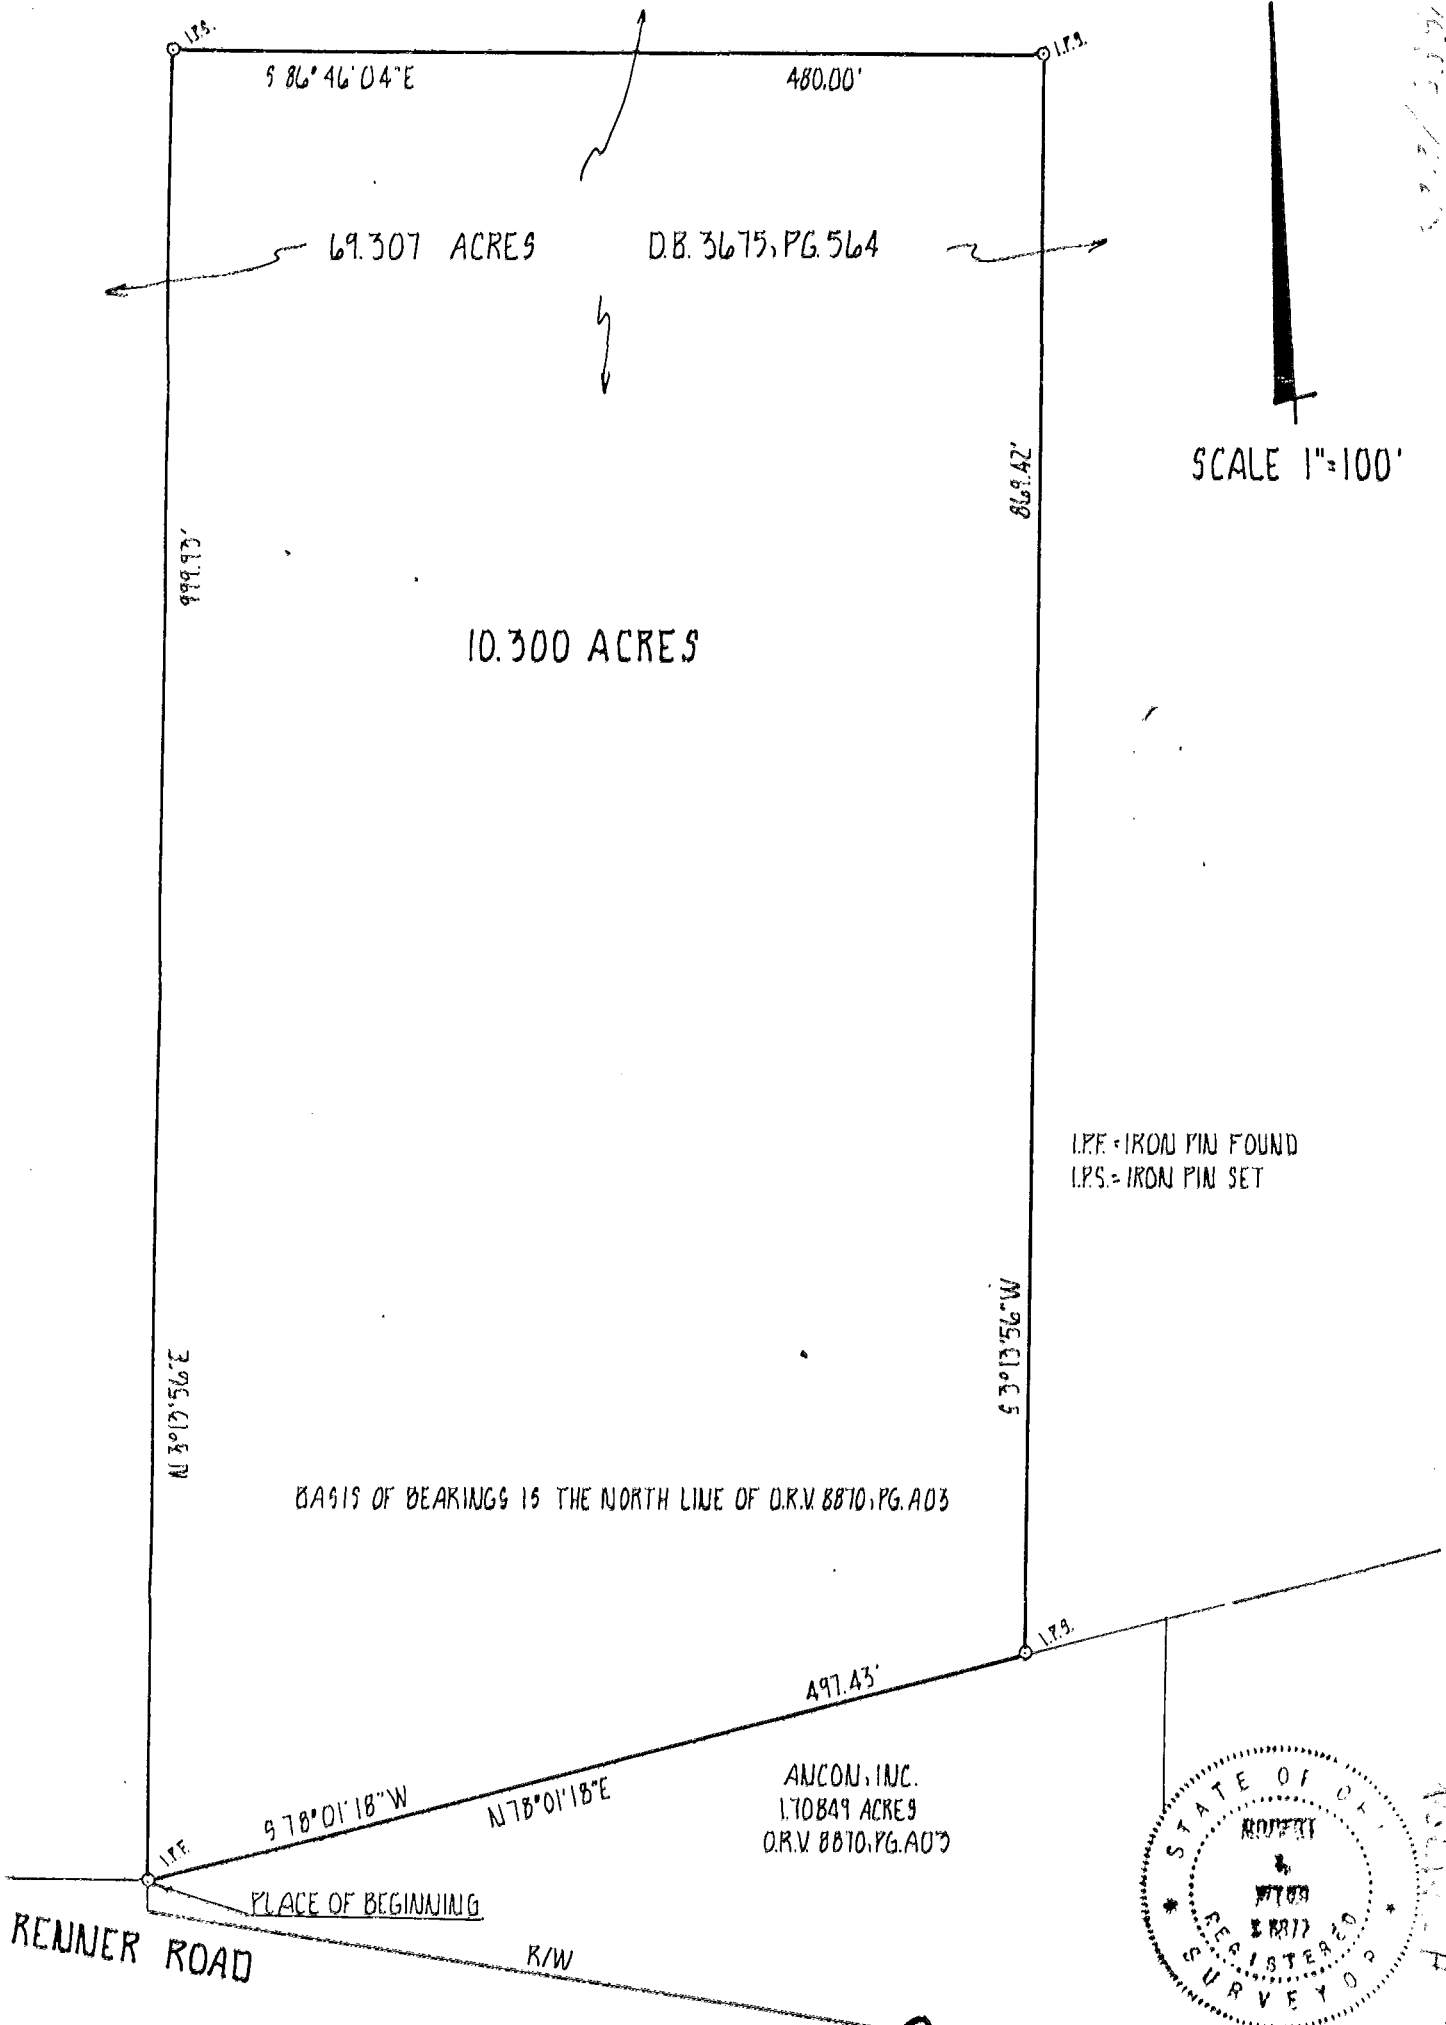


SCALE 1"=100'

I.P.F. = IRON PIN FOUND
 I.P.S. = IRON PIN SET

BASIS OF BEARINGS IS THE NORTH LINE OF D.R.V. 8870, PG. A03

ANCON, INC.
 1.70849 ACRES
 O.R.V. 8870, PG. A03

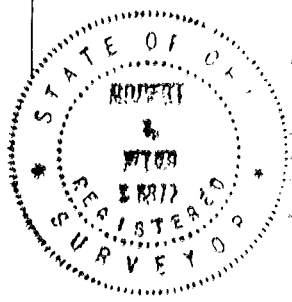

SCALE 1"=100'

| | |
|---------------|-------------|
| DATE: 6-4-87 | 861026C |
| REVISED DATES | JOB NUMBERS |
| | |
| | |

| | | |
|---------|--------|---------|
| SURV'D. | DRAWN | CHECKED |
| M.M. | D.H.M. | |

BY *Robert S. [Signature]*
 REGISTERED SURVEYOR
 6872