

PRAIRIE TWP.
Q-90-B

NW COR. OF CHRISTIAN
CARL SUBDIVISION.
P.B. # PAGE 476

TRABUE ROAD (60')

THIS IS A COPY of
"0"-90
0-90 B

S. 78°30' W. → 146.65'

N. 6°58' E. → 184.58'

0.050 ACRES

S. 87°19' E. → 147.33'

N. 78°15'

24.70'

32.40'

N. 78°15' W.

SE. Cor. of
0.430 Acre
Tract.


N. 4°40' W. → 116.06'
0.032 ACRES.

(S.W. Cor. of
1.242 Acre
Tract.

SOUTH LINE OF
4.758 ACRES.

SCALE OF PLAT: 1" = 40'

⊙ Symbol indicates Iron Pin.

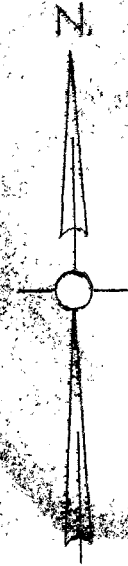

SURVEY OF 0.050 ACRES (PART OF A 0.430 ACRE TRACT), AND
0.032 ACRES (PART OF A 1.242 ACRE TRACT), ALL OF SAID SURVEY
BEING PART OF A 4.758 ACRE TRACT, DEEDED TO ROBT. GINSBERG
BY DEED, RECORDED IN DEED BOOK 1277, PAGE 191, OF
THE FRANKLIN COUNTY RECORDS.

SITUATED IN THE STATE OF OHIO, COUNTY OF FRANKLIN,
TOWNSHIP OF PRAIRIE, AND PART OF V.M.S. NO. 2988.

SURVEYED NOV. 24, 1956 FOR
MR. ROBT. GINSBERG.

Harold N. Glassburn
Reg. Surveyor No. 4209

7/11/57 225

003
0902
1956
AD
5
004
120
120
4650