


79607175

79957175

PRAIRIE TWP

C-839-B

OLD FISHER ROAD

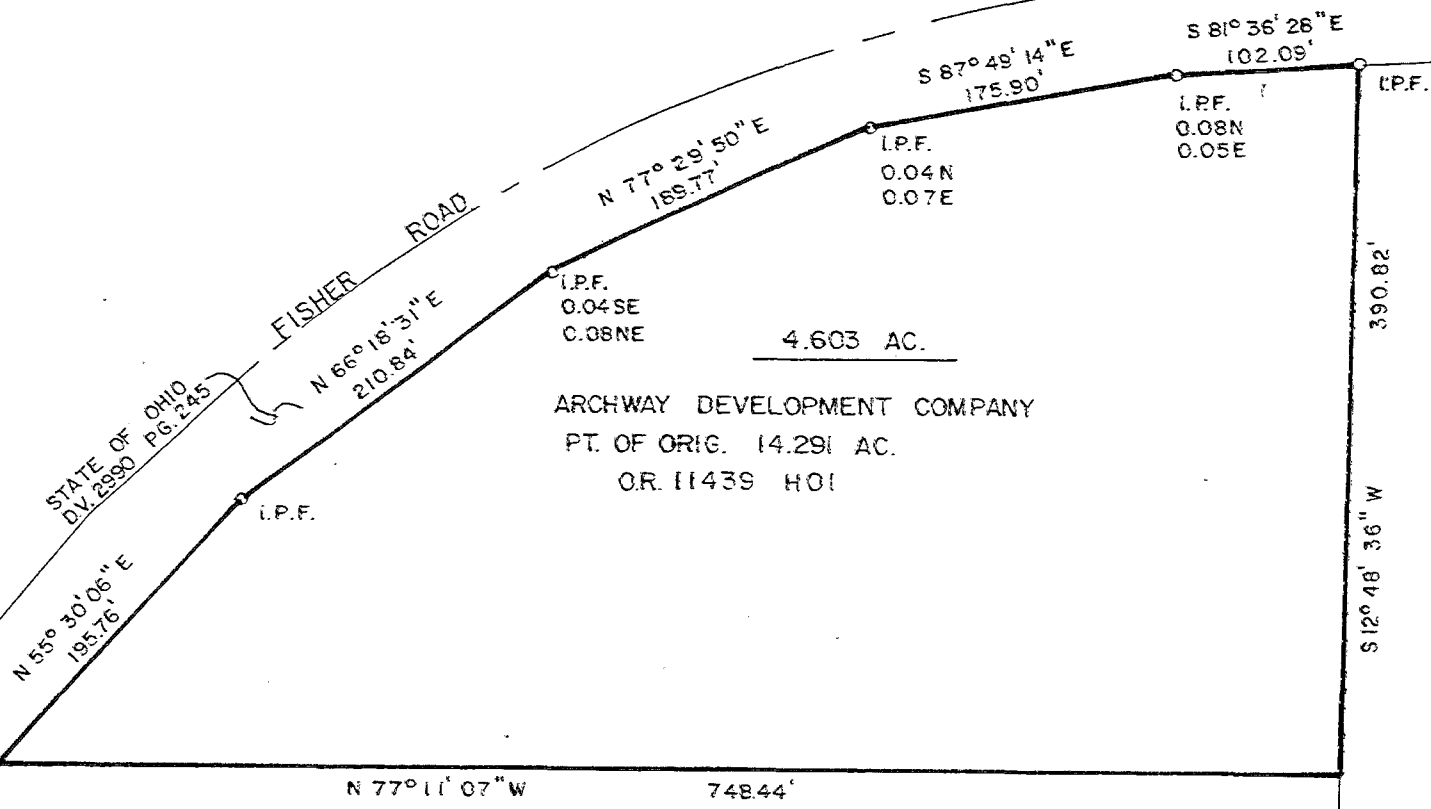

4.603 AC.

ARCHWAY DEVELOPMENT COMPANY
PT. OF ORIG. 14.291 AC.
O.R. 11439 HO1

5267 FISHER ROAD LIMITED PARTNERSHIP
9.019 AC.
O.R. 11788 F13

ELSTON - RICHARDS STORAGE CO.
21.583 AC. D.V. 3628 PG. 845

THE BEARING DATUM IS BASED ON
BEARINGS ALONG THE SOUTHERLY
RIGHT-OF-WAY OF FISHER ROAD,
AS SHOWN IN THE DEED TO THE
STATE OF OHIO, (OF RECORD) IN
DEED VOLUME 2990, PAGE 245.

E. Staudenmann

SURVEY OF
4.603 ACRES
FISHER ROAD
CITY OF COLUMBUS, OHIO
SCALE 1" = 100' JUNE, 1989
R.D. ZANDE & ASSOCIATES LTD.,
1237 DUBLIN ROAD
COLUMBUS, OHIO 43215
(614) 486-4383