HOCKADEN-LIPES-ROUSCULP, INC.
CONSULTING ENGINEERS
2607½ N. HIGH ST.
COLUMBUS, OHIO

PRAIRIE TWP.

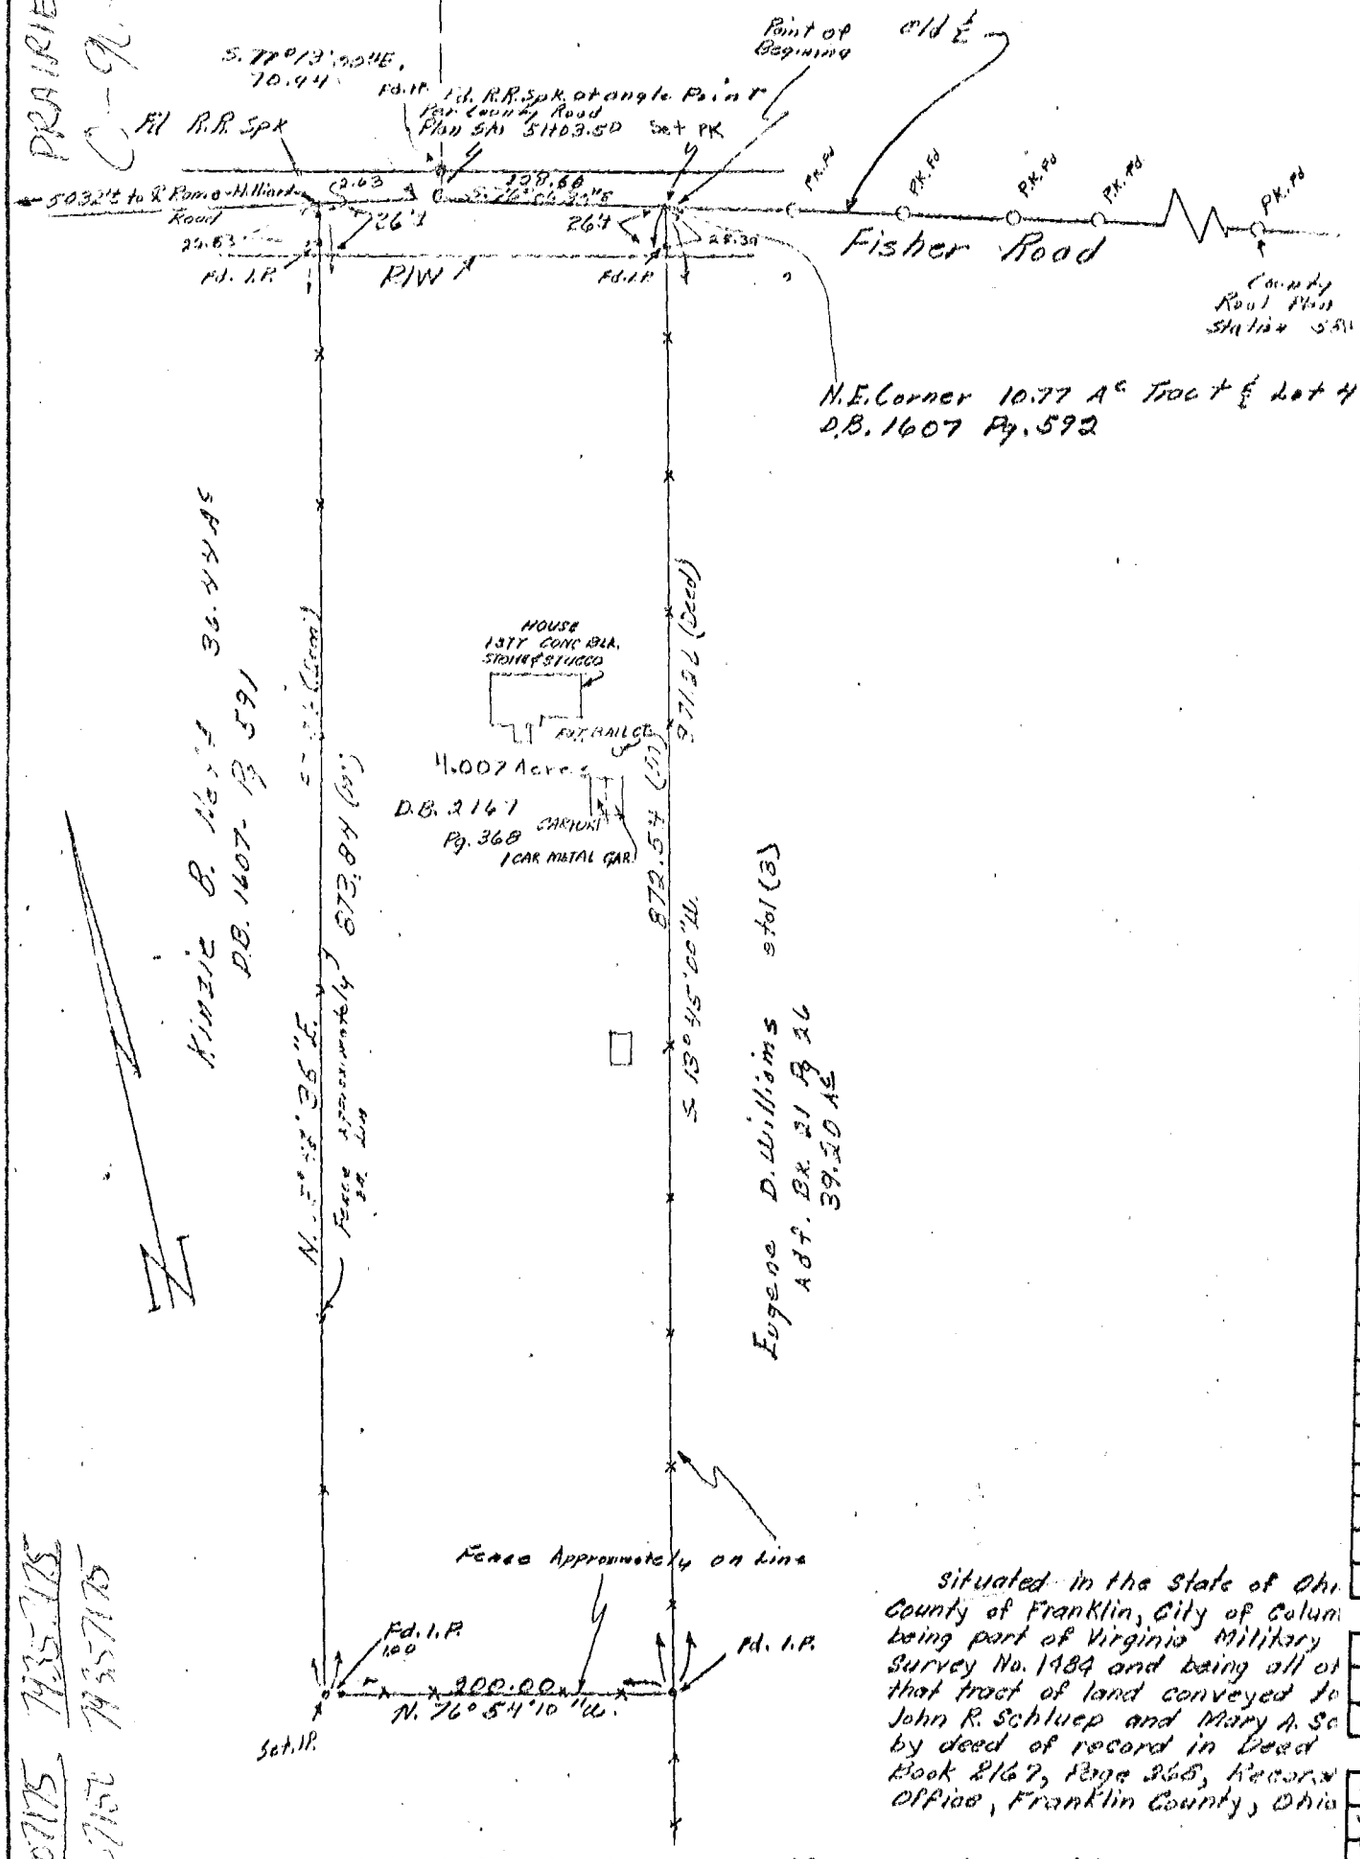

situated in the State of Ohio County of Franklin, City of Colum being part of Virginia Military Survey No. 1484 and being all of that tract of land conveyed to John R. Schluep and Mary A. Sc by deed of record in Deed Book 2167, Page 368, Recorde office, Franklin County, Ohio

We hereby certify that the foregoing plat was prepared from an actual survey of the premises.

SCALE 1" = 100'

DRW'D.	DRAWN	CHECKED
R.L.H.	R.L.H.	R.P.S.

DATE: 5-3-66	12300
REVISED DATES	ORDER NUMBERS

HOCKADEN-LIPES-ROUSCULP, INC.

By ..... Registered Surveyor