

NORTHLAND SURVEYING COMPANY

5209-86


ORDER NO.

614-895-1522

N-88

17910 7775
17910 7750

CERTIFIED TO CHRIS FREDRICSON COUNTY OF FRANKLIN
 LENDER BUCKEYE FEDERAL P.B. 28 PG. 46 D.B. _____ PG. _____
 SCALE 1: 50' DATE 3-31-87 BUYER FREDRICSON

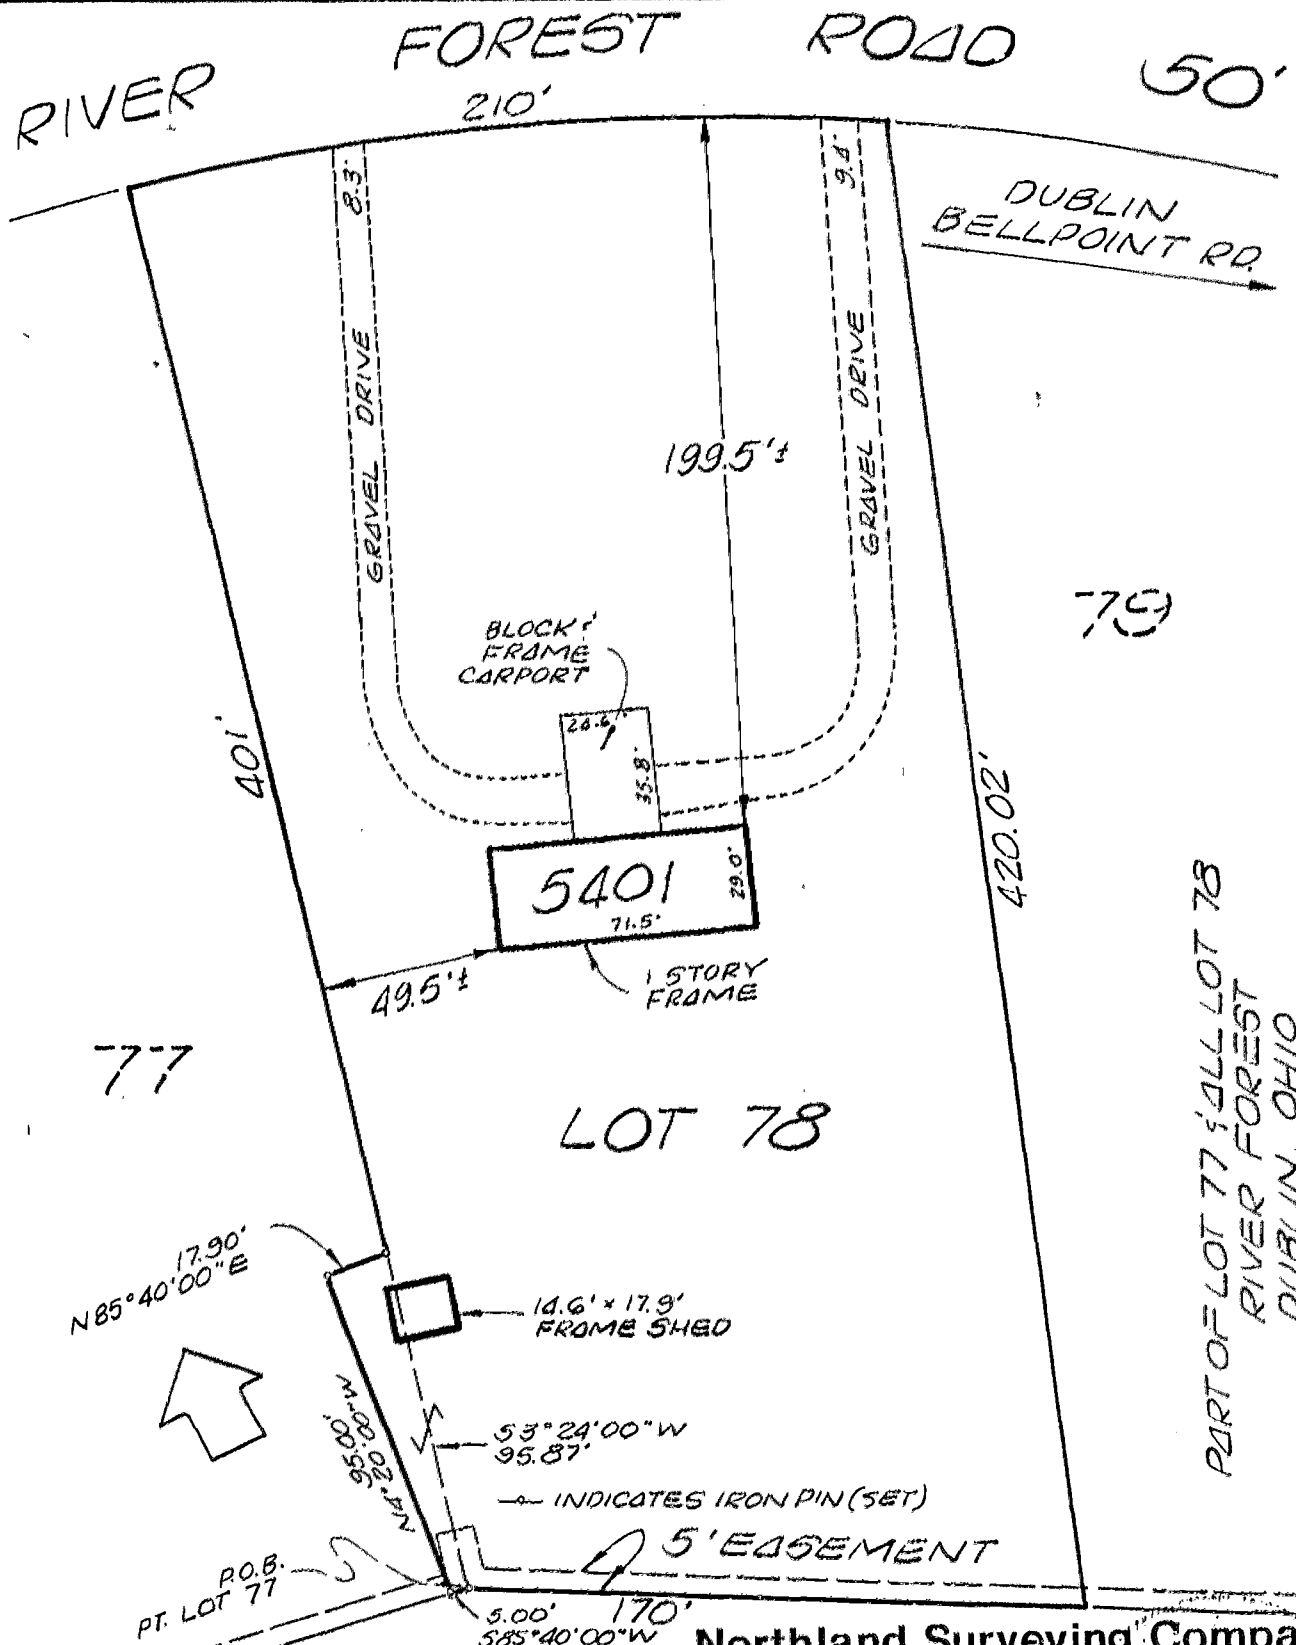

We hereby certify that the foregoing plat was prepared from an actual survey of the premises and correctly shows the location of the building or buildings including any drives. This plat is prepared for mortgage loan and title purposes only and is not to be construed as having been prepared for the owner or for the use of the owner for any purpose. Subject to all rights-of-way, easements and restrictions, if any, of previous record.

Northland Surveying Company

6040 CLEVELAND AVENUE
COLUMBUS OHIO 43229

BY Gary F. Orling
 REGISTERED SURVEYOR NO. _____

