


78107057

Donald S. & Margaret Worthington
5th

0-92-1
PRAIRIE TWP

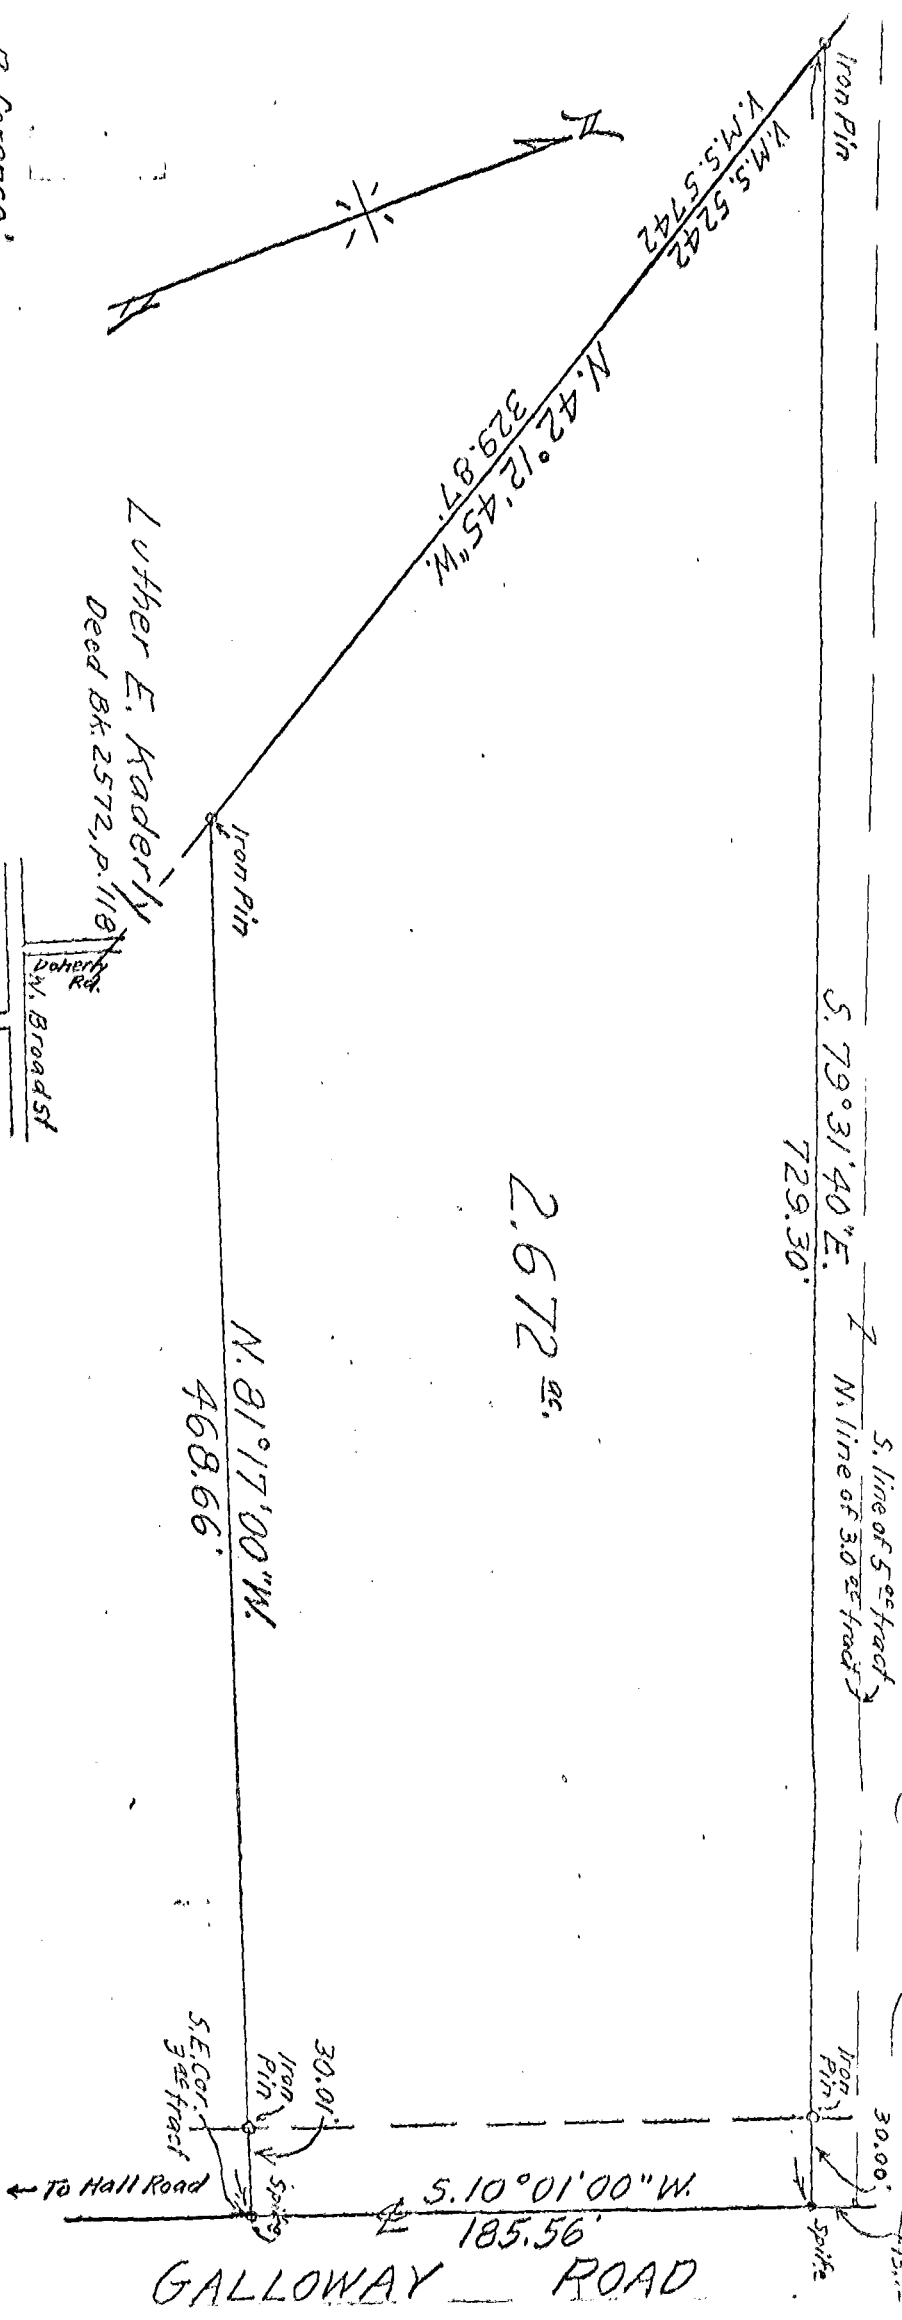

Reference:
 being part of a 3.0 acre tract (Tracts 5) of
 and as conveyed to Donald S. and
 Margaret Worthington as recorded in
 Deed Book 3225, page 680, Franklin
 County, Ohio records.

Luther E. Kaderly
 Deed Bk. 2572, P. 118

HARVEY & PROBRASCO,
 Registered Engineers & Surveyors

Area of
 Survey
 GALLOWAY ROAD
 (not to scale)

SURVEY OF 2.672^{ac} TRACT
 VIRGINIA MILITARY SURVEY NO. 5242
 PRAIRIE TWP. FRANKLIN COUNTY,
 Scale, 1" = 60'
 ~ Surveyed for ~
 MR. DONALD S. WORTHINGTON,
 MAR. 1973

J. K. Harney
 Registered Professional Surveyor #2570

1706 126 051 053 W GALLOWAY ROAD 1973 0925 003