

0-107-6

# CEA


## CIVIL ENGINEERING ASSOCIATES

1400  
West Fifth Avenue  
Columbus, Ohio 43212  
Tel 614.487.1888  
Fax 614.487.0964

### 0.107 ACRES

State of Ohio, County of Franklin, Township of Washington  
Virginia Military Survey 3010

for the centerline of Avery Road and  
all other bearings calculated from  
this meridian.

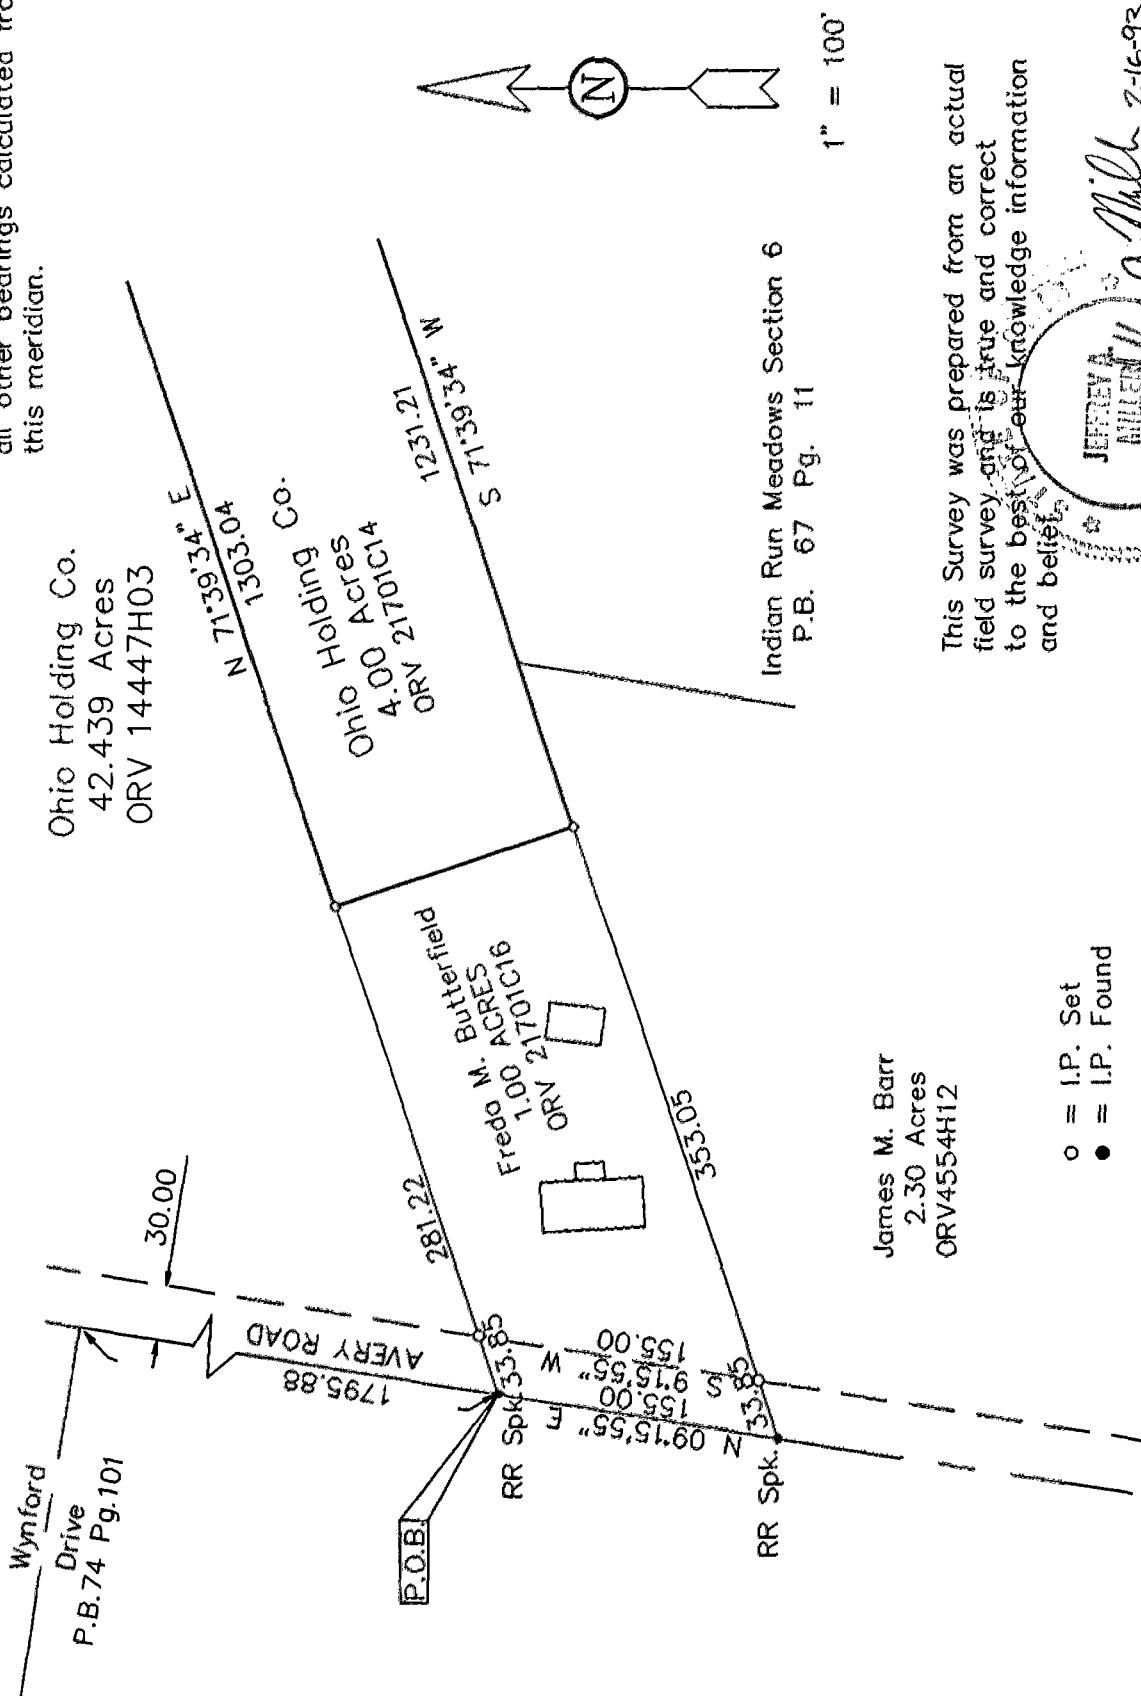

Indian Run Meadows Section 6  
P.B. 67 Pg. 11

This Survey was prepared from an actual  
field survey and is true and correct  
to the best of our knowledge information  
and belief.

