


JERRY A. MALOTT SURVEYING Co.

6810 East Main Street ~ Suite 101, Columbus, Ohio 43068 (614) 577-0957

FOR: **David Henson**

BOUNDARY SURVEY

1994/AUGUST/11648

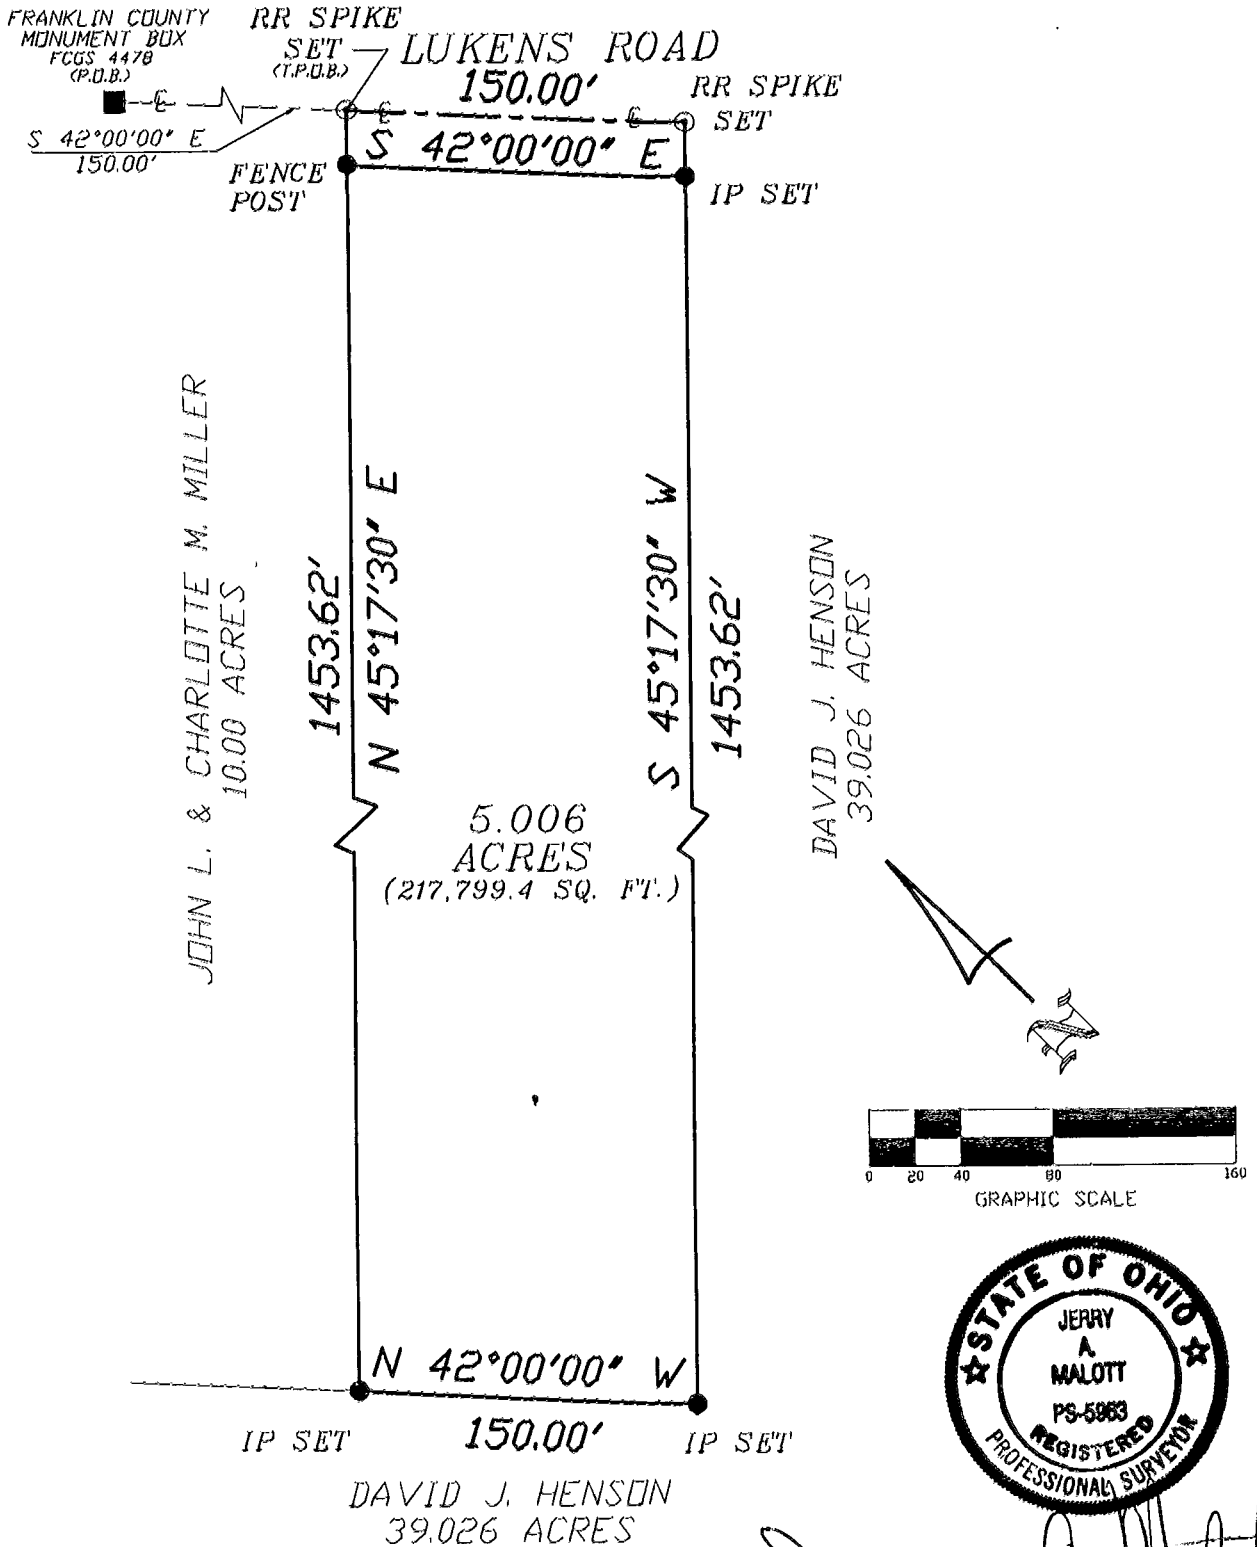

BY Jerry A. Malott
Professional Surveyor
JERRY A. MALOTT

SCALE 1" = 80' DATE 08/25

LOCATION State of Ohio, County of Franklin, Township of Pleasant and being in V.M.S. 6309-6582, D.R. 18494 Pg. D17

C-82-E