



LEGEND

- 1/2" PIPE (FOUND)
- 4" DIA. IRON FENCE POST FILLED WITH CONCRETE FOUND
- RAILROAD SPIKE
- ⬡ 5/8" DIA. REBAR & YELLOW PLASTIC CAP STAMPED "COTTRILL 6858" (SET)

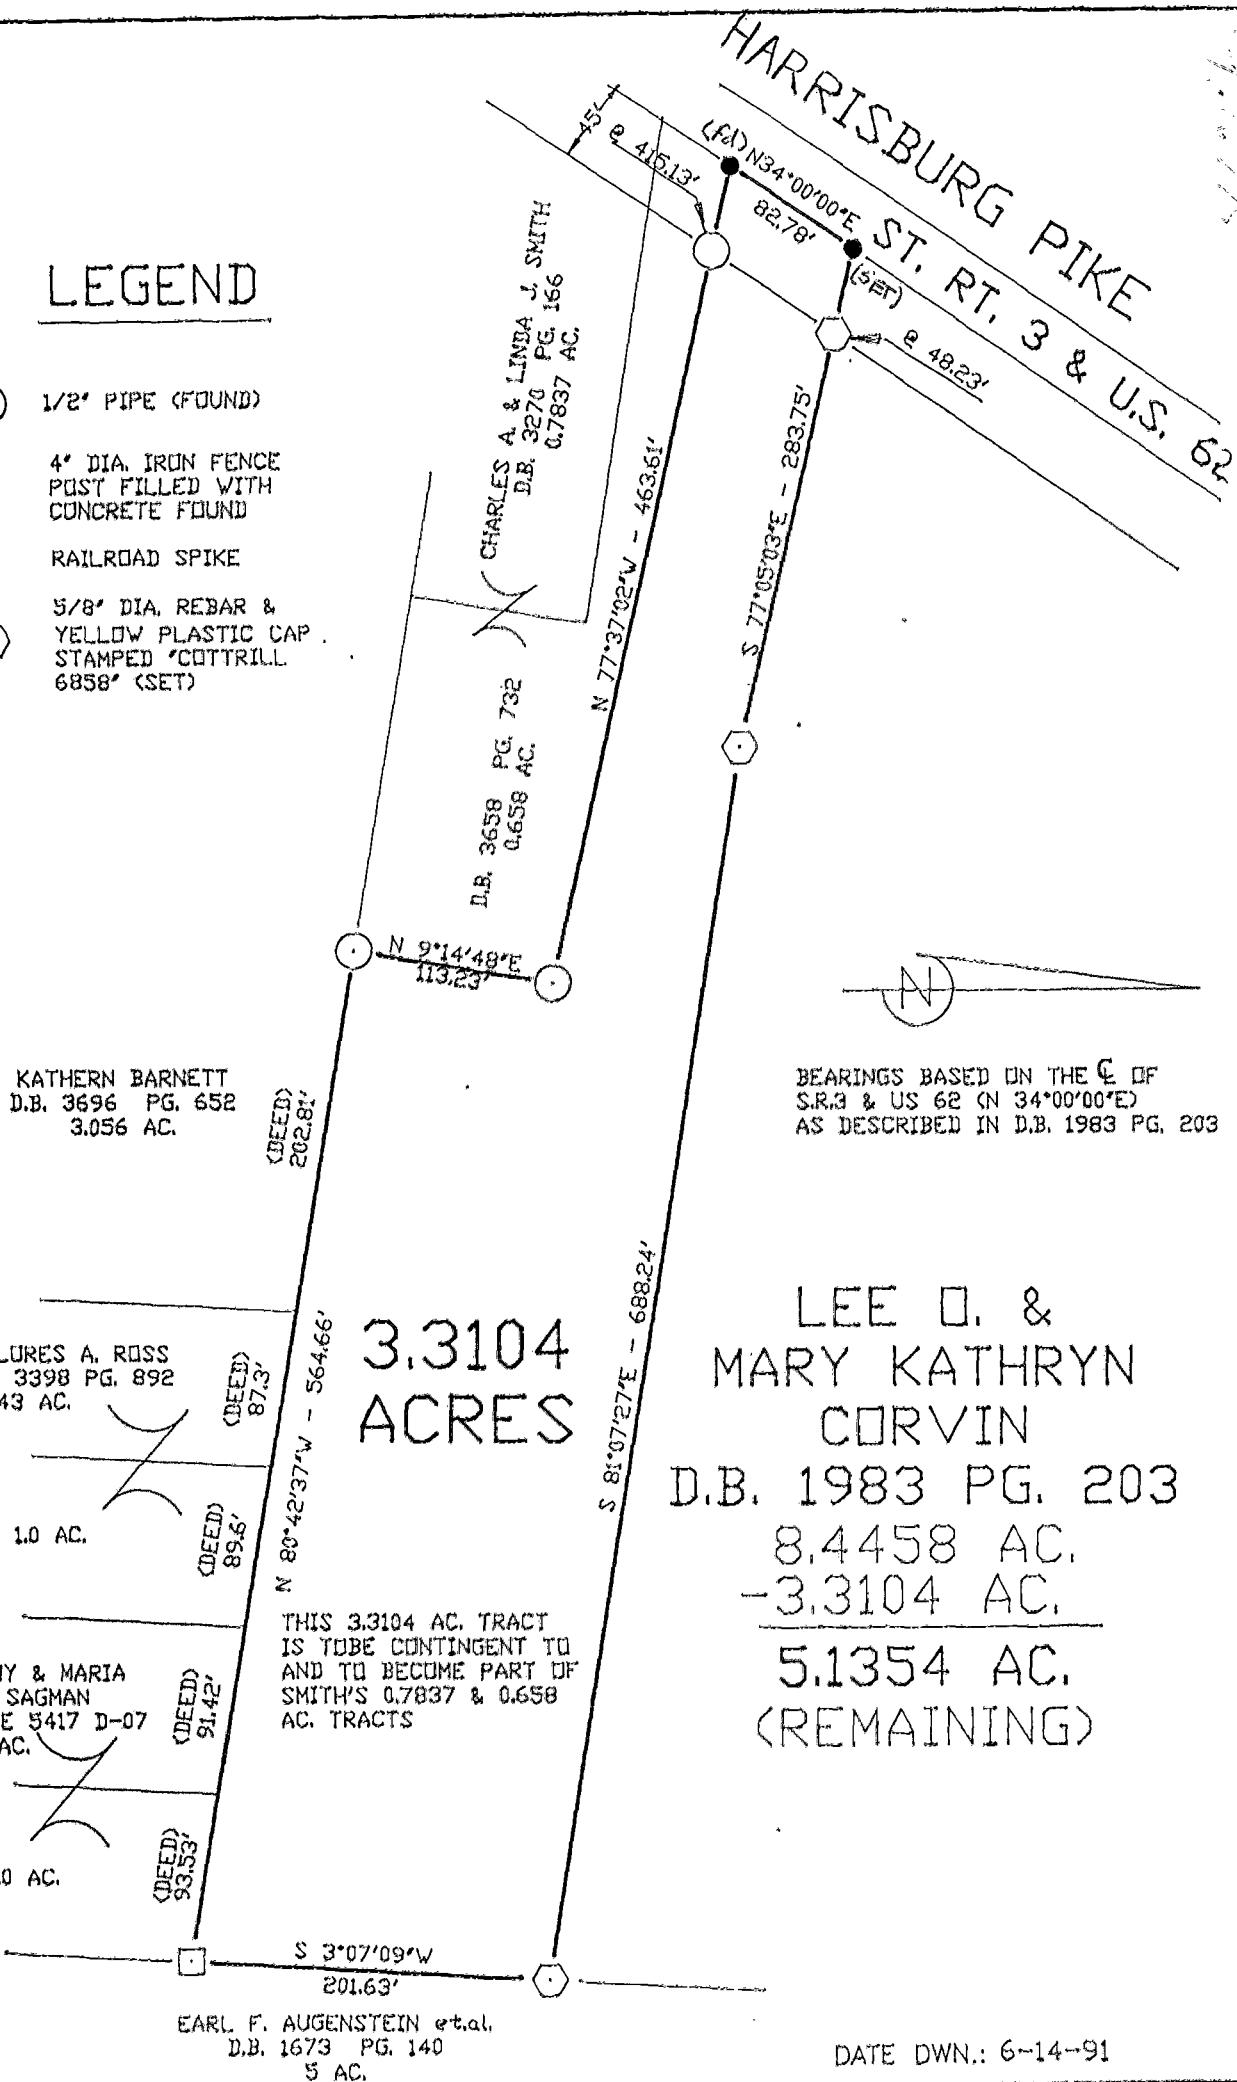

PLAT OF:
3.3104 ACRES, VMS 1383, JACKSON TWN.,
FRANKLIN COUNTY, OHIO

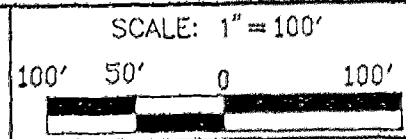

JAMES R. COTTRILL P.S.
8256 S.R. 207 N.E. MT. STERLING, OHIO 43143
PH. (614) 869-3811

I HEREBY CERTIFY THIS PLAT DEPICTS AN ACTUAL FIELD SURVEY PERFORMED BY JAMES R. COTTRILL P.S. #6858.

James R. Cottrill 6-19-91
DATE

D-33-A