PROPERTY SURVEY FOR H. L. McKINLEY

SITUATED IN THE STATE OF OHIO, COUNTY OF FRANKLIN. TOWNSHIP OF PLEASANT, AND BEING PART OF V.M.S. NO. 1467, AND ALSO BEING PART OF A 101.63 ACRE TRACT BELONGING TO HUGH L. McKINLEY, SAID 101.63 ACRE TRACT BEING PARCEL № 2 AS RECORDED IN DEED BOOK 1716, PAGE 529, RECORDERS OFFICE, FRANKLIN COUNTY, OHIO.

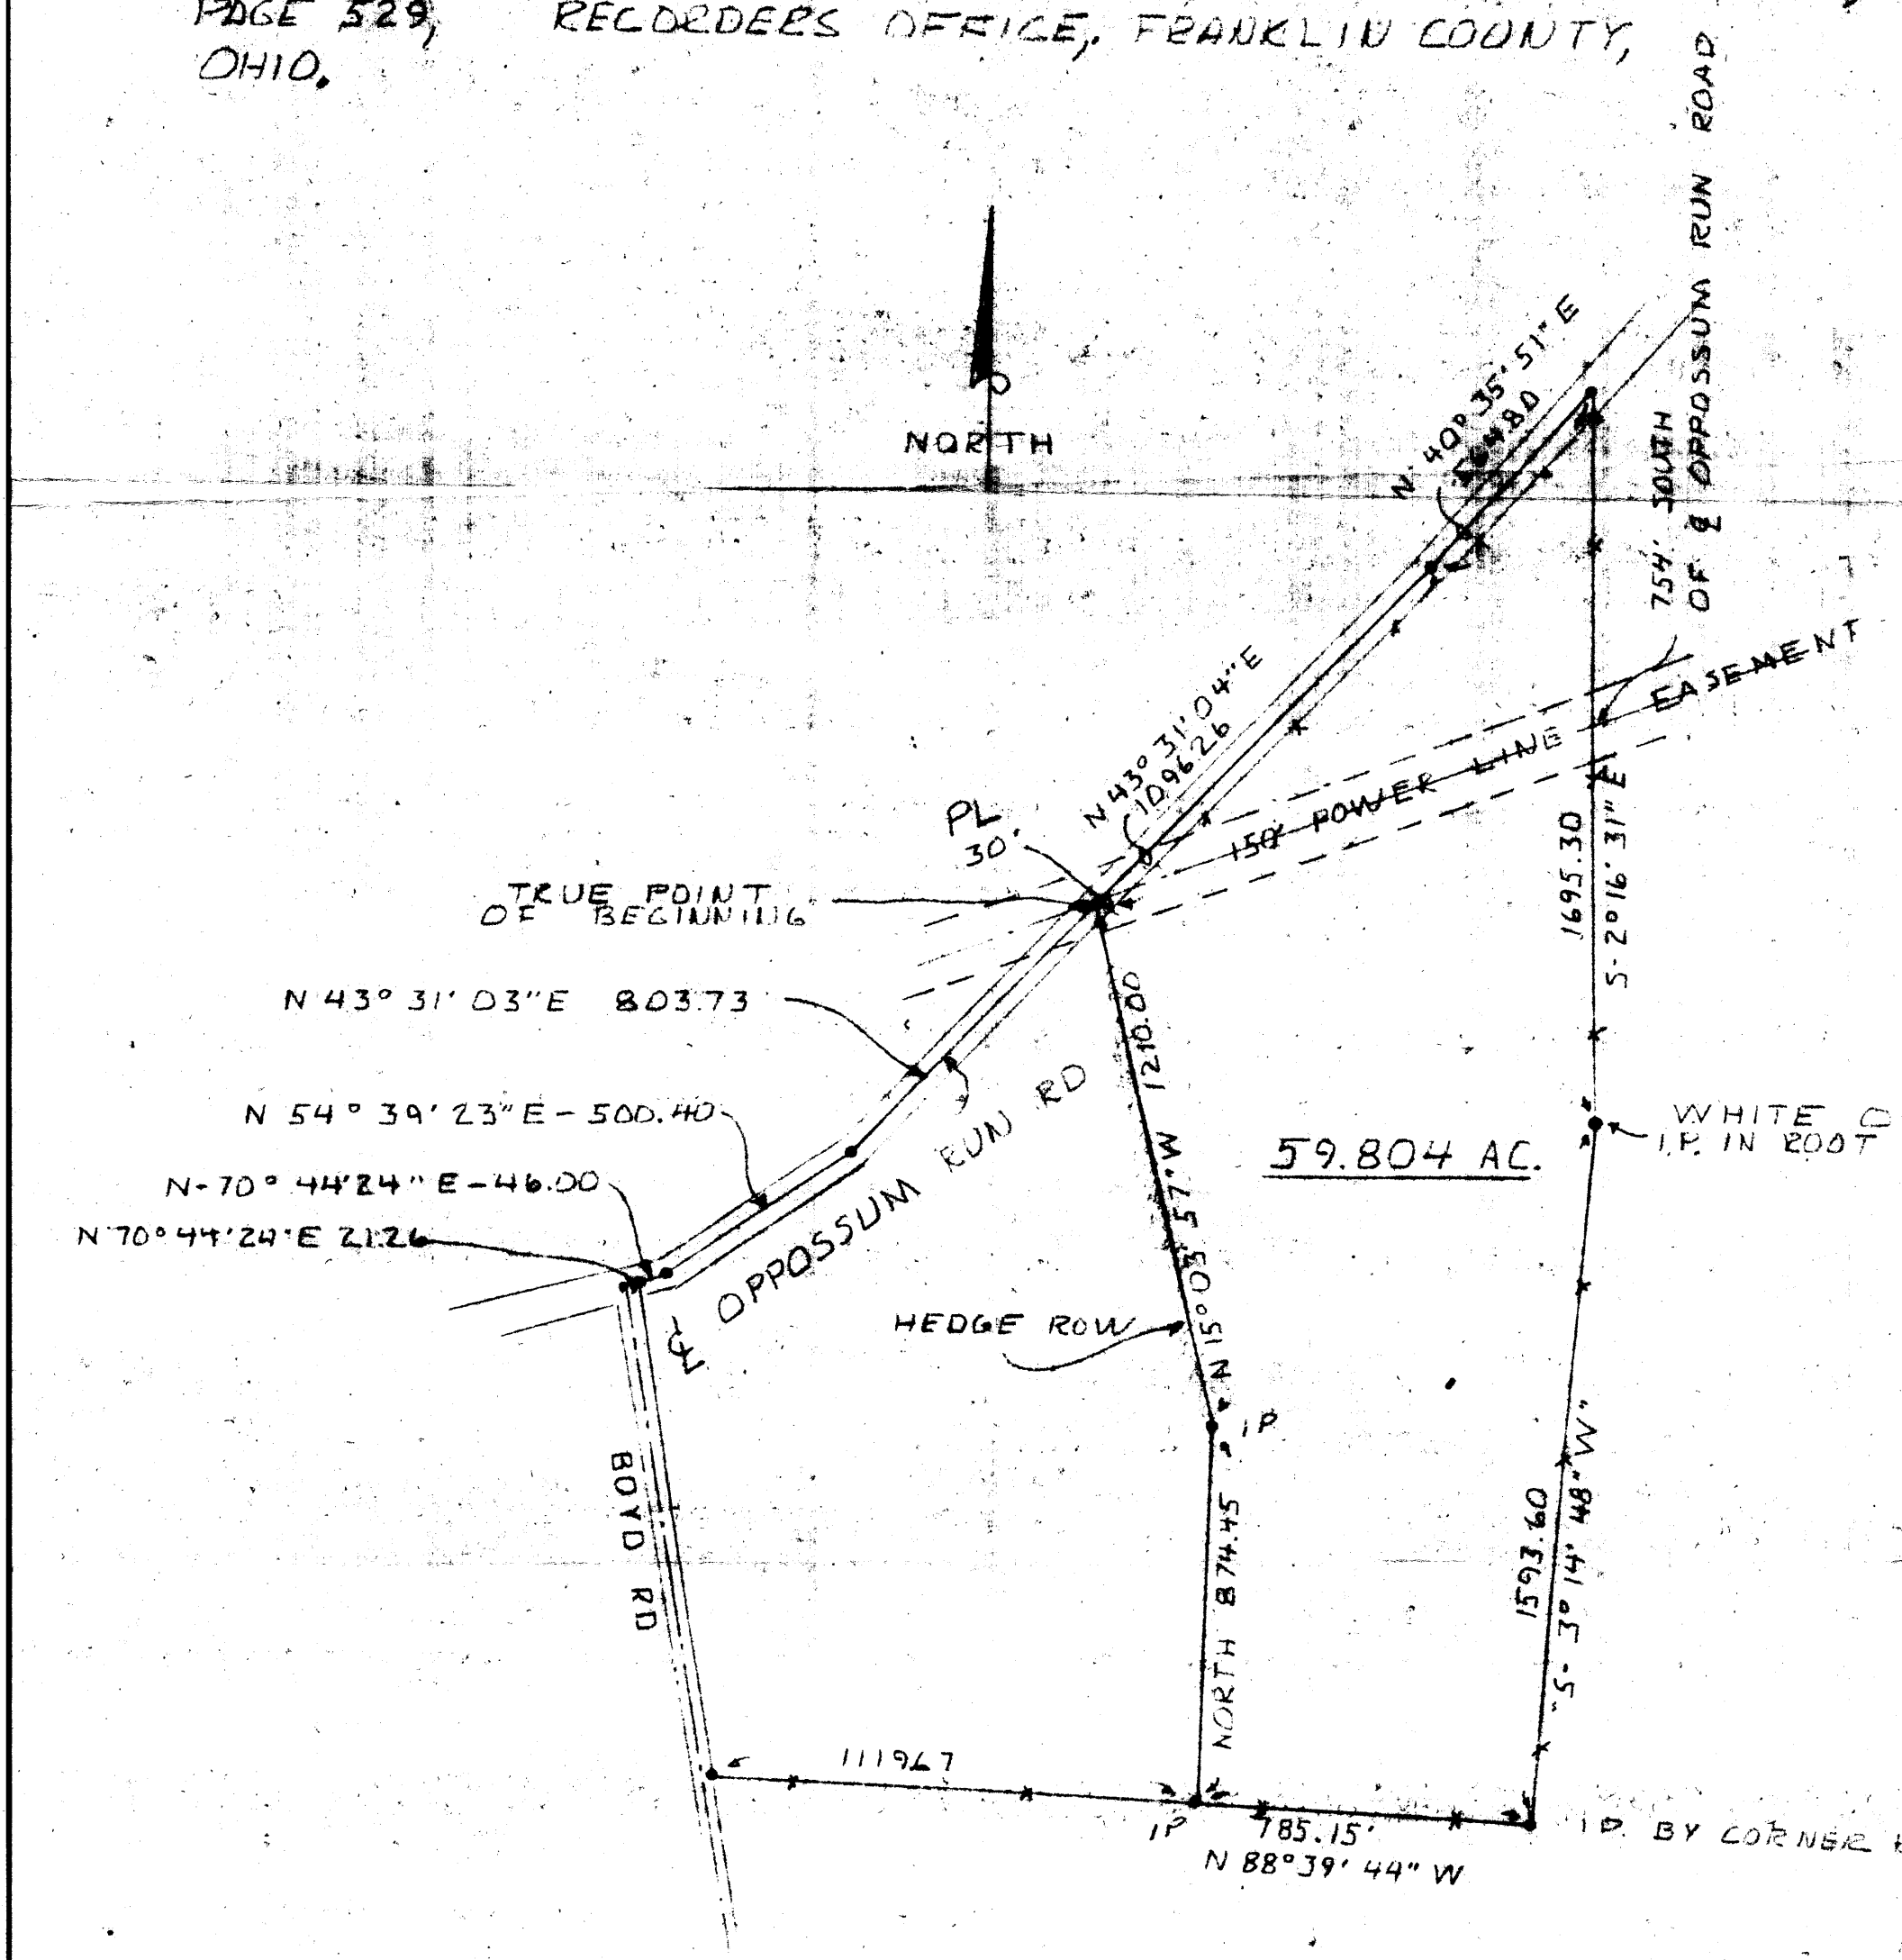

SCALE 1" = 400'

• IRON PINS

THIS PLAT WAS PREPARED FROM A ACTUAL FIELD SURVEY MADE BY PAUL K MOORE & ASSOC. ON OCT 15' 1976.

Paul K Moore

PAUL K. MOORE REG. SURVEYOR № 5883

