
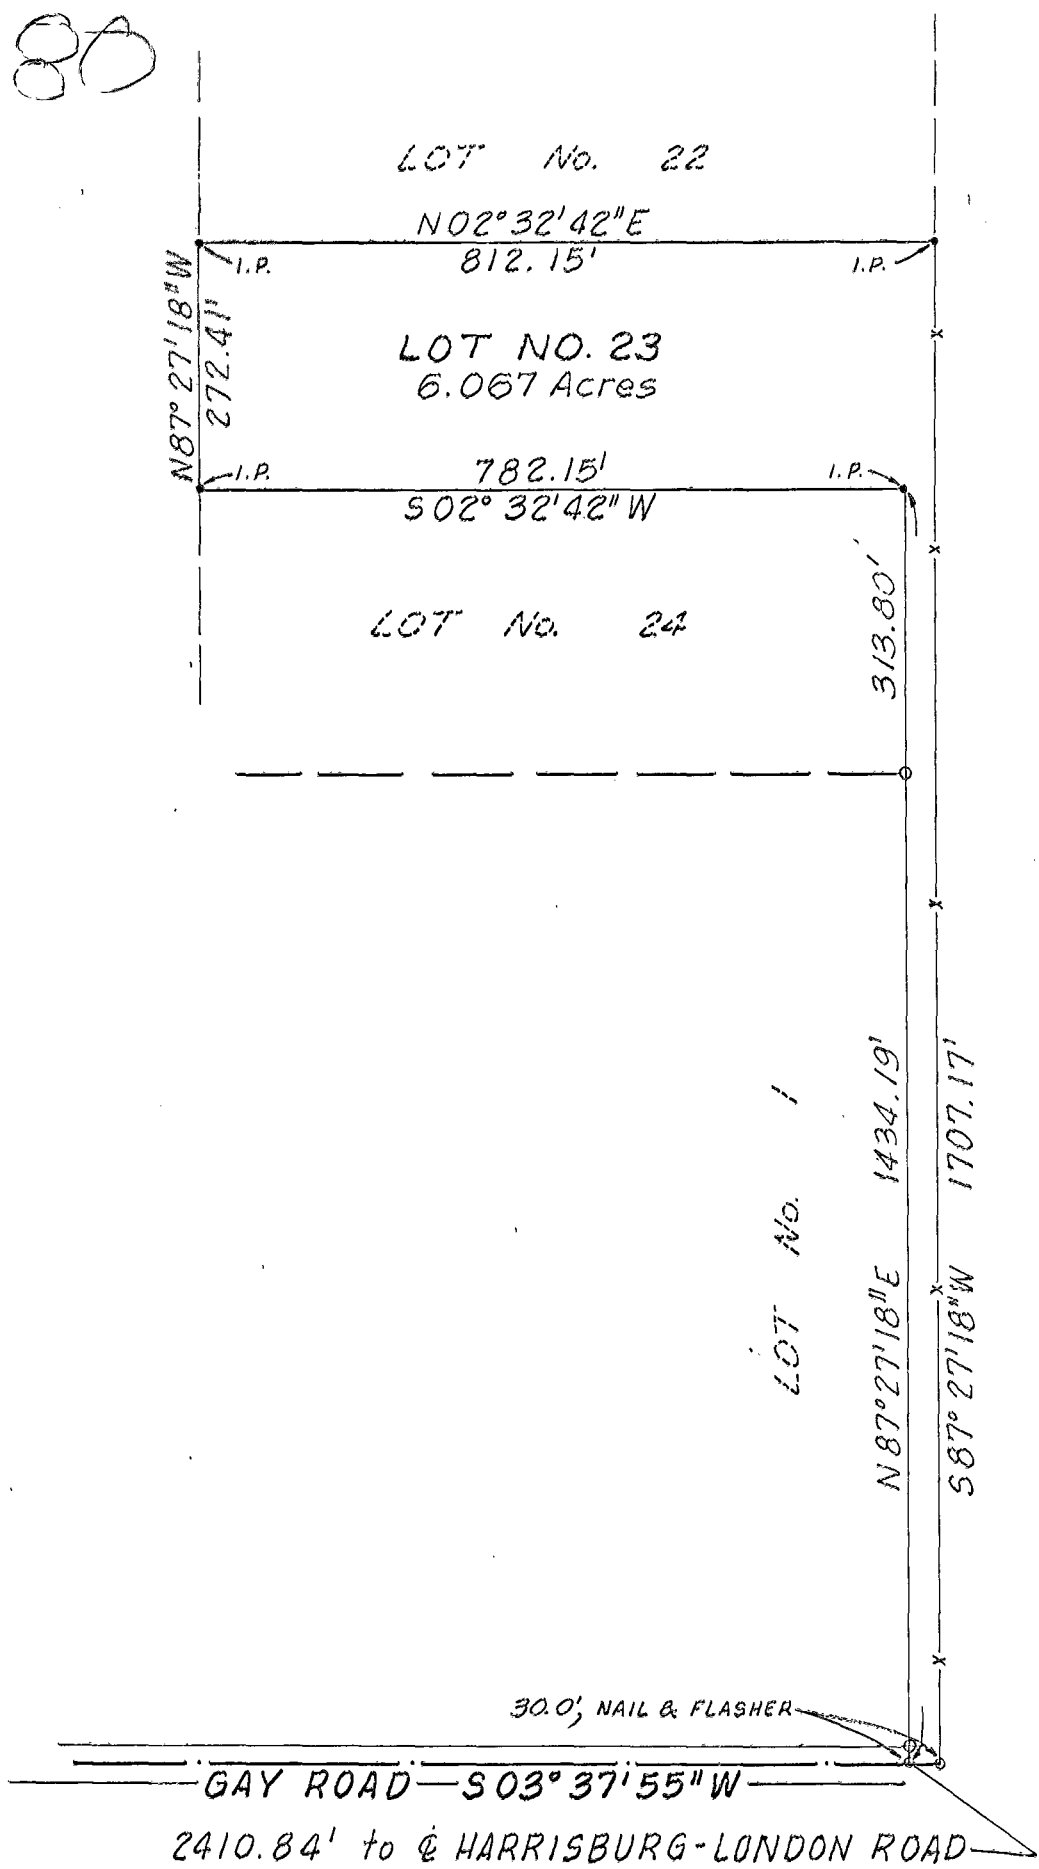


2030
 120
 032 083 5
 GAY W B O P O
 1000
 0800
 1003

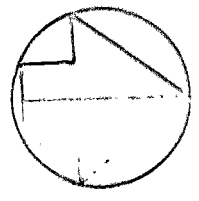

WE HEREBY CERTIFY THAT THE FOREGOING DRAWING WAS PREPARED FROM AN ACTUAL SURVEY OF THE PREMISES AND CORRECTLY SHOWS THE LOCATION OF THE BOUNDRIES.

BY: *Stanley J. ...*
 Registered Surveyor No. 4924

Scale 1" = 200

UNO CONSULTANTS, INC.
 ENGINEERING & SURVEYING
 1706 E. Broad Street Columbus 03, Ohio