
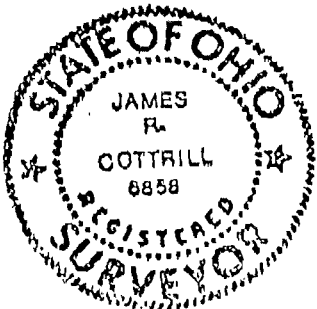
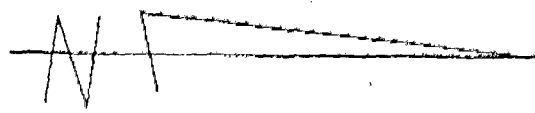


# MORTGAGE LOAN INSPECTION

035-F  
JACKSON TWP

SELLER: N/A  
 BUYER: Charles Edward and Susan Marie Bowles  
 MORTGAGE CO.: Society Bank  
 THIS PLAT MADE FOR & AT THE INSTANCE OF:  
 Society Bank and Chicago Title Ins. Co.

RECORD: O.B.15792PG. B04 ; P.B. PG.  
 CITY, VILLAGE, OR TOWNSHIP: Jackson Twp.  
 COUNTY & STATE: Franklin Co., Ohio  
 THIS PROPERTY IS NOT IN A FLOOD PLAIN.  
 M920701  
 7533 Seeds Rd. Orient, Ohio  
 3.6945 Acre tract (new survey dated 6-30-

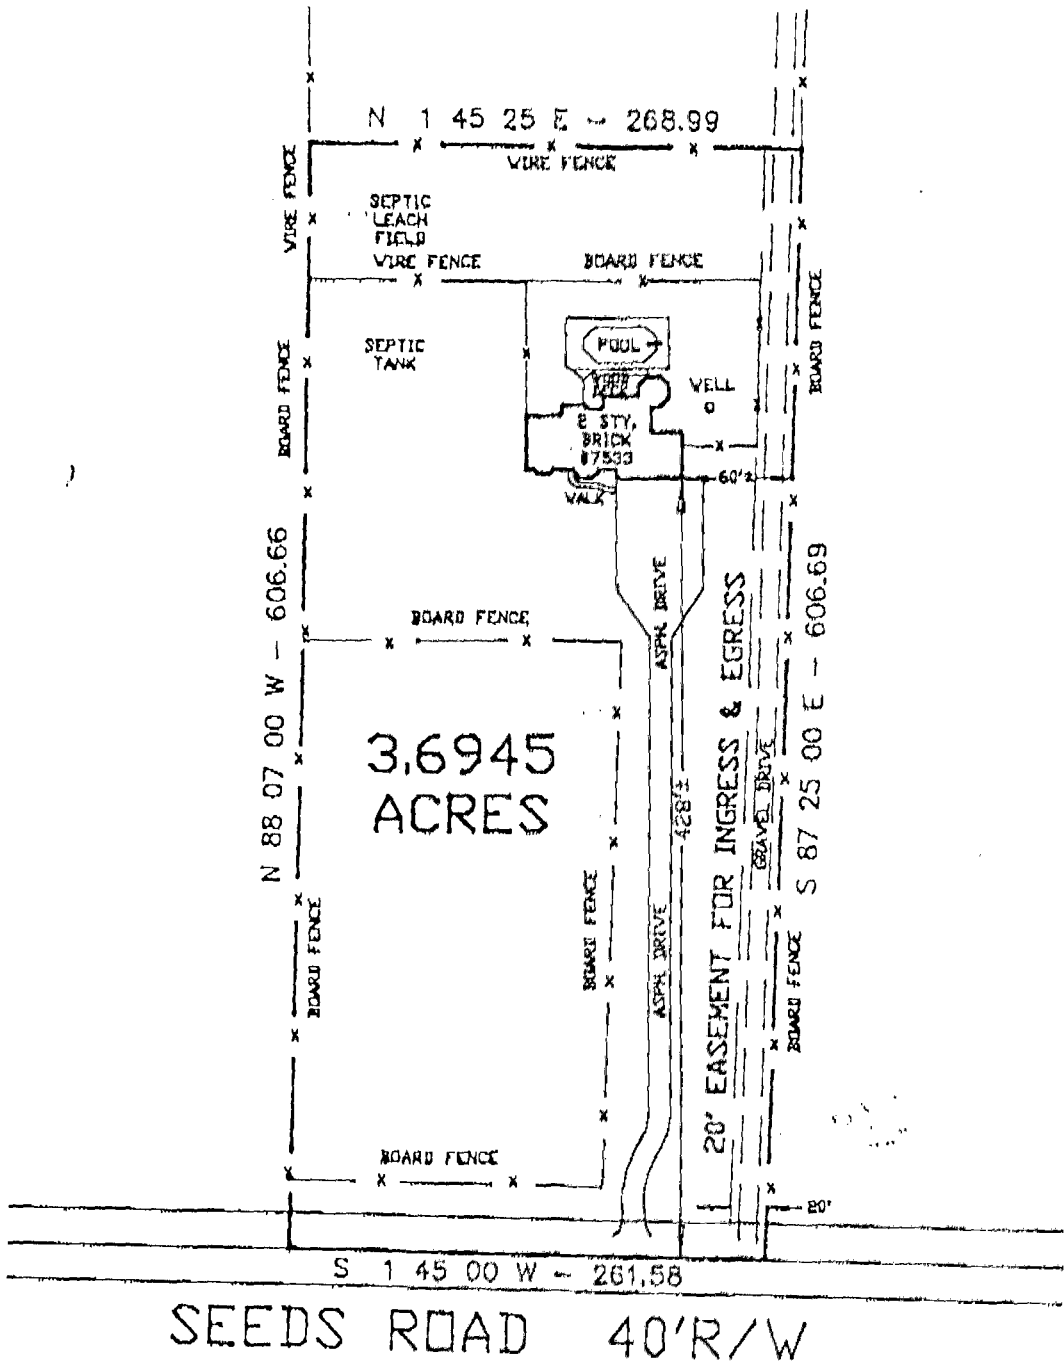

SCALE: 1" = 100'

JAMES R. COTTRILL P.S.  
 8256 S.R. 207 N.E. MT. STERLING, OHIO 43143

I hereby verify that this identification plat shows the improvements as located on the premises described, that the improvements are within the lot lines, and that there are no encroachments upon the premises by adjoining premises, except as shown for MORTGAGE LOAN & TITLE INSURANCE PURPOSES ONLY. This survey is a MORTGAGE LOCATION SURVEY prepared in accordance with Chapter 4733-28 of the Administrative Code, and is not a boundary survey pursuant to Chapter 4733-27 of the Administrative Code. No responsibility is intended to the land owner or occupant.

7960600  
79056600